





URLING NO. 1 MINE LOWER FREEPORT 'D' SEAM  
 KEYSTONE COAL MINING CORP.  
 INDIANA CO.

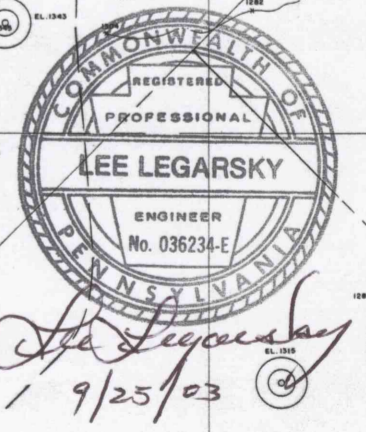

**FINAL MINE MAP**

**POSTED**  
 NOV 30 1999

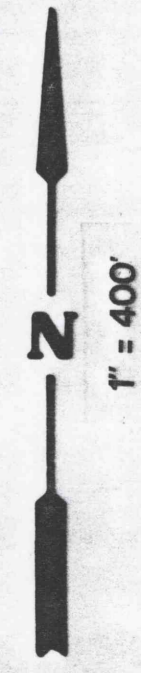

MATCH TO 20