




MATCH TO 6



FINAL MINE MAP  
 POSTED  
 NOV 30 1929

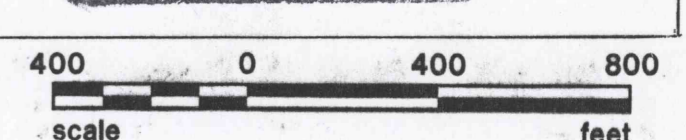

URLING NO. 1 MINE LOWER FREEPORT 'D' SEAM  
 KEYSTONE COAL MINING CORP.  
 INDIANA CO.

