




MATCH TO 8

POSTED
NOV 30 1929

FINAL MINE MAP

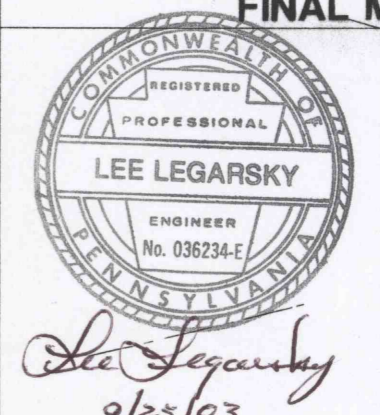

1"=400'
scale
400 0 400 800
feet

URLING NO. 3 MINE LOWER FREEPORT 'D' SEAM
KEYSTONE COAL MINING CORP.
INDIANA CO.



DMSU 4535