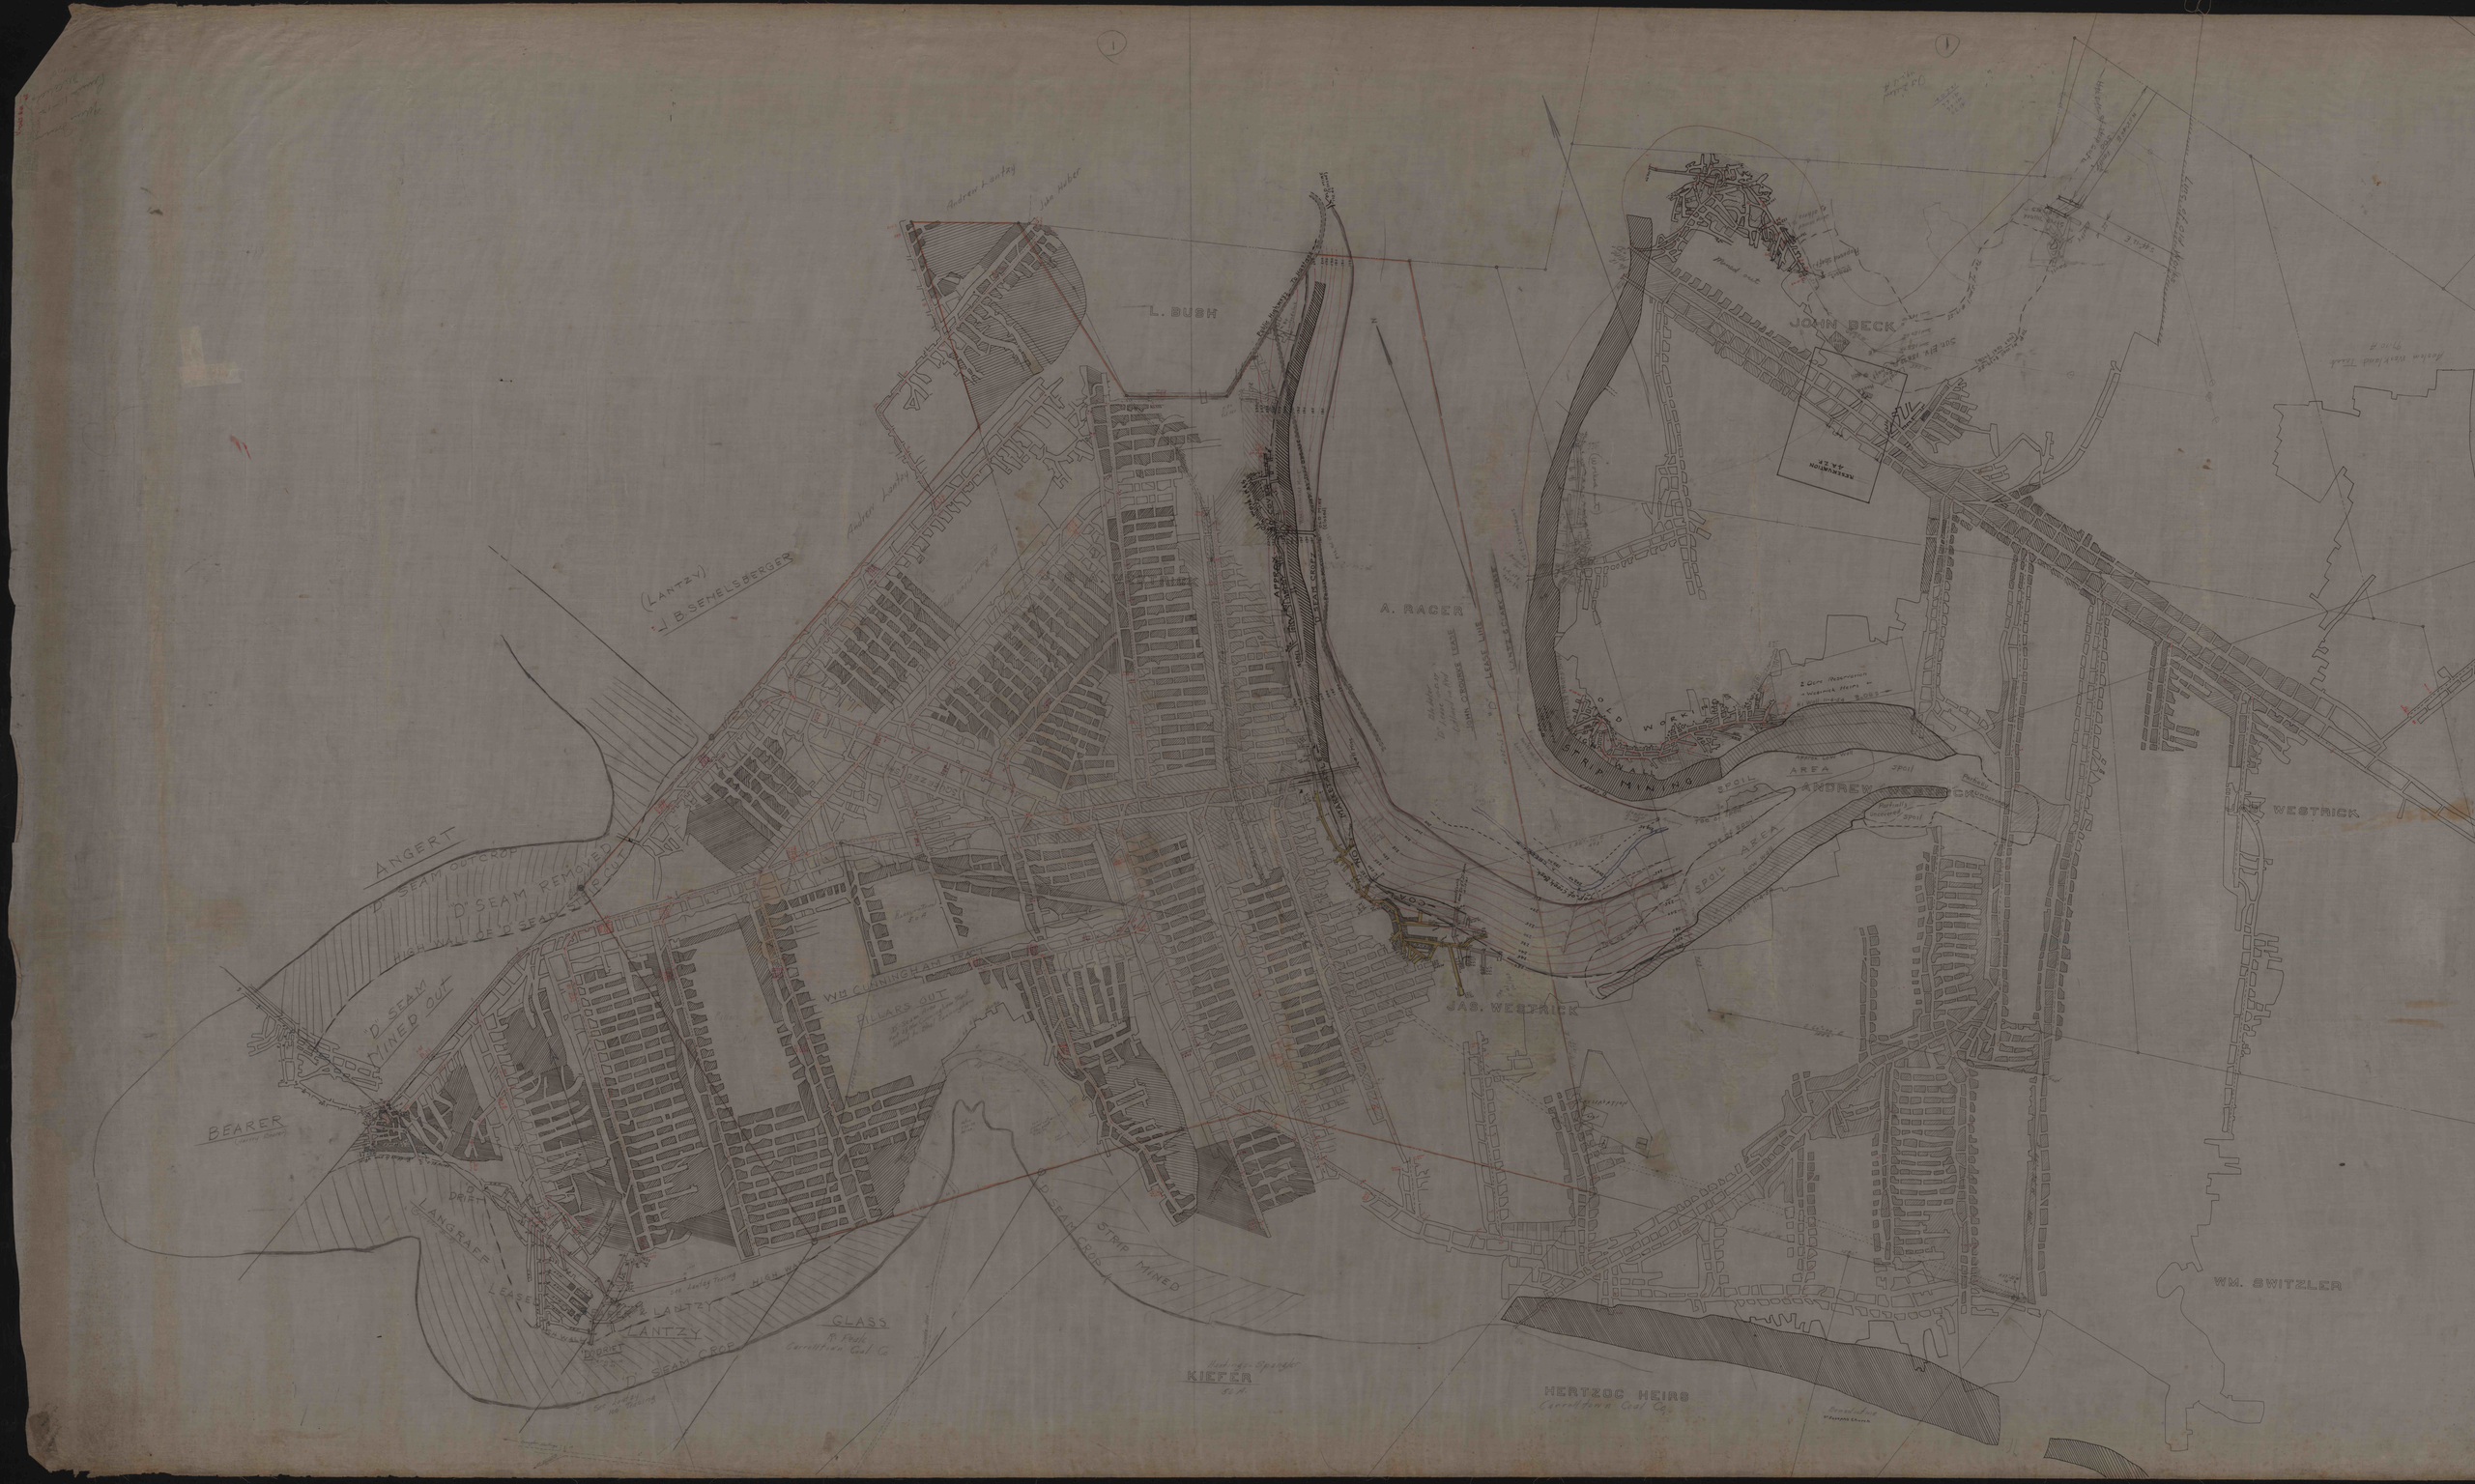
L. BUSH
(LANTZY)
J.B. SEHELSBERGER
A. RACER
JOHN BECK
ANGERT
D SEAM OUTCROP
D SEAM REMOVED
D SEAM CUT
D SEAM MINED OUT
PILLARS OUT
WM CUNNINGHAM
JAS. WESTRICK
WESTRICK
BEARER
ANGRAFF
LEASE
LANTZY
GLASS
KIEFER
D SEAM CROP
STRIP MINED
HERTZOG HEIRS
Carrolltown Coal Co.
WM. SWITZLER
ANDREW CR.
SPOIL AREA
OLD WORKINGS
42 YD NORTHINGTON