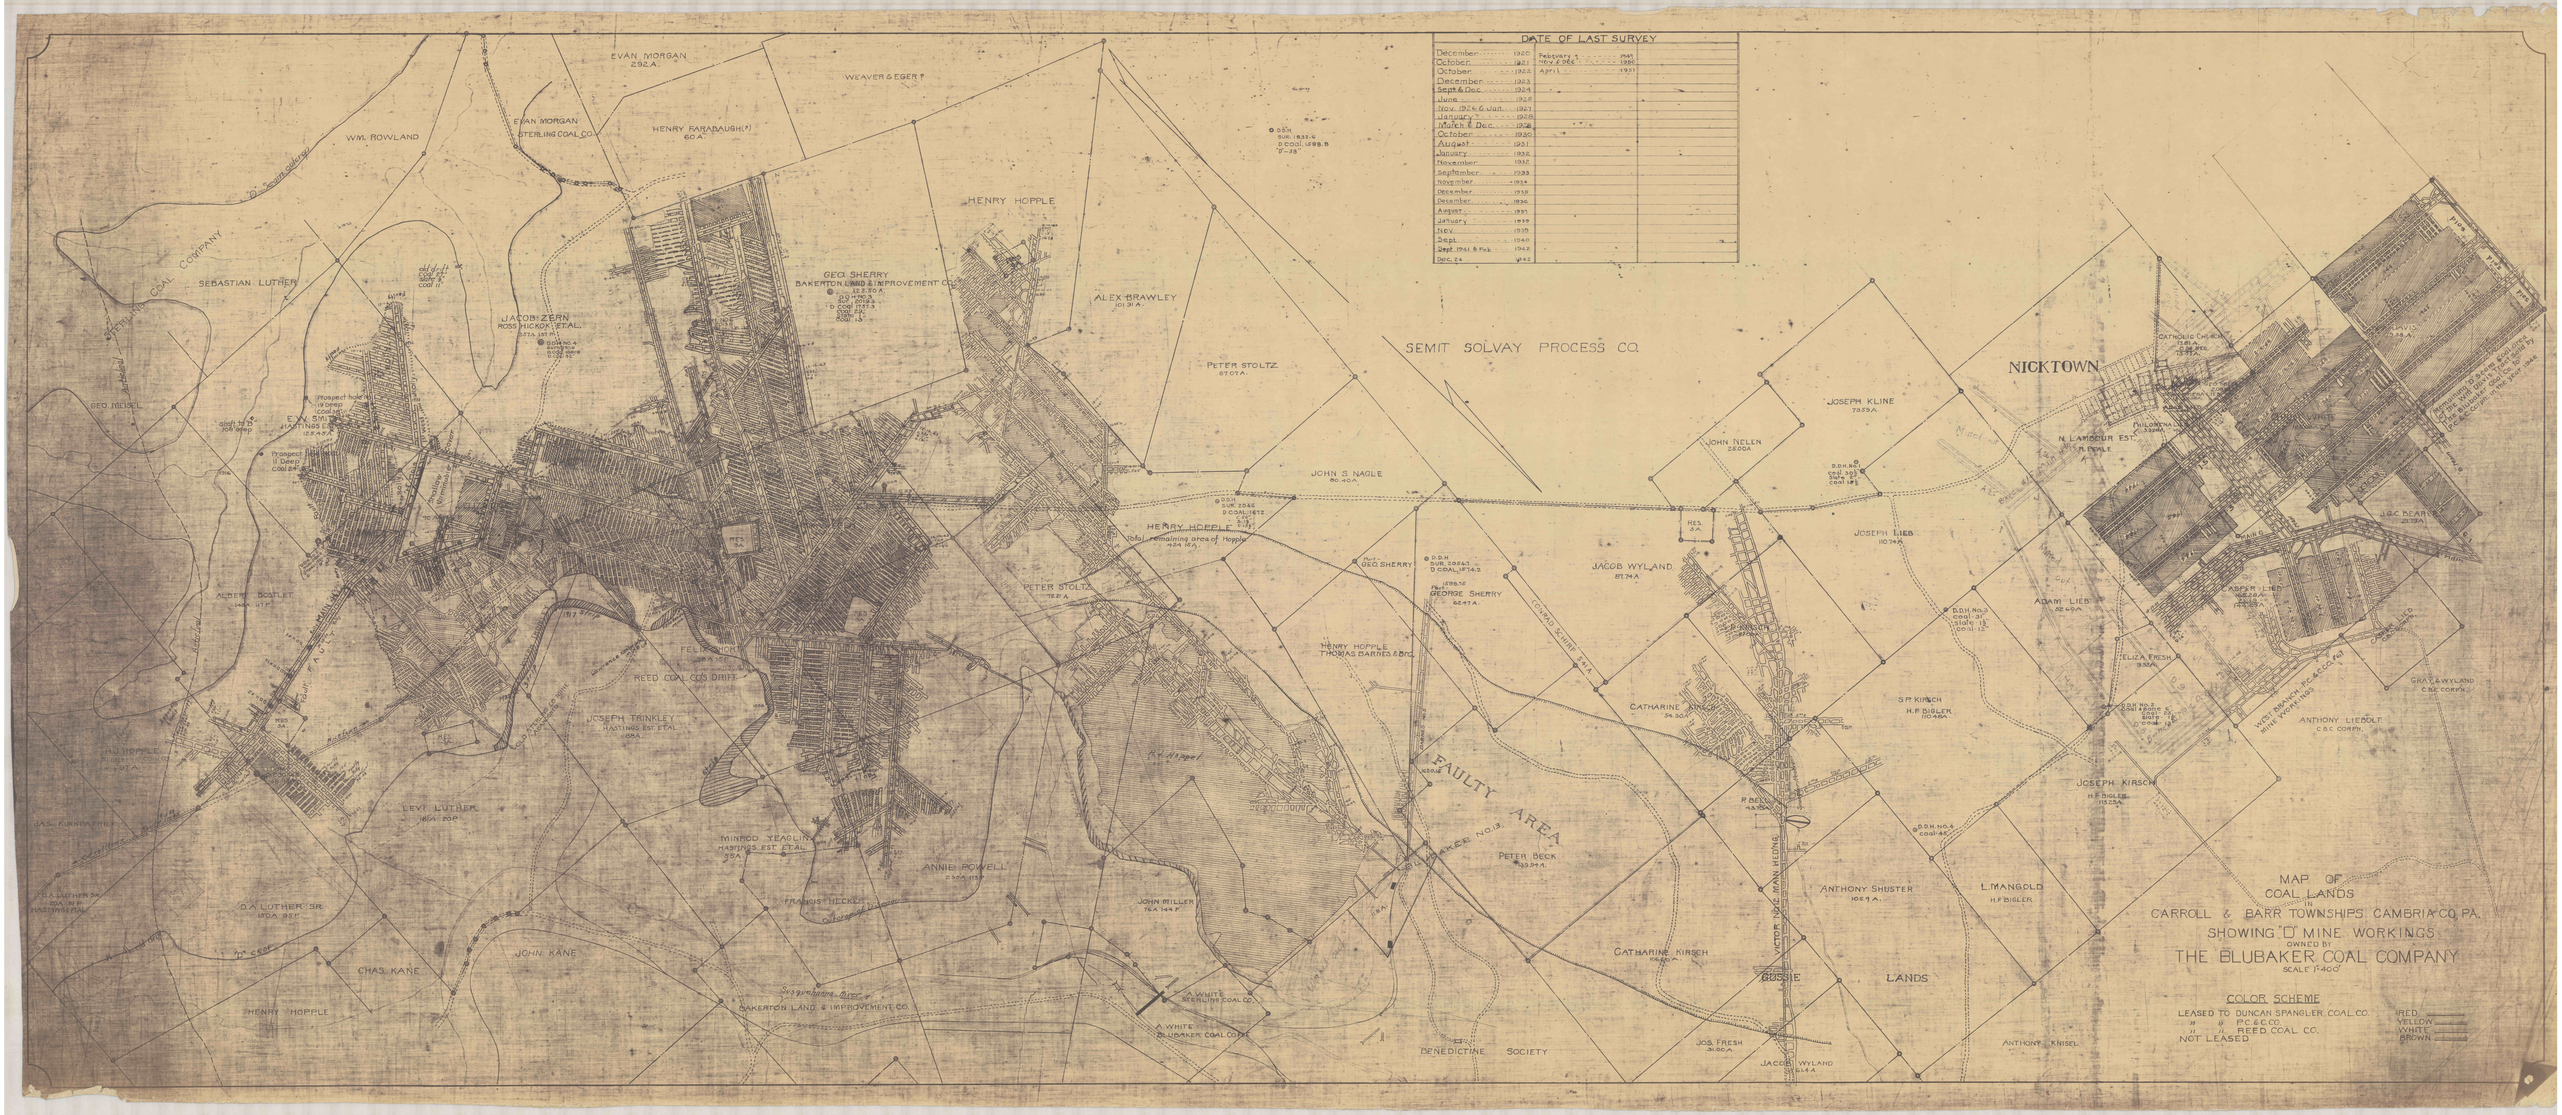
DATE OF LAST SURVEY
December 1920
October 1921
October 1922
December 1923
Sept & Dec. 1925
June 1928
Nov. 1924 & Jun 1927
January 1928
March & Dec. 1928
October 1930
August 1931
January 1932
November 1937
September 1933
November 1934
December 1939
December 1936
August 1931
January 1939
Nov. 1938
Sept. 1940
Sept. 1941 & Feb. 1942
Dec. 24 1942
February 4 1945
Nov. & Dec. 1946
April 1931
EVAN MORGAN 292 A.
WEAVER & EGER ?
EVAN MORGAN
STERLING COAL CO.
HENRY FARABAUGH(?) 60 A.
WM. ROWLAND
HENRY HOPPLE
GEO. SHERRY
BAKERTON LAND & IMPROVEMENT CO.
ALEX BRAWLEY
PETER STOLTZ
SEMIT SOLVAY PROCESS CO.
NICKTOWN
SEBASTIAN LUTHER
JACOB ZERN
GEO. MEISEL
JOHN S. NAGLE
HENRY HOPPLE
JOHN NELEN
JOSEPH KLINE
JOSEPH LIEB
JACOB WYLAND
ALBERT SCOTLET
PETER STOLTZ
REED COAL CO'S DRIFT
JOSEPH TRINKLEY
HASTINGS EST. ET AL.
LEVI LUTHER
MINROD YEARLING
HASTINGS EST. ET AL.
ANNIE POWELL
FRANCIS HECKEL
JOHN MILLER
JOHN KANE
CHAS. KANE
HENRY HOPPLE
D. A. LUTHER SR.
JAS. KIRKWOOD
HENRY HOPPLE THOMAS BARNES & BRO.
GEORGE SHERRY
FAULTY AREA
PETER BECK
CATHARINE KIRSCH
CATHARINE KIRSCH
ANTHONY SHUSTER
L. MANGOLD
S. P. KIRSCH
H. F. BIGLER
JOSEPH KIRSCH
ADAM LIEB
ELIZA FRESH
ASPER LIEB
ANTHONY LIEBOLT
GRAY & WYLAND
N. LANDOUR EST.
CATHOLIC CHURCH
DAVID
BENEDICTINE SOCIETY
JOS. FRESH
JACOB WYLAND
ANTHONY KNISEL
VICTOR NO. 2 MAIN HEADING
BLUBAKER NO. 3
A. WHITE
BLUBAKER COAL CO.
BAKERTON LAND & IMPROVEMENT CO.
Susquehanna River
MAP OF
COAL LANDS
IN
CARROLL & BARR TOWNSHIPS, CAMBRIA CO. PA.
SHOWING "D" MINE WORKINGS
OWNED BY
THE BLUBAKER COAL COMPANY
SCALE 1"=400'
COLOR SCHEME
LEASED TO DUNCAN SPANGLER COAL CO. RED
" " P.C.&C.CO. YELLOW
" " REED COAL CO. WHITE
NOT LEASED BROWN