

CHERRYTREE COAL CO.

CHERRYTREE COAL CO.

BARNES & TUCKER COAL CO.

BARNES & TUCKER COAL CO.


DUNCAN & SPANGLER COAL CO.

RICH HILL COAL CO.

HILL COAL CO.

EXHIBIT "C"
SHOWING MINE WORKINGS
OF PORTER RUN COAL CO.
D SEAM

MINED TO JAN 1924. (1919-20-21-22-23)

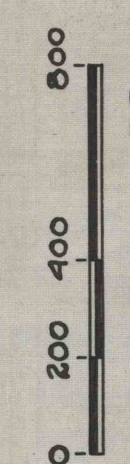

FEB. 1922.

CHAS. E. SCHLICHER ENGR.

74T