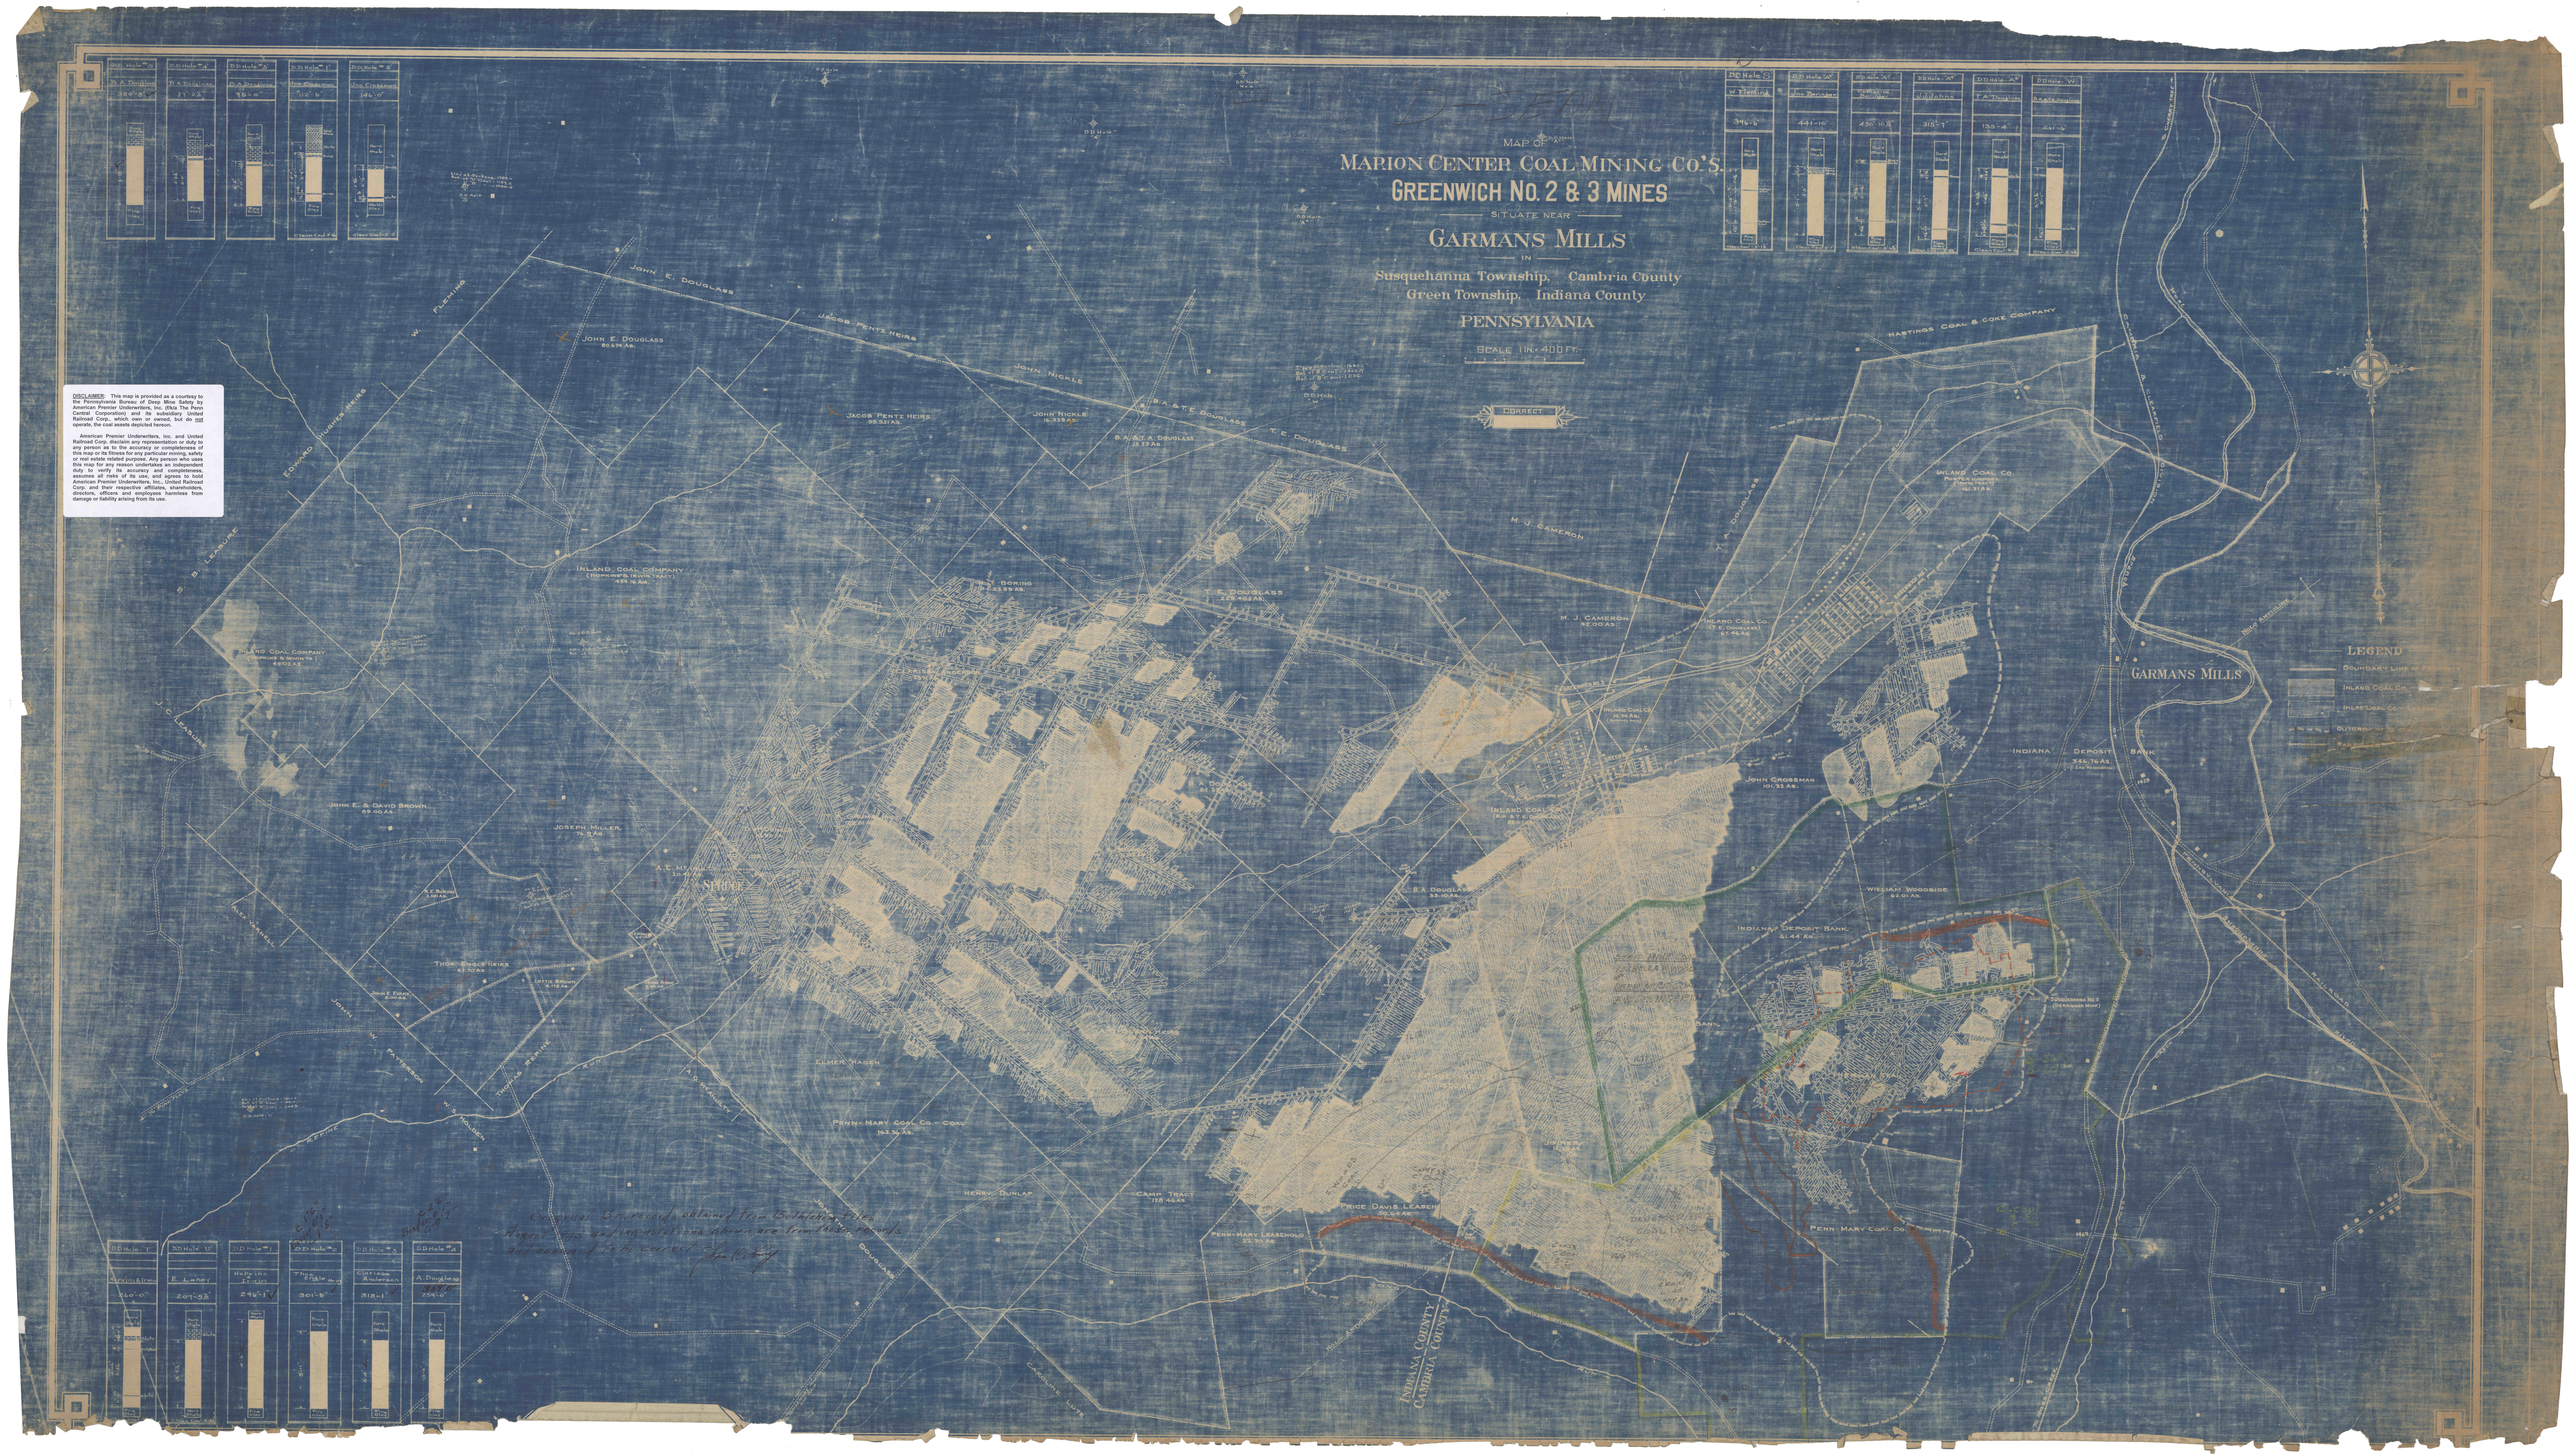

D-SERM

Map of

Marion Center Coal Mining Co.'s
Greenwich No. 2 & 3 Mines

Situate near

Garmans Mills

in

Susquehanna Township, Cambria County
Green Township, Indiana County

PENNSYLVANIA

Scale 1 In. = 400 Ft.

Correct

DISCLAIMER: This map is provided as a courtesy to the Pennsylvania Bureau of Deep Mine Safety by American Premier Underwriters, Inc. (f/k/a The Penn Central Corporation) and its subsidiary United Railroad Corp., which own or owned, but do not operate, the coal assets depicted hereon.

American Premier Underwriters, Inc. and United Railroad Corp. disclaim any representation or duty to any person as to the accuracy or completeness of this map or its fitness for any particular mining, safety or real estate related purpose. Any person who uses this map for any reason undertakes an independent duty to verify its accuracy and completeness, assumes all risks of its use, and agrees to hold American Premier Underwriters, Inc., United Railroad Corp. and their respective affiliates, shareholders, directors, officers and employees harmless from damage or liability arising from its use.

D.D. Hole #5
B. A. Douglass
320'-8"
Dark Shale
Slate
3'-10"
Fire Clay
D.D. Hole #4'
B. A. Douglass
87'-2½"
Dark Shale
slate
2'-2½"
2'-0"
Fire Clay
D.D. Hole #5'
B. A. Douglass
95'-0"
Dark Shale
Slate
slate
2'-2"
1'-11"
Fire Clay
D.D. Hole #1'
Jno. Crossman
112'-6"
Sand-Shale
Slate
Bone
10"
4'-11"
4'-1"
2'-9"
Fire Clay
Clean Coal-3'-1½
D.D. Hole #2'
Jno. Crossman
146'-0"
Dark Shale
Bone
2'-8½"
2'-1½"
slate
Shaley Clay
Clean Coal-2'-5"
D.D. Hole "S"
W. Fleming
396'-6"
Dark Shale
Mother Coal
3'-3"
Fire Clay
Clean Coal - 3'-1½"
D.D. Hole "A2"
Jno. Beringer
441'-10"
Dark Shale
Black Slate
Bone
3'-1"
3'-5"
Fire Clay
Clean Coal-3'-1"
D.D. Hole "A1"
Catherine Beringer
430'-10½"
Dark Shale
Black Slate
3'-9½"
2'-10½"
Slate
Fire Clay
Clean Coal-3'-6¾"
D.D. Hole-"A4"
J.J. Johns
315'-7"
Dark Shale
Bone
3'-6"
2'-7"
Bone
Fire Clay
Clean Coal-3'-3½"
D.D. Hole-"A3"
T.A. Douglass
135'-4"
Dark Shale
Slate
3'-5½"
2'-6½"
Slate
Slate
Fire Clay
Clean Coal-3'-1½
D.D. Hole-"W"
B.A. & T.E. Douglass
261'-6"
Dark Shale
3'-7½"
3'-1"
Slate
Fire Clay
Clean Coal-3'-6½
D.D. Hole-"T"
Hopkins & Irwin
260'-0"
Dark Shale
Slate
Sulphur
Slate
4'-0½"
2'-3½"
Fire Clay
D.D. Hole "U"
E. Laney
207'-5½"
Dark Shale
Slate
3'-5½"
Dark Shale
Clean Coal-3'-5½
D.D. Hole #1
Hopkins & Irwin
296'-1"
Dark Shale
4'-6"
Fire Clay
C 1'6"
Binder 0'1"
C 1'5"
D.D. Hole #2
Thos. Engle Heirs
301'-6"
Dark Shale
3'-11"
Fire Clay
C-2'6"
Binder-0'1"
C-0'7"
D.D. Hole #3
Clarissa Anderson
318'-1"
Dark Shale
3'-4"
Fire Clay
D.D. Hole #4
A. Douglass
359'0"
259'-0"
Dark Shale
3'-6"
Fire Clay
D.D. Hole "A"
D.D. Hole No. 4
D.D. Hole "A"
D.D. Hole "A"
Elev. of Surface - 1589.0
Bot. of "D" Coal - 1189.2
Bot. of "B" Coal - 1030.4
D.D. Hole "S"
1st level surface - 1662.0
Bot. of D Coal - 1402.9
Bot. of B Coal - 1236
D.D. Hole "W"
JOHN E. DOUGLASS
JACOB PENTZ HEIRS
JOHN E. DOUGLASS
80.674 As.
JACOB PENTZ HEIRS
99.951 As.
JOHN NICKLE
JOHN NICKLE
16.339 As.
B. A. & T. E. DOUGLASS
B. A. & T. A. DOUGLASS
13.33 As.
T. E. DOUGLASS
W. FLEMING
EDWARD HUGHES HEIRS
S. B. LEASURE
J. C. LEASURE
TO COOKPORT
INLAND COAL COMPANY
(HOPKINS & IRWIN TRACT)
434.16 As.
No. 1 D.D. Hole
INLAND COAL COMPANY
(HOPKINS & IRWIN TR.)
45.02 As.
D.D. Hole
JOHN E. & DAVID BROWN
89.00 As.
JOSEPH MILLER
76.9 As.
R. E. BORING
2.081 As.
ALEX YARNELL
THOS. ENGLE HEIRS
62.70 As.
JOHN E. EVANS
5.00 As.
LOTTIE BROWN
4.175 As.
JENNIE FRONK
2.24 As.
A. E. McANULTY
20.41 As.
SPRUCE
JOHN W. PATTERSON
THOMAS REPINE
W. S. HOLDEN
RUN
A. D. McANULTY
ELMER HAGEN
PENN-MARY COAL CO. - COAL
163.36 As.
JONATHAN DOUGLASS
HENRY DUNLAP
CAMP TRACT
128.46 As.
CAROLINE LUTE
TO PINE FLATS
D.D. Hole - U
TO UNION...
T. BORING
33.89 As.
T. E. DOUGLASS
259.405 As.
CLARISSA ANDERSON
T. E. CRUMBAKER
125.81
B. A. DOUGLASS
82.33 As.
B. A. DOUGLASS
33.10 As.
D.D. Hole No. 4
D.D. Hole No. 3
M. J. CAMERON
M. J. CAMERON
42.00 As.
T. A. DOUGLASS
HASTINGS COAL & COKE COMPANY
INLAND COAL CO.
PORTER KINPORT
(IRWIN TRACT)
161.31 As.
INLAND COAL CO.
(T. E. DOUGLASS)
67.46 As.
GREENWICH No. 3
GREENWICH No. 2
GREENWICH No. 1
INLAND COAL CO.
14.74 As.
(SURFACE ONLY)
INLAND COAL CO.
(B. A. & T. E. DOUGLASS)
JOHN CROSSMAN
101.32 As.
STRIP MINE COAL
ISABELLA WOOD
DEEP MINE COAL
B. W. DERRINGER
INDIANA DEPOSIT BANK
F. WOODS COAL
PRICE DAVIS LEASEH
50.64 As.
PENN-MARY LEASEHOLD
22.70 As.
DERRINGER BROS. COAL LANDS
OUTCROP OF D COAL
LONG RUN
NOLO ANTICLINE
INDIANA COUNTY
CAMBRIA COUNTY
WILLIAM WOODSIDE
62.01 As.
INDIANA DEPOSIT BANK
61.44 As.
SUSQUEHANNA No. 2
(DERRINGER MINE)
PENN-MARY COAL CO.
INDIANA DEPOSIT BANK
346.76 As.
(1.5 As. RESERVATION)
GARMANS MILLS
TO CHERRY TREE
WEST BRANCH
CAMBRIA & CLEARFIELD DIVISION
PENNSYLVANIA RAILROAD
SUSQUEHANNA RIVER
ROSS CREEK
TO ROSS CREEK
NOLO ANTICLINE
SCALE 1 IN. = 400 FT.
LEGEND
BOUNDARY LINE OF PROPERTY
INLAND COAL CO.
INLAND COAL CO. - LEASED
OUTCROP OF "D" COAL
RAILROAD

Original B.H. records obtained from Bethlehem files August 1945 and ink notations shown are from these records and assumed to be correct.