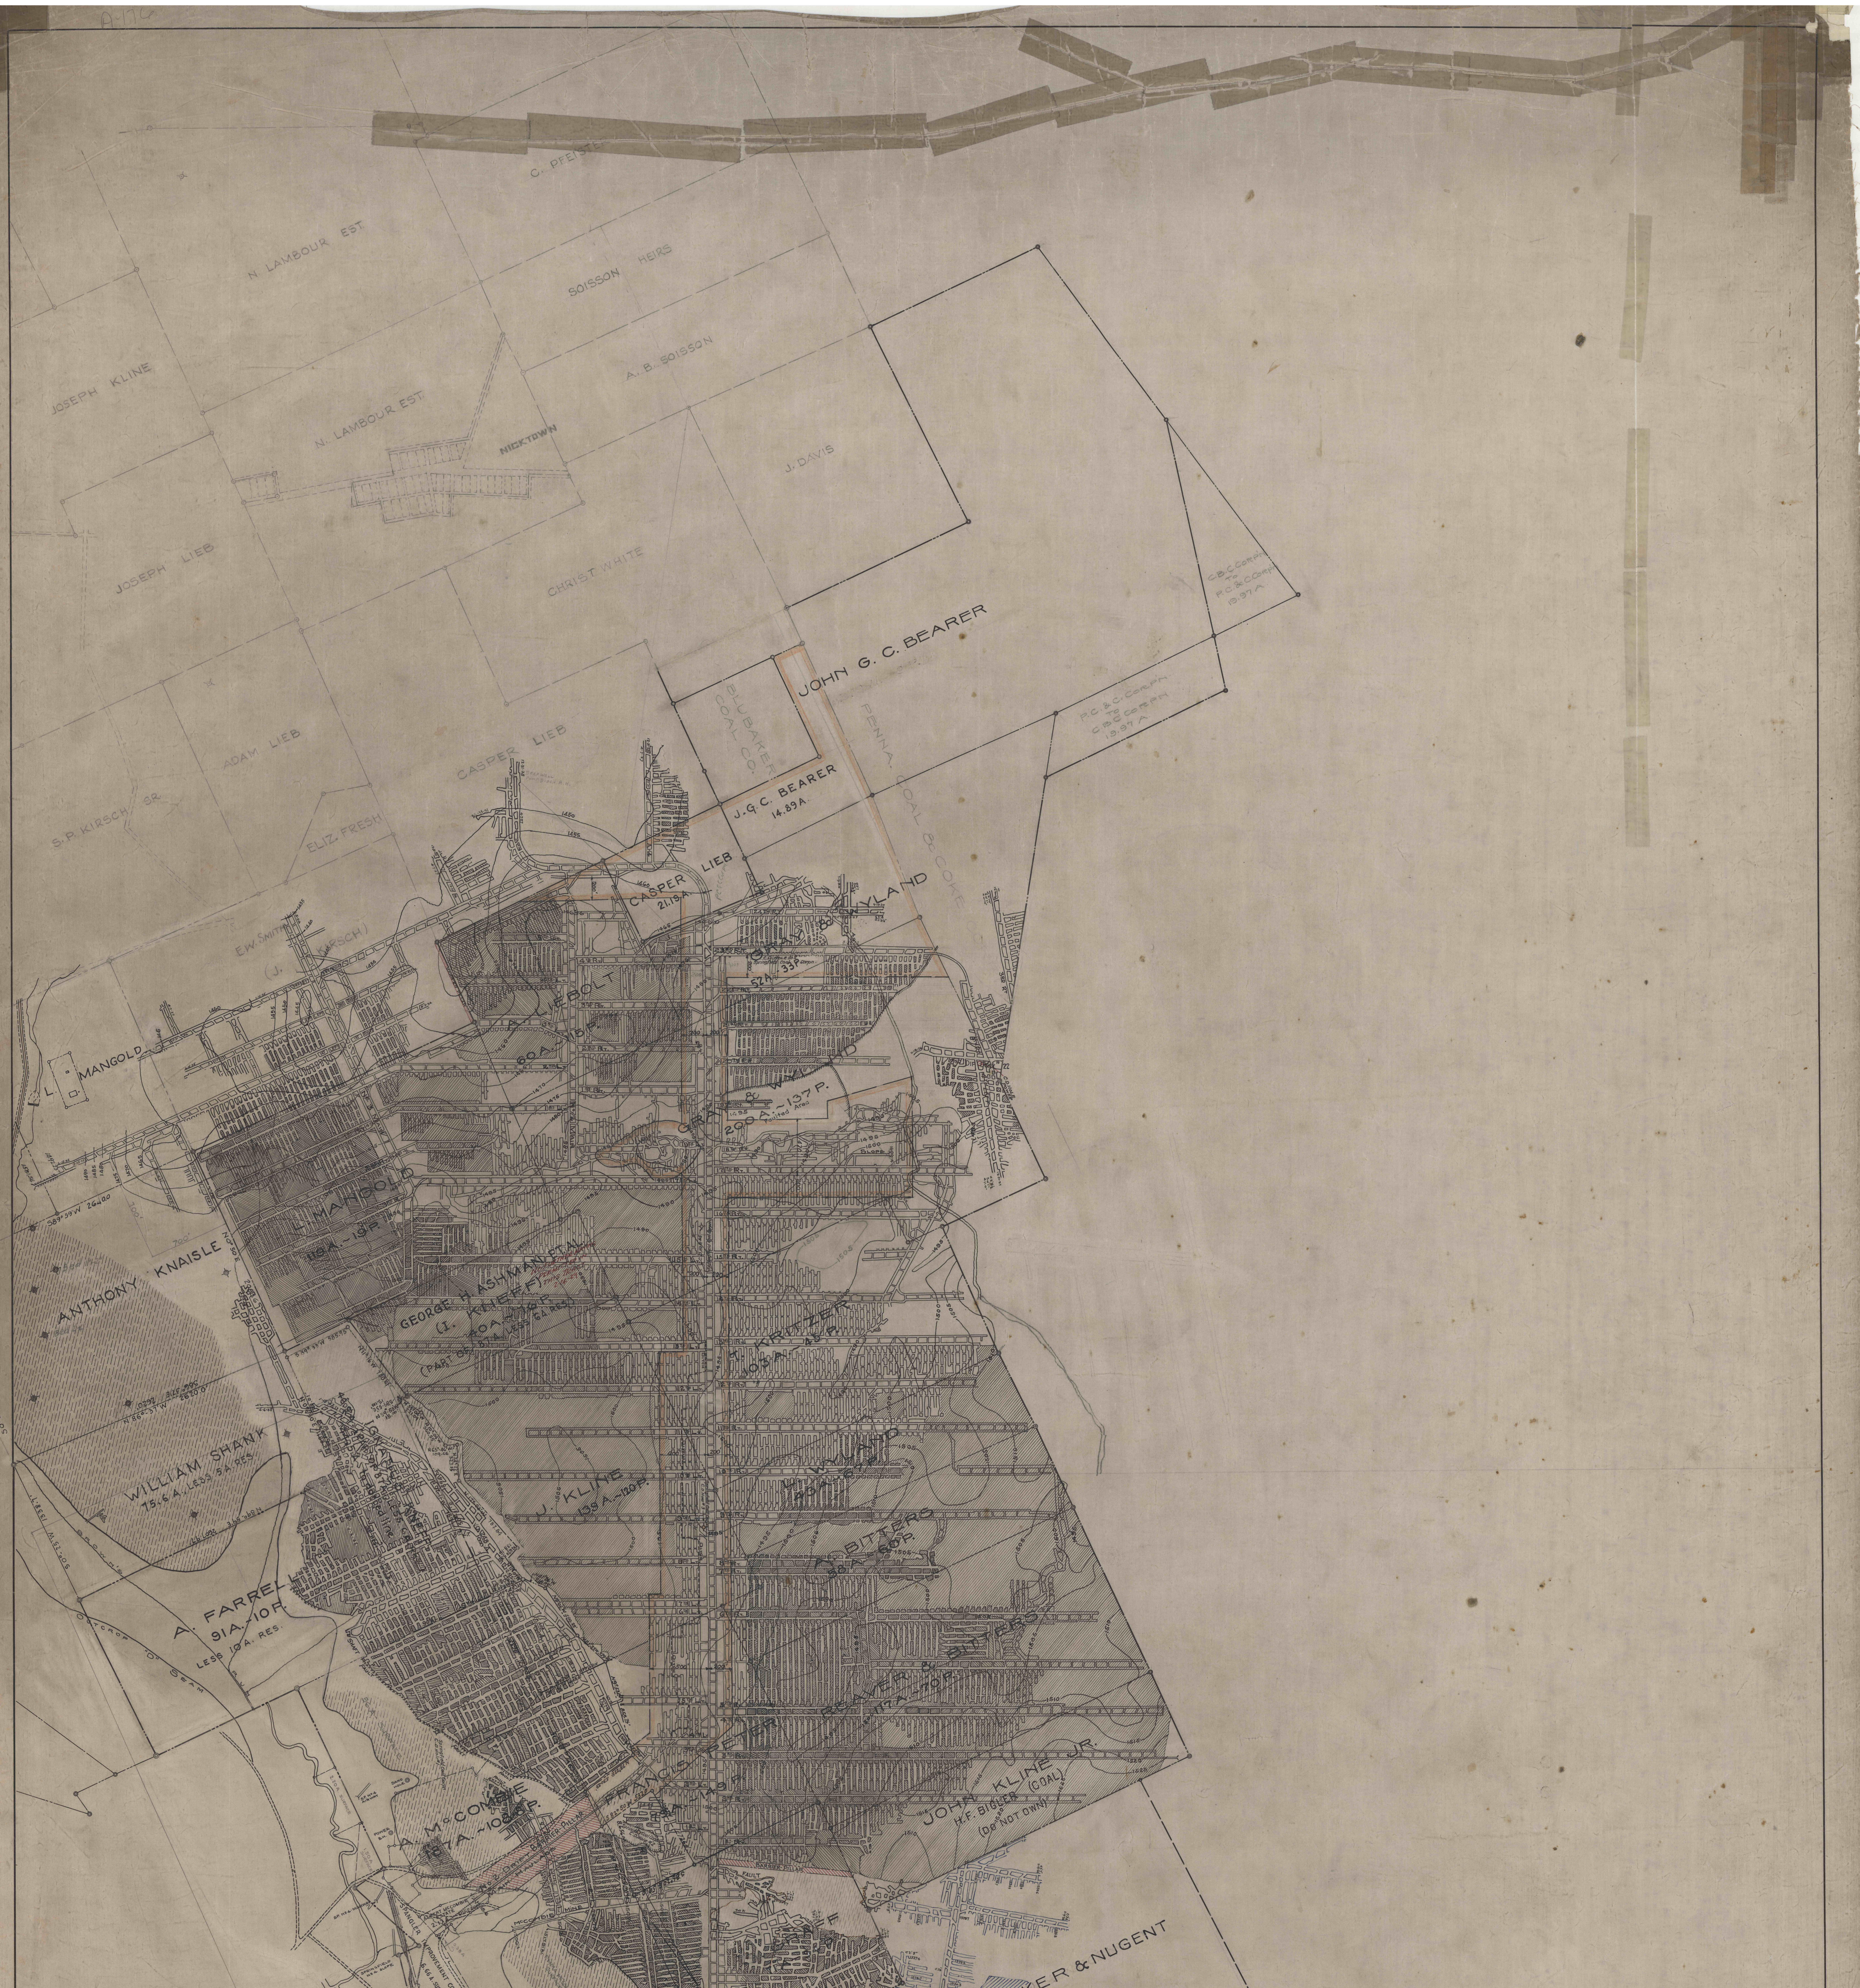
C. PFEISTER
N. LAMBOUR EST.
SOISSON HEIRS
JOSEPH KLINE
N. LAMBOUR EST.
A. B. SOISSON
NICKTOWN
J. DAVIS
JOSEPH LIEB
CHRIST WHITE
JOHN G. C. BEARER
BUBAKER COAL CO.
PENNA. COAL & COKE CO.
C.B.C. CORP'N TO P.C.&C. CORP'N 19.97 A.
P.C.&C. CORP'N TO C.B.C. CORP'N 19.97 A.
ADAM LIEB
CASPER LIEB
S.P. KIRSCH SR.
ELIZ. FRESH
J.G.C. BEARER 14.89 A.
CASPER LIEB 21.19 A.
GRAY & WYLAND 52 A.-33 P.
E.W. SMITH (J. KIRSCH)
A. LIEBOLT 60 A.-15 P.
L. MANGOLD
GRAY & WYLAND 20.0 A.-137 P.
L. MANGOLD 119 A.-19 P.
ANTHONY KNAISLE
GEORGE H. ASHMAN ET AL. (I. KIEFF) 40 A.-10 P. (PART OF 87 A. LESS 6 A. RES.)
T. KRITZER 103 A.-45 P.
WILLIAM SHANK 75.6 A. LESS 5 A. RES.
J. KLINE 139 A.-120 P.
L. WYLAND 40 A.
A. BITTERS 58 A.-60 P.
A. FARRELL 91 A.-10 P. LESS 10 A. RES.
OUTCROP "D" SEAM
REAVER & BITTERS 117 A.-70 P.
FRANCIS PETER
JOHN KLINE JR. H.F. BIGLER (COAL) (DO NOT OWN)
A. McCOMBIE 107 A.-108 P.
BARRIER PILLAR
FAULT
McCOMBIE MINE
SPANGLER IMPROVEMENT CO. 6.66 A. SURFACE
REGINA McCOMBIE ET AL 20.317 A. SURFACE
N.Y.C. SIDING
J. SHERRY 29 A.-99 P.
MRS. H. DOUGHERTY 68 A.
BAKER & NUGENT
MINED OUT
A. ECKENRODE 59 A.
9.77 AC. NORTHERN CAMBRIA SCHOOL DISTRICT
C. & C. DIV. PENNA. R.R.
NORTH
POWER S.H.
SPRINGFIELD No. 4 SLOPE

PENNSYLVANIA COAL AND COKE CORPORATION
PARDEE No. 61 COLLIERY

BARR TWP., CAMBRIA CO., PENNA.

SCALE 1" = 400' MAY, 1916

~~A-178~~ A-176

DISCLAIMER: This map is provided as a courtesy to the Pennsylvania Bureau of Deep Mine Safety by American Premier Underwriters, Inc. (f/k/a The Penn Central Corporation) and its subsidiary United Railroad Corp., which own or owned, but do not operate, the coal assets depicted hereon.

American Premier Underwriters, Inc. and United Railroad Corp. disclaim any representation or duty to any person as to the accuracy or completeness of this map or its fitness for any particular mining, safety or real estate related purpose. Any person who uses this map for any reason undertakes an independent duty to verify its accuracy and completeness, assumes all risks of its use, and agrees to hold American Premier Underwriters, Inc., United Railroad Corp. and their respective affiliates, shareholders, directors, officers and employees harmless from damage or liability arising from its use.

A-176

ENGINEERING DEPARTMENT CLEARFIELD BITUMINOUS COAL CORP'N					
REVISED	1-1-19	1-1-20	1-1-21	7-1-21	12-5-22
REVISED					
REVISED					

DRAWN BY;~ F. K. PROSSER & P. GILL
TRACED BY;~ C. BERNER & P. GILL
CORRECT ;~ Paul Gill DIV. ENG'R
APPROVED;~ Fred K. Turner CHIEF ENGINEER