


E. J. GARMAN	No. 1200	1200	1200	

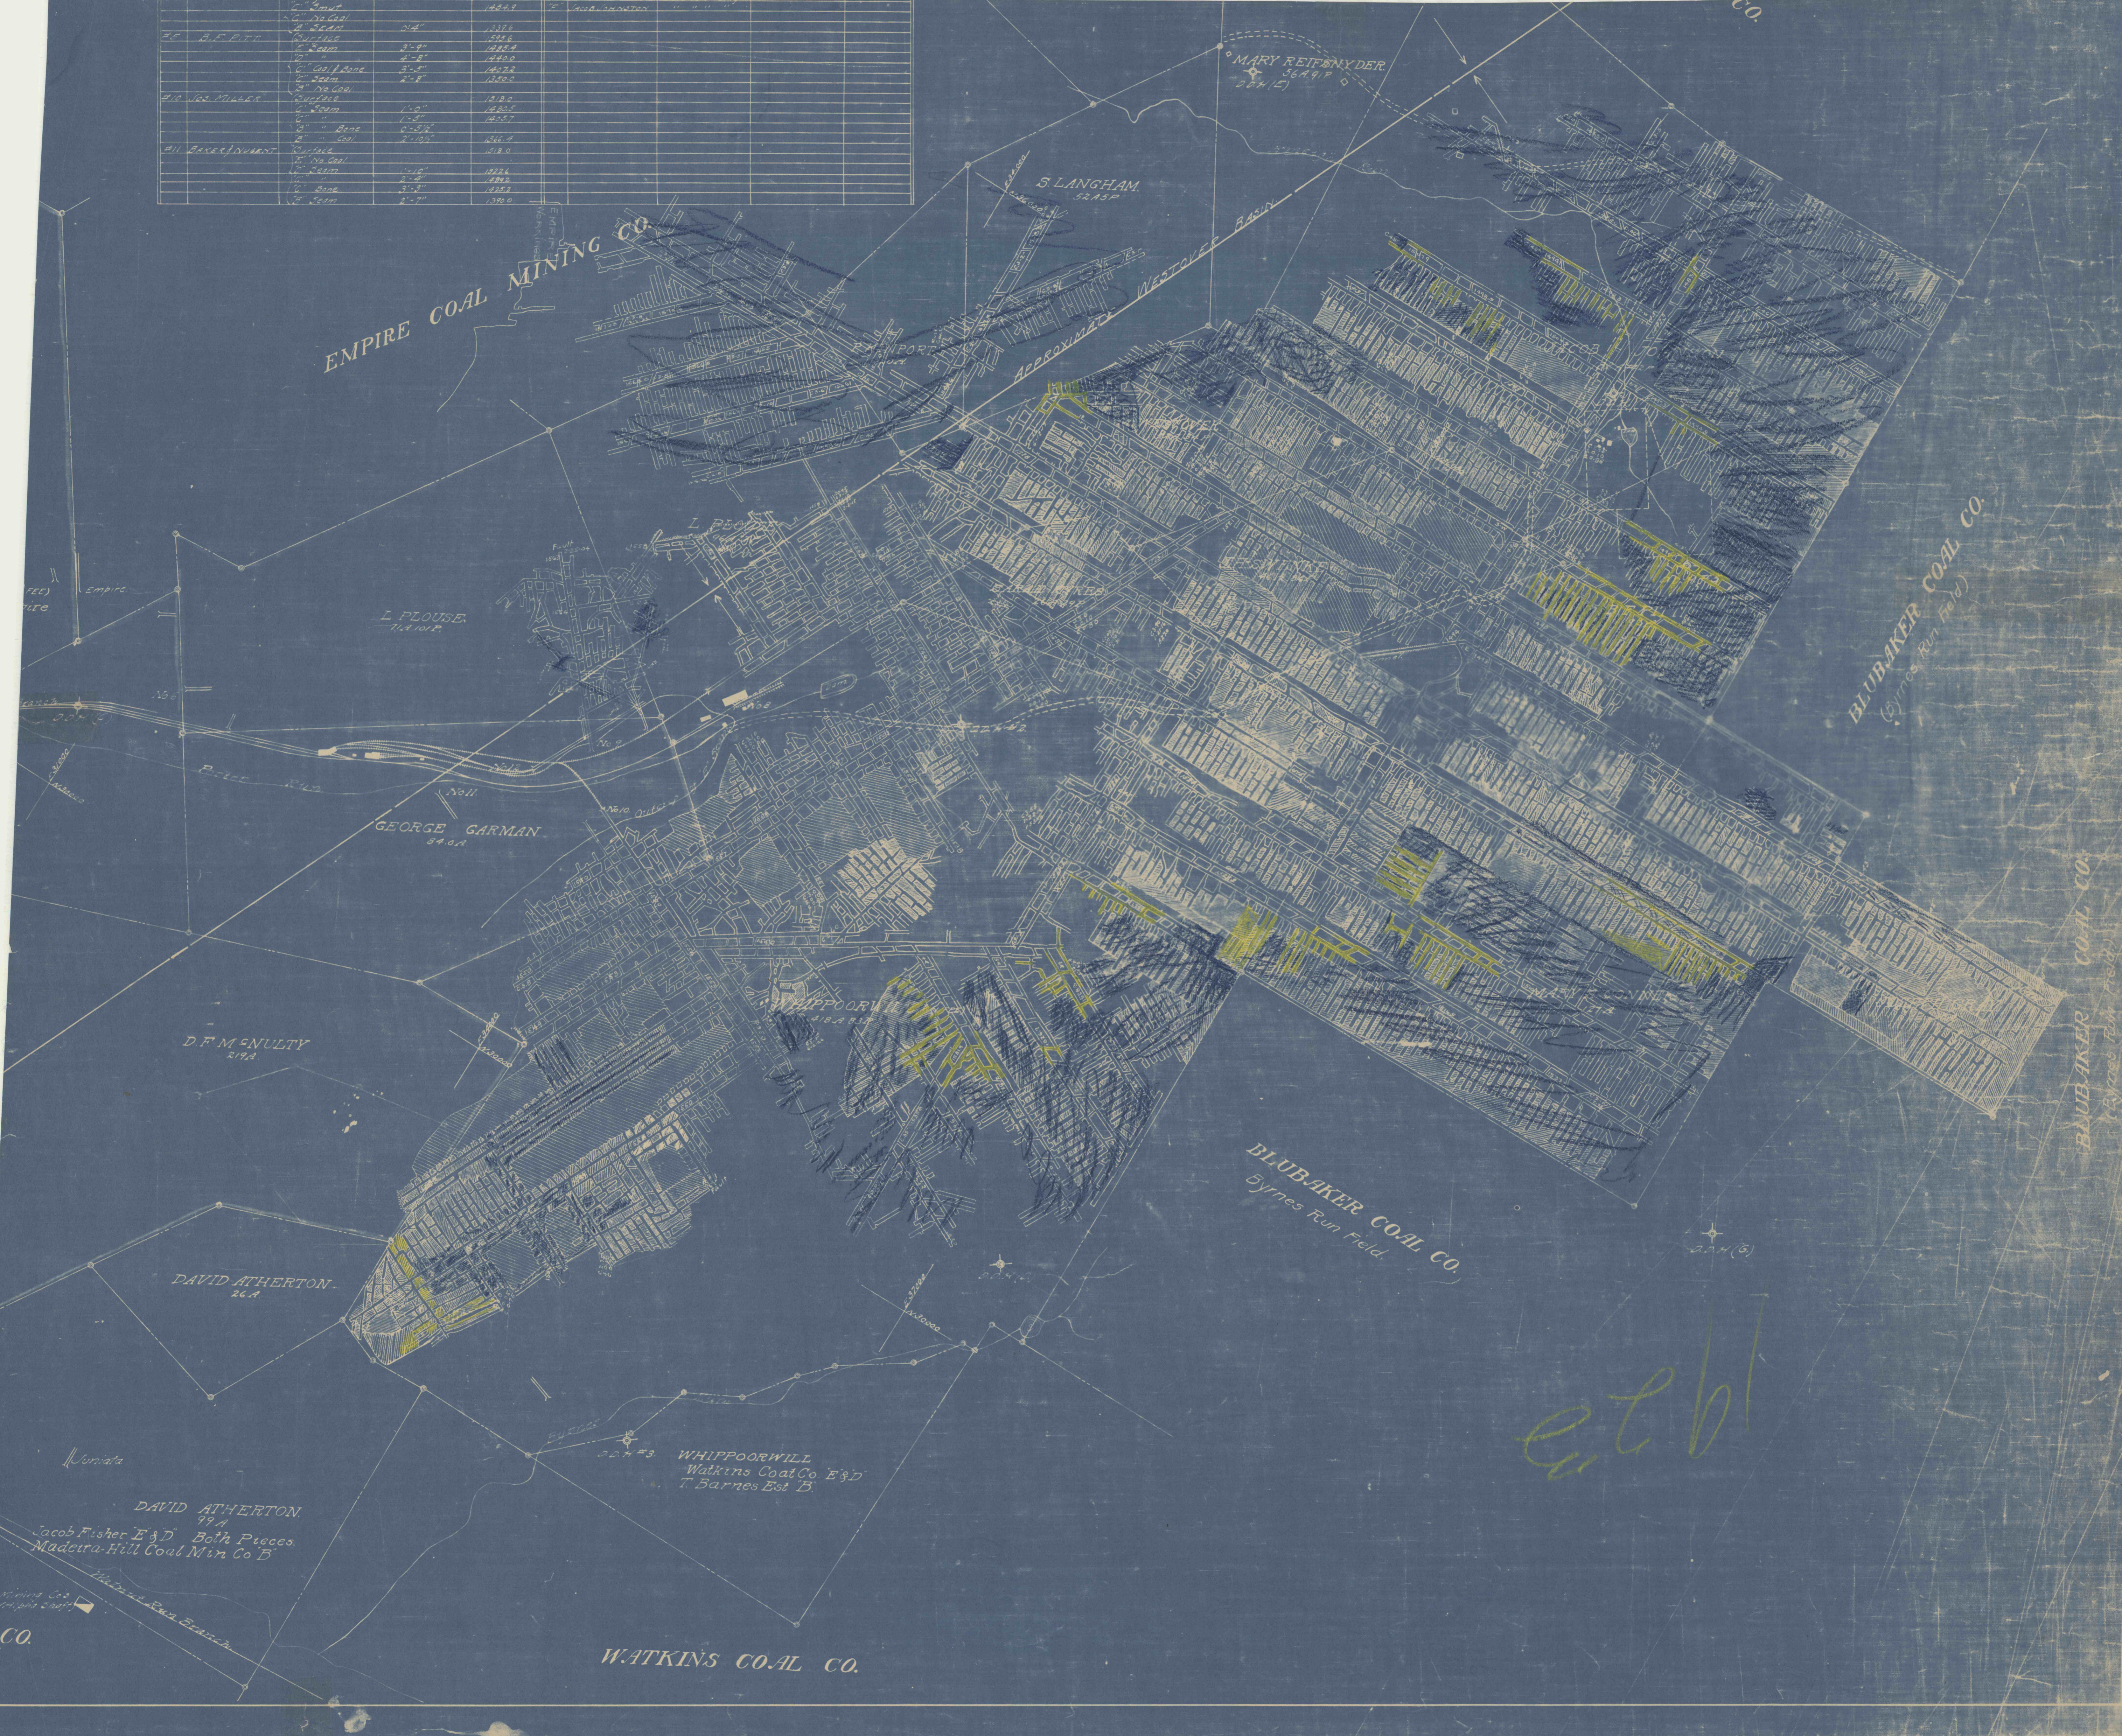

DAVID ATHERTON  
 99A  
 Jacob Fisher E & D Both Pieces  
 Madeira-Hill Coal Min Co B

WATKINS COAL CO.

BLUBAKER COAL CO.  
 Byrnes Run Field

BLUBAKER COAL CO.  
 (Byrnes Run Field)

BLUBAKER COAL CO.  
 (Byrnes Run Field)

eabb