


MAP OF
COAL MINES
BELONGING TO
BARNES & TUCKER COAL CO.
BARNESBORO, PA.
D SEAM
SCALE 1"=400'
BARNES & TUCKER ENGR. DEPT.

DIAMOND DRILL RECORD


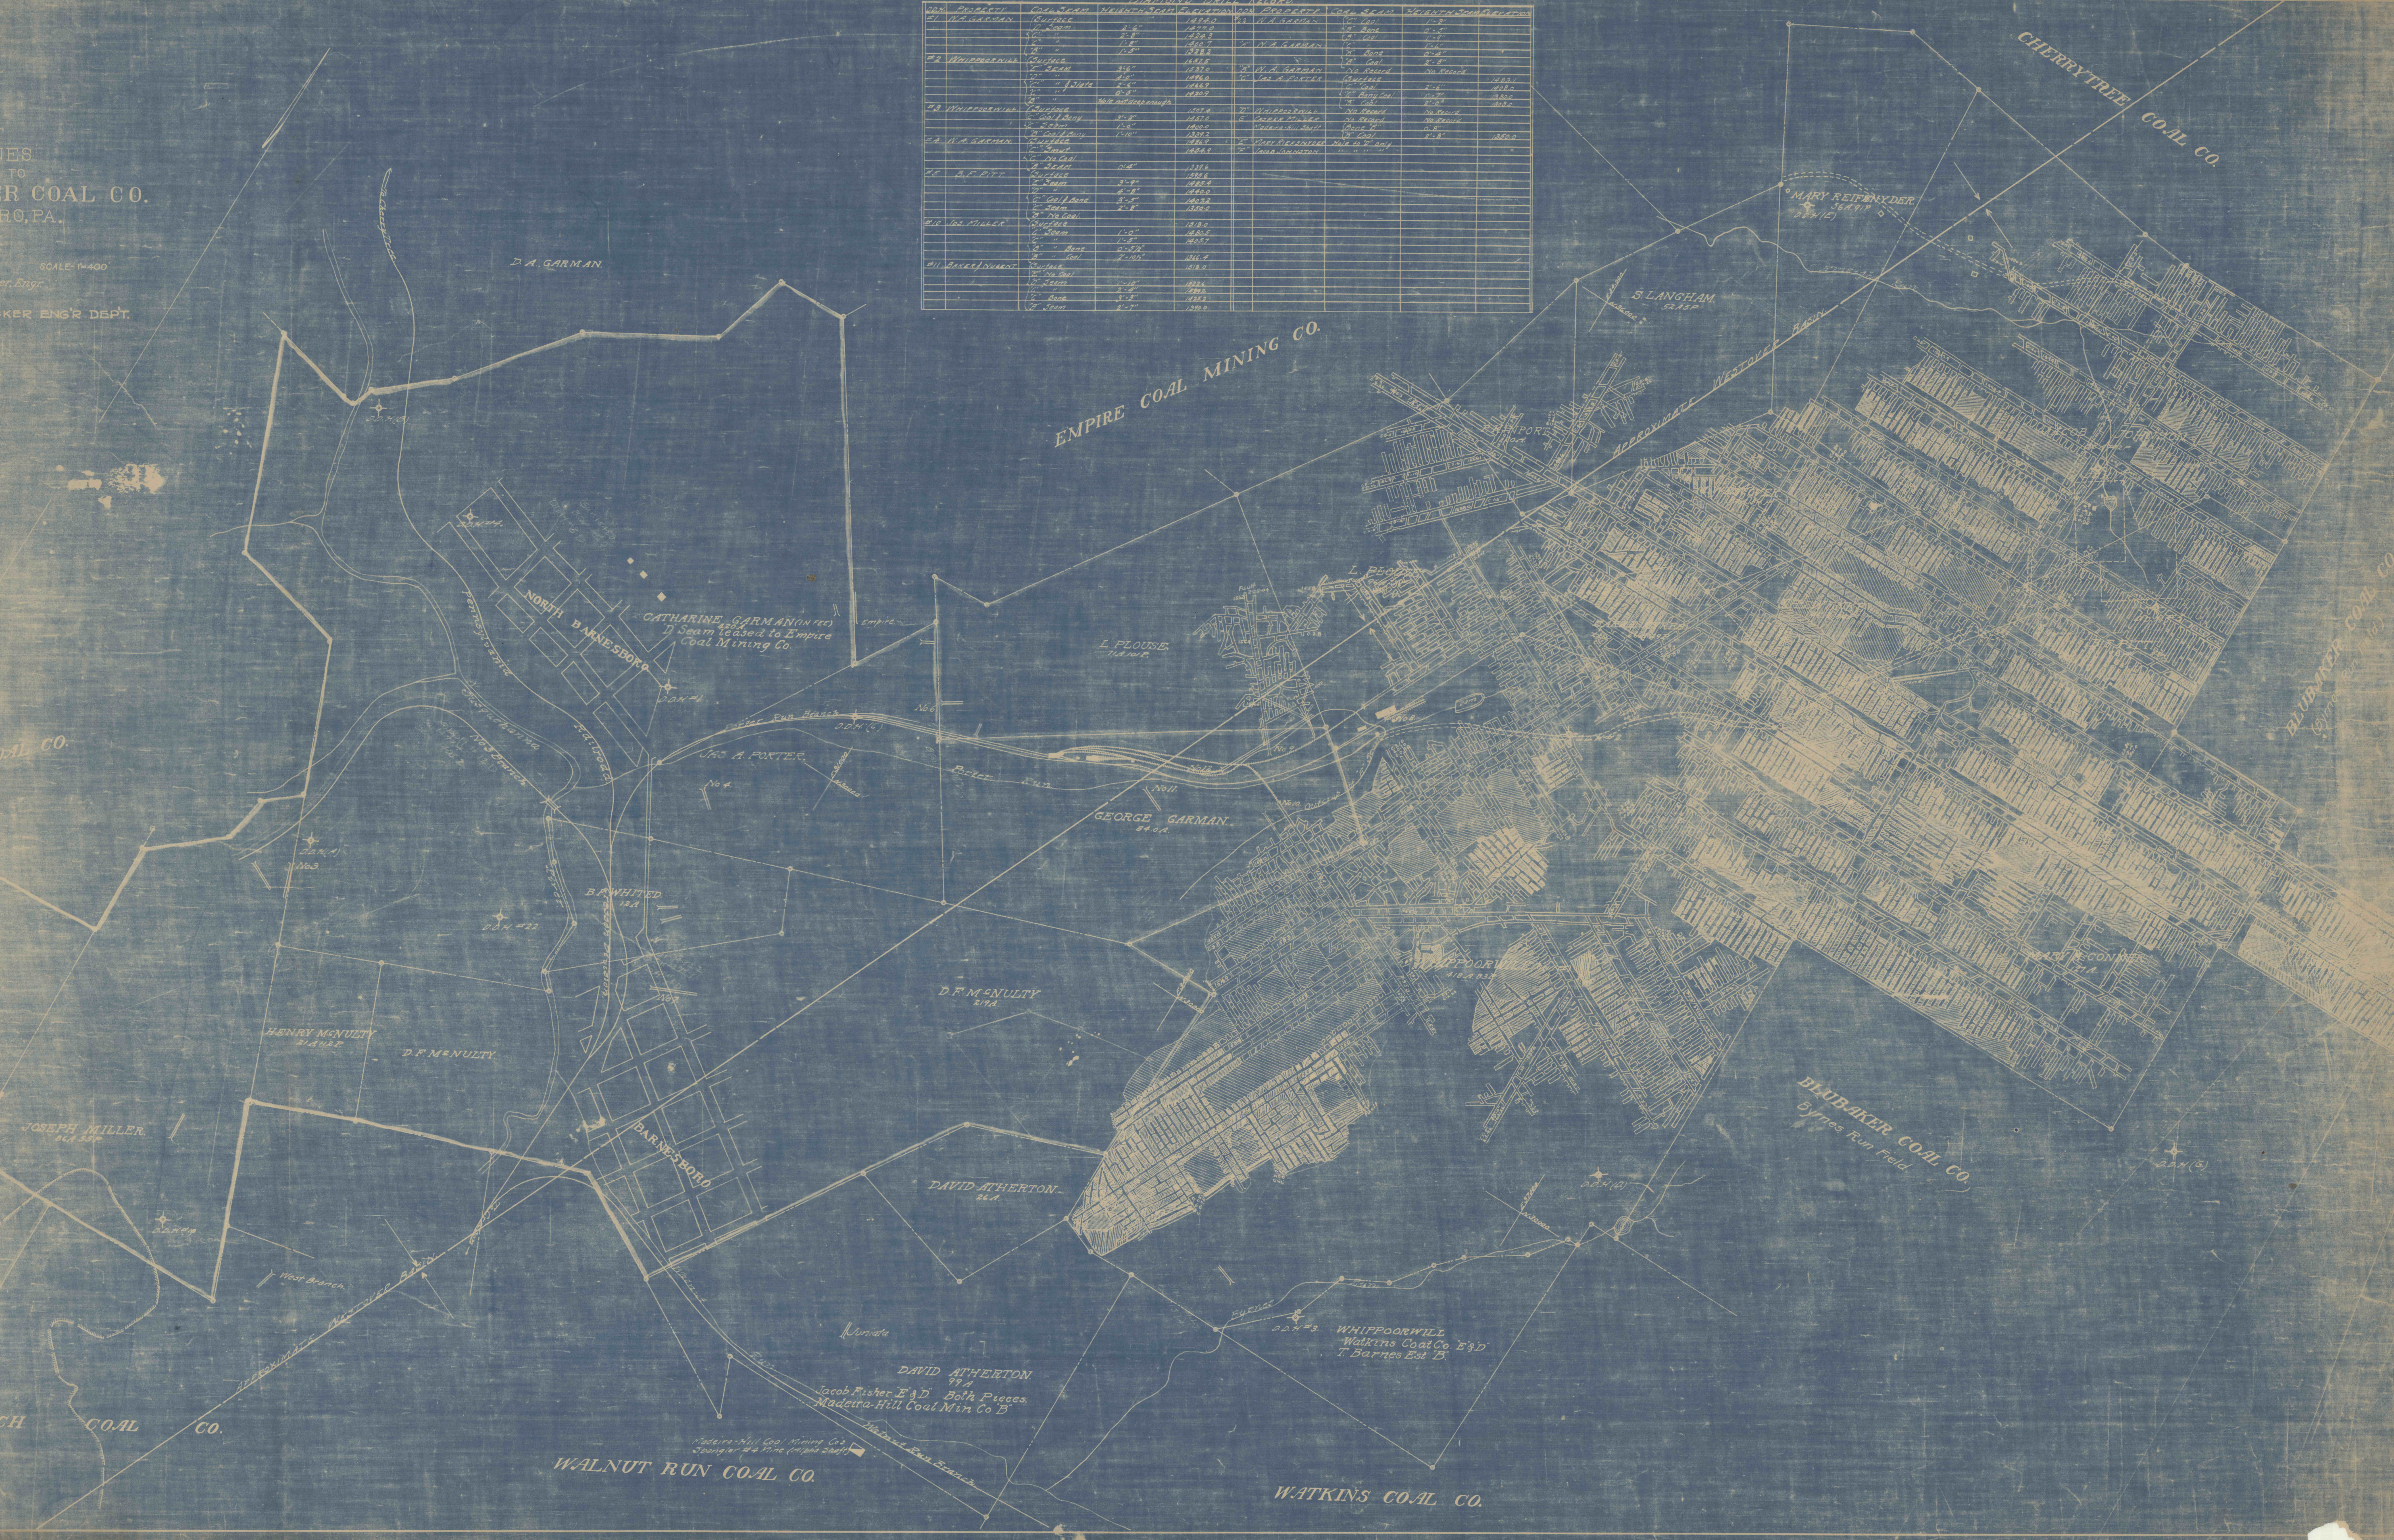

BARNESBORO COAL CO.
No. 2

BRANCH COAL CO.

WALNUT RUN COAL CO.

WATKINS COAL CO.



CHERRYTREE COAL CO.

EMPIRE COAL MINING CO.

JOSEPH MILLER
No. 3

HENRY McNULTY
No. 2

D.F. McNULTY

B. WHITTE
No. 1

BARNESBORO

DAVID ATHERTON
No. 1

GEORGE GARMAN
No. 1

JOHN A. PORTER
No. 1

L. FLOUSE
No. 1

S. LANGHAM
No. 1

MARY REITENYDER
No. 1

D.A. GARMAN

CATHARINE GARMAN (IN DEC)
D Seam leased to Empire Coal Mining Co.

DAVID ATHERTON
Jacob Fisher, E. & D. Both Pieces
Madara Hill Coal Min. Co. D

WHIPPOORWILL
Walkers Coal Co. E & D
T. Barnes Est. D.