


SEMIT SOLVAY PROCESS CO. WATKINS COAL MINING CO.

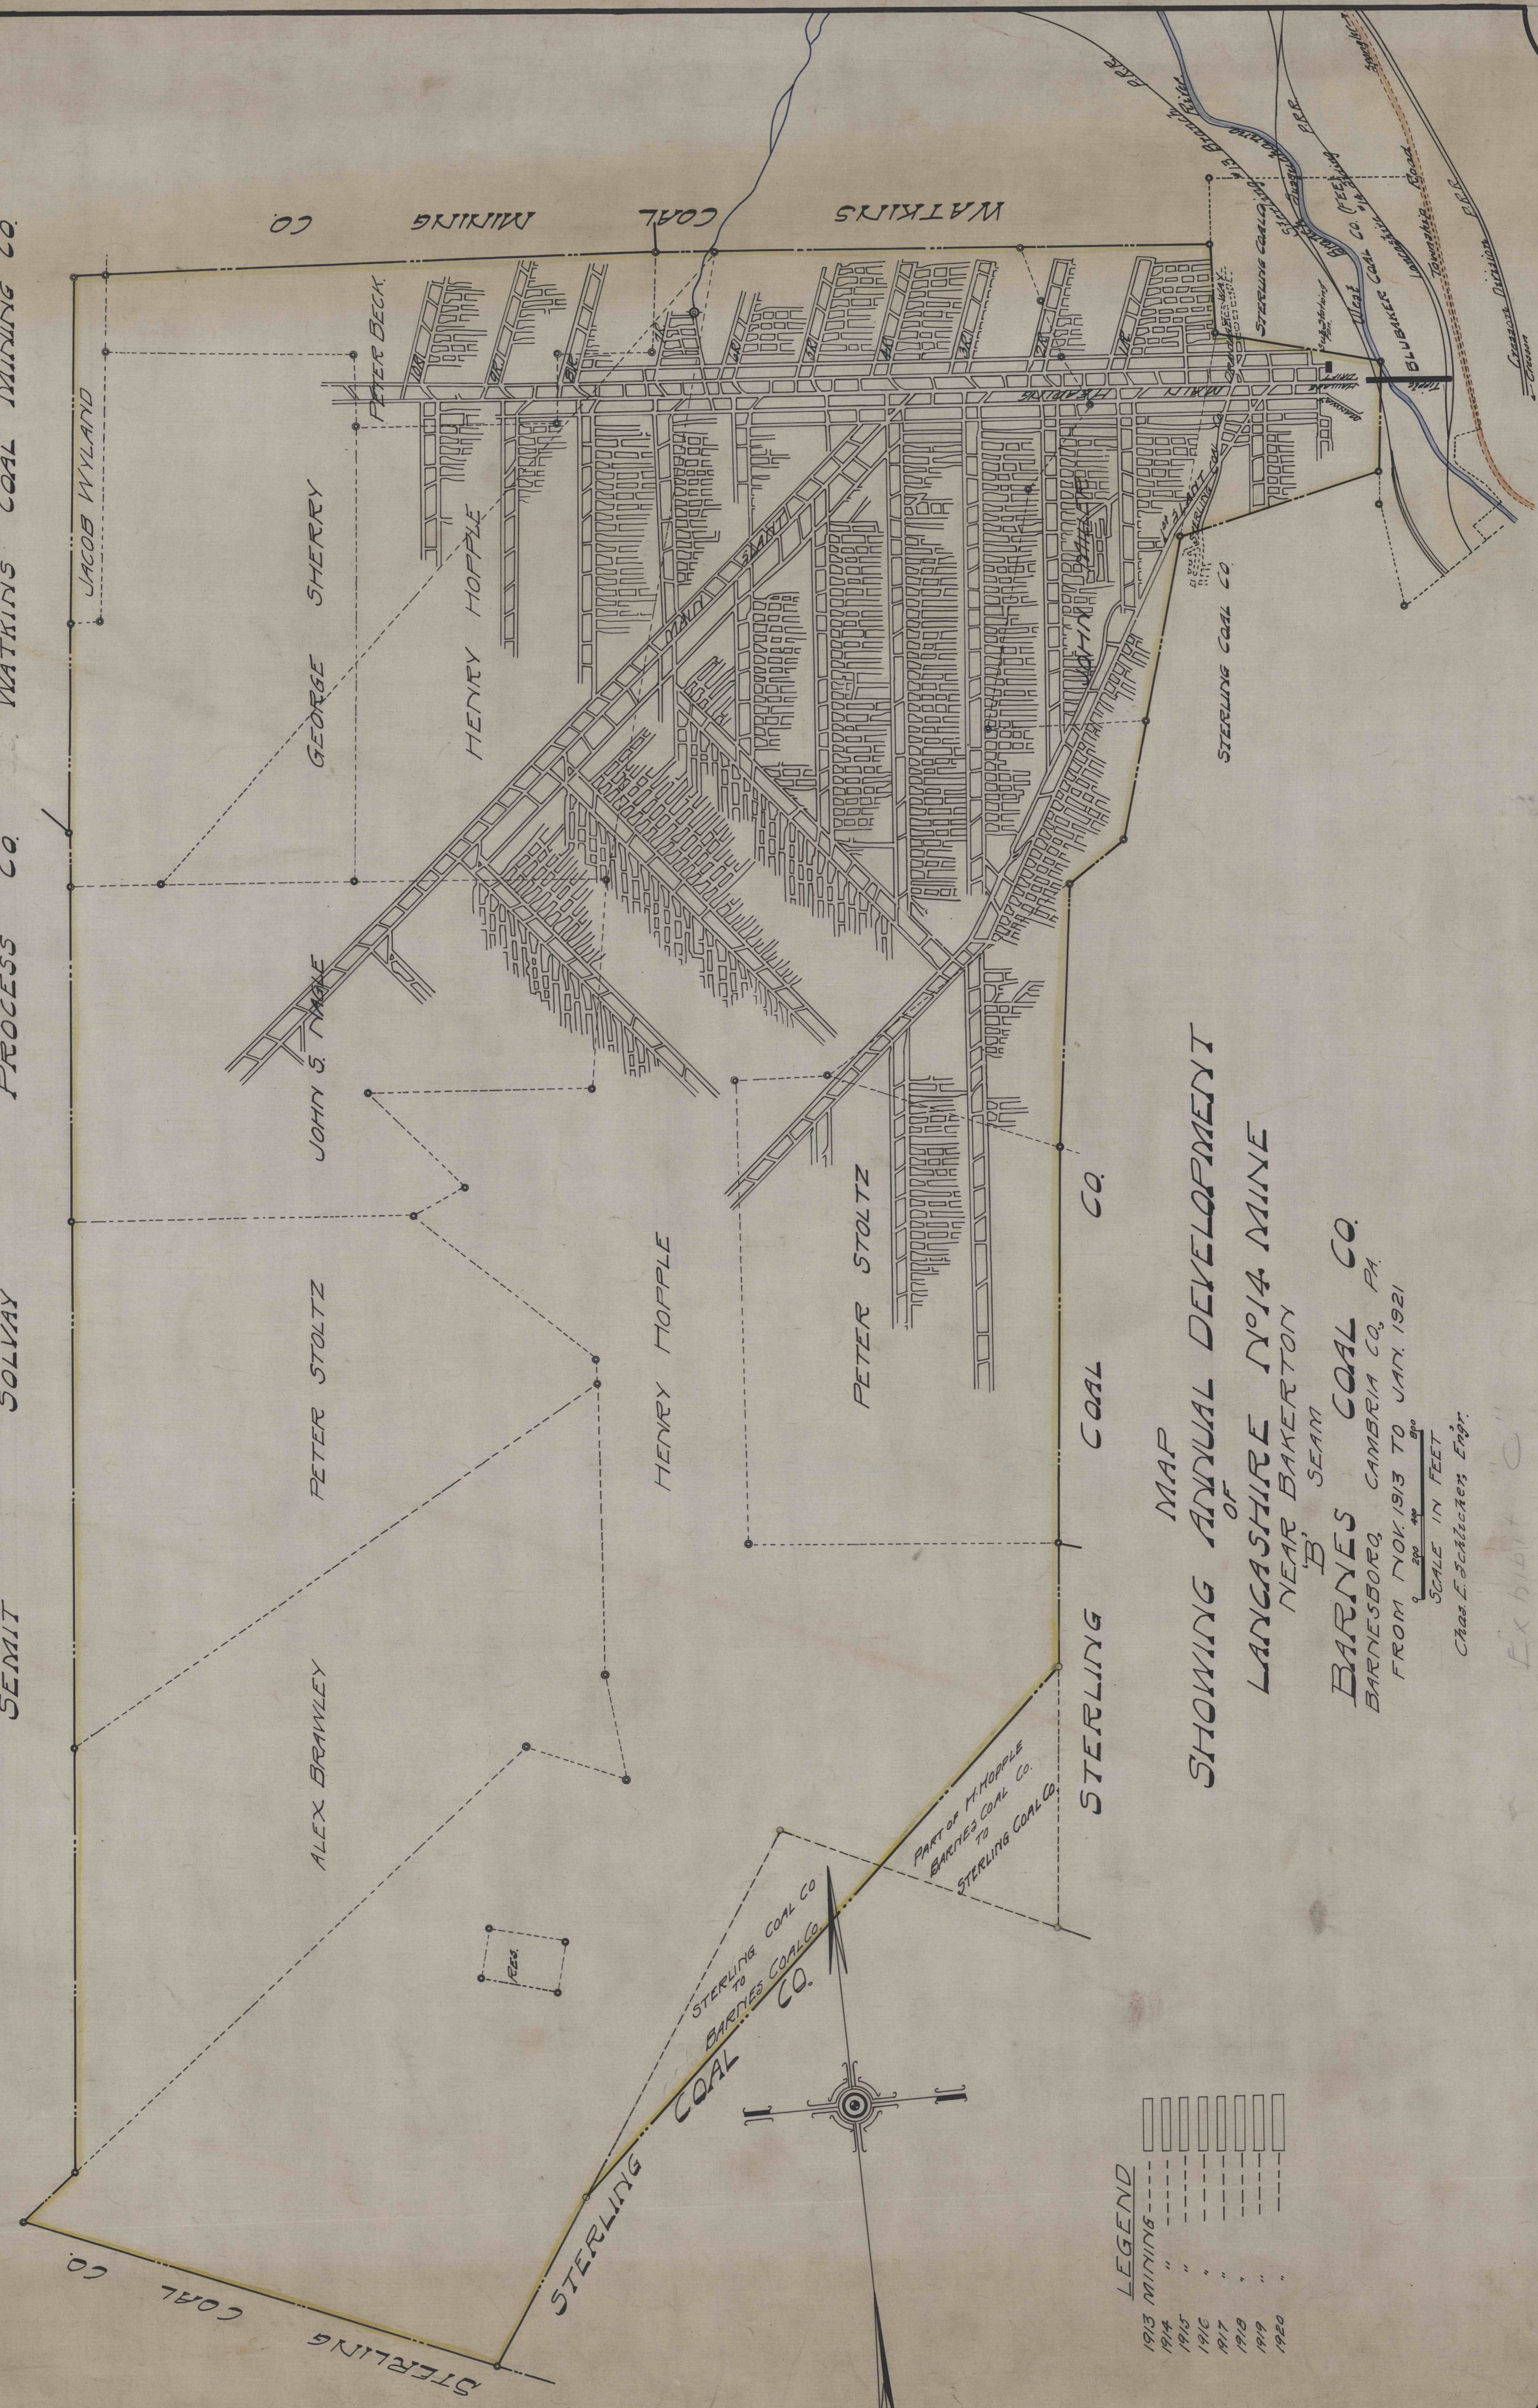

MAP OF
SHOWING ANNUAL DEVELOPMENT
 OF
LANGASHIRE NO. 14 MINE
 NEAR BAKERTON
 "B" SEAM
BARNES COAL CO.
 BARNESBORO, CAMBERIA CO., PA.
 FROM NOV. 1913 TO JAN. 1921

SCALE IN FEET
 0 50 100 200
 Chas. E. Schaeffer, Engr.

LEGEND

1913 MINING	—
1914	- - -
1915	· · ·
1916	- · -
1917	- - -
1918	- - -
1919	- · -
1920	· · ·