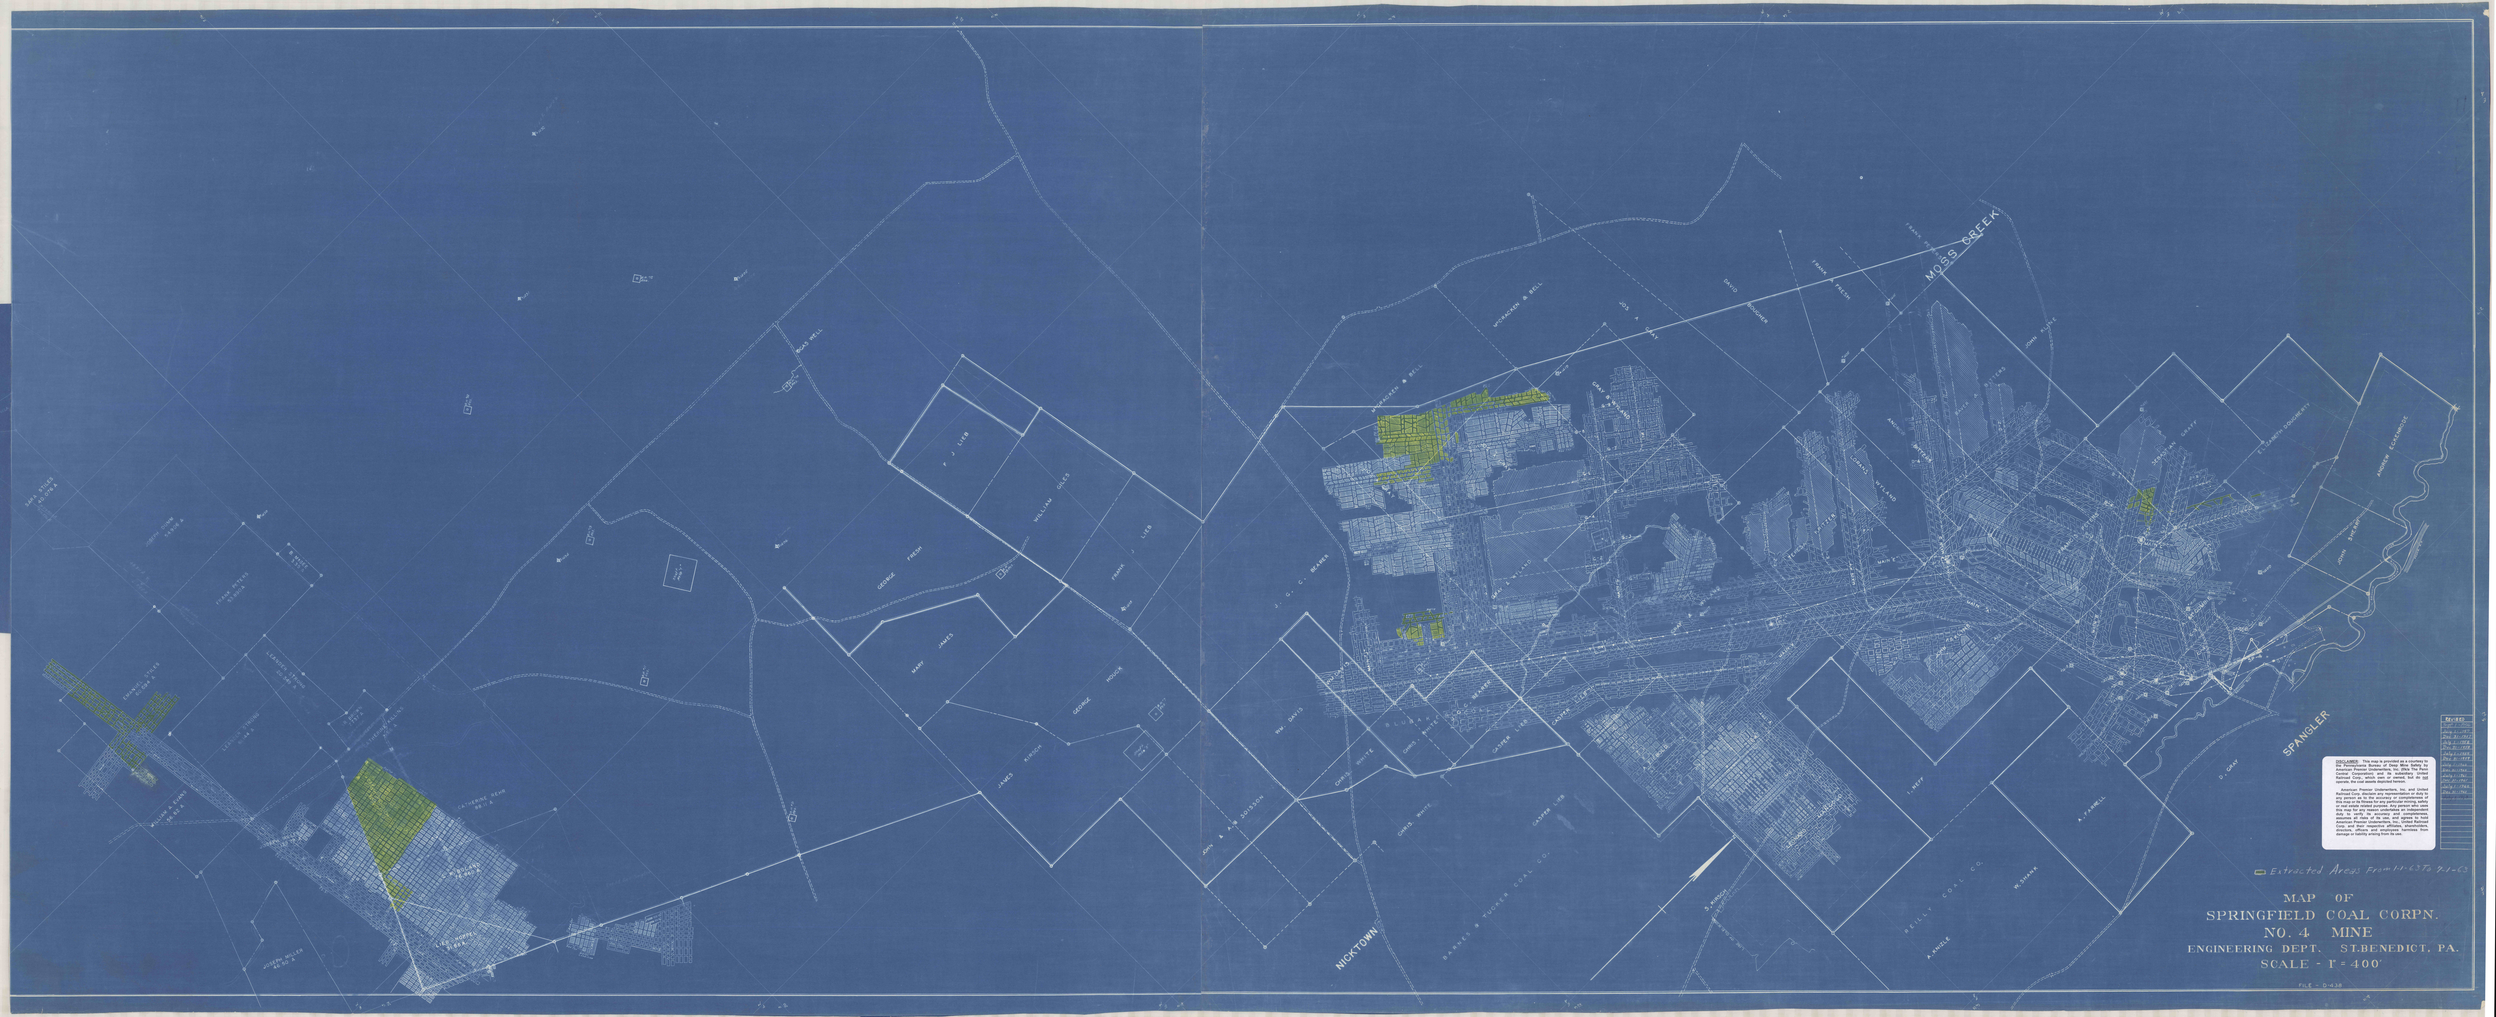
MOSS CREEK
SPANGLER
NICKTOWN
MAP OF
SPRINGFIELD COAL CORPN.
NO. 4 MINE
ENGINEERING DEPT. ST.BENEDICT, PA.
SCALE - 1" = 400'
FILE - D-438
Extracted Areas From 1-1-63 To 9-1-63
REVISED