




TINTED AREA BARNES & TUCKER  
EXTRACTIONS AS OF 7-1-57

MAP OF  
SPRINGFIELD COAL CORPN.  
NO. 4 MINE  
ENGINEERING DEPT. ST. BENEDICT, PA.  
SCALE - 1" = 400'

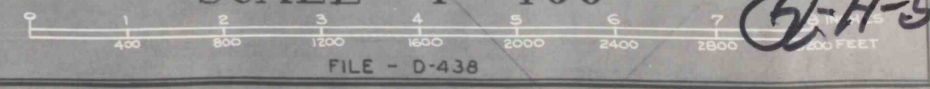

RECD FROM B. & T. 9-6-57 CONFERENCE RELATIVE TO V-6 AREA EXTENSION 12-16-57 NOTES, ETC. 12-28-57 Paul Hill

REVISED  
Sept. 1, 1956  
July 1, 1957