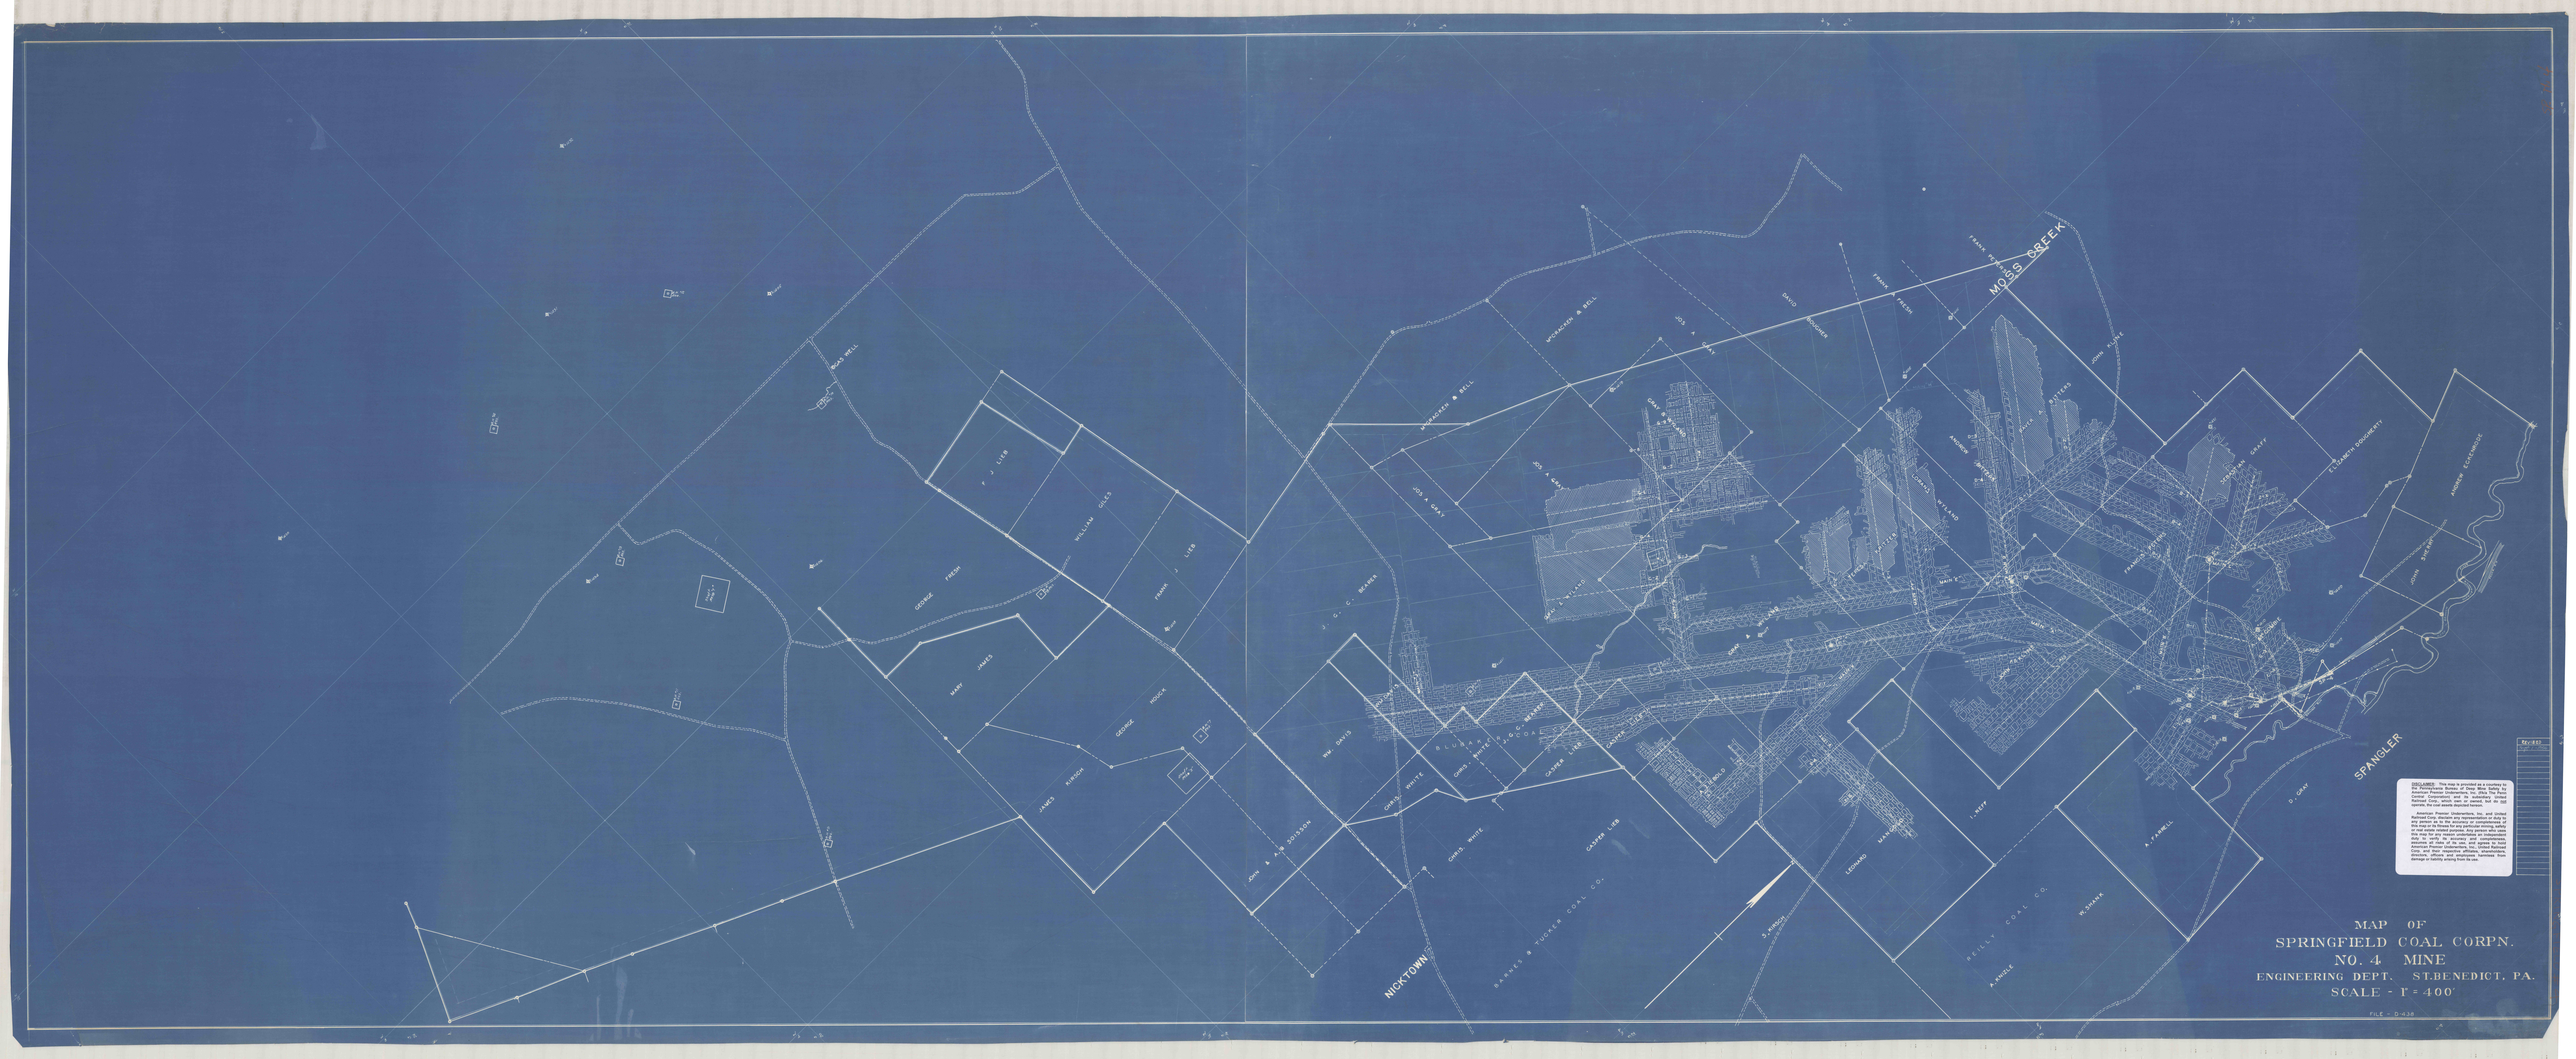
MOSS CREEK
SPANGLER
NICKTOWN
GEORGE FRISH
WILLIAM GILES
F. J. LIEB
FRANK J. LIEB
GEORGE HOOK
JAMES HERSH
J. G. C. BEARD
WM. DAVIS
CHAS. WHITE
CHAS. WHITE
CHAS. WHITE
BLUBAK
CHAS. WHITE
J. G. C. BEARD
CASPER LIEB
CASPER LIEB
JOS. A. WRAY
JOS. A. WRAY
FRANK FRISH
FRANK FRISH
JOHN KLINE
