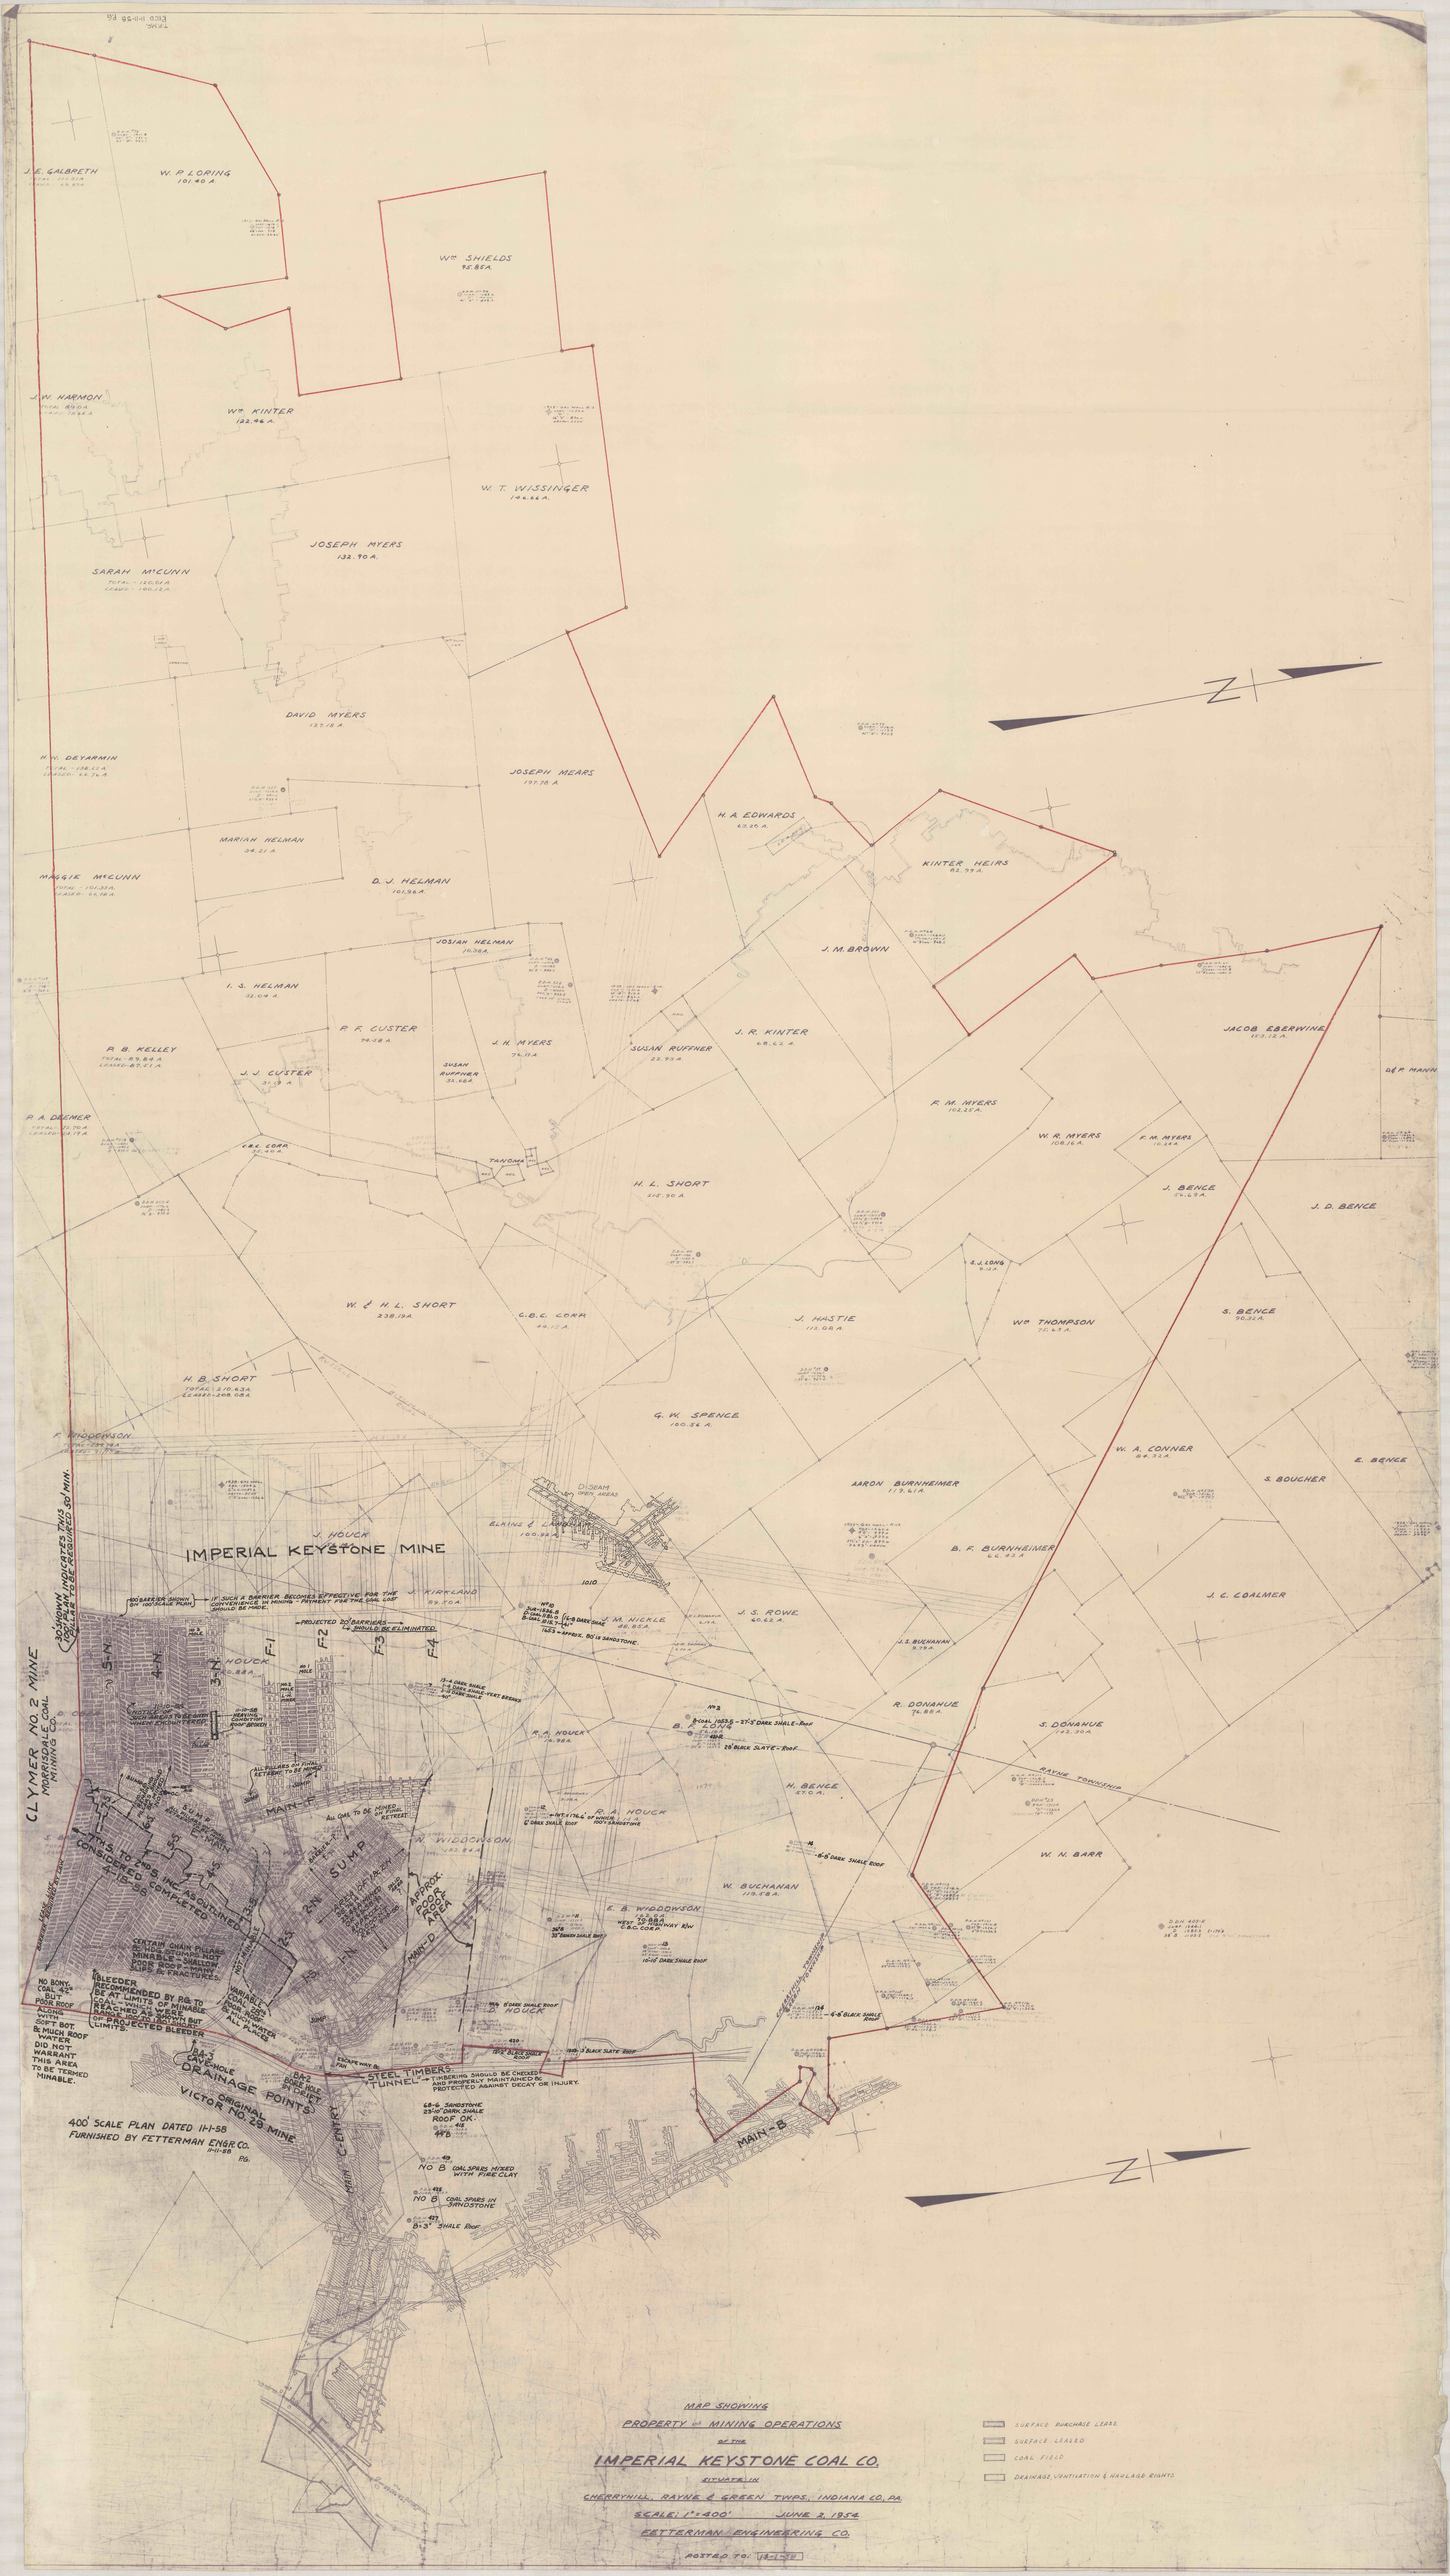
J. E. GALBREATH
W. P. LORING 101.40 A.
Wm SHIELDS 95.85A.
J. W. HARMON
Wm KINTER 122.96 A.
W. T. WISSINGER 146.66 A.
JOSEPH MYERS 132.90 A.
SARAH McCUNN
DAVID MYERS 125.16 A
H. W. DEVARMIN
JOSEPH MEARS 197.16 A
MARIAH HELMAN 38.21 A.
MAGGIE McCUNN
D. J. HELMAN 101.36 A
H. A. EDWARDS 62.40 A.
KINTER HEIRS 82.99 A.
JOSIAH HELMAN 10.36 A.
J. M. BROWN
I. S. HELMAN 32.04 A.
P. F. CUSTER 79.38 A.
J. H. MYERS 74.11 A.
SUSAN RUFFNER 23.93 A.
J. R. KINTER 68.62 A.
JACOB EBERWINE 109.12 A.
P. B. KELLEY
J. J. CUSTER 31.13 A.
SUSAN RUFFNER 31.66 A.
P. A. DREMER
F. M. MYERS 102.25 A.
W. R. MYERS 108.16 A.
F. M. MYERS 10.69 A.
J. BENCE 56.69 A.
J. D. BENCE
H. L. SHORT 215.90 A.
W. & H. L. SHORT 238.19 A.
G. B. C. CORR 98.12 A.
J. HASTIE 112.08 A.
Wm THOMPSON 70.69 A.
S. BENCE 90.32 A.
H. B. SHORT
G. W. SPENCE 100.56 A.
W. A. CONNER 84.32 A.
E. BENCE
S. BOUCHER
AARON BURNHEIMER 119.41 A.
B. F. BURNHEIMER 66.92 A.
J. C. COALMER
J. HOUCK
IMPERIAL KEYSTONE MINE
J. KIRKLAND 89.70 A.
J. M. NICKLE 88.85 A.
J. S. ROWE 60.62 A.
R. DONAHUE 74.86 A.
S. DONAHUE 72.90 A.
R. A. HOUCK 74.98 A.
H. BENCE 67.0 A.
W. H. BARR
W. BUCHANAN 113.68 A.
E. B. WIGDOWSON
CLYMER NO. 2 MINE
MORRISDALE COAL MINING CO.
MAIN-F
MAIN-D
MAIN-B
SUMP
F1
F2
F3
F4
RAYNE TOWNSHIP
CERTAIN CHAIN PILLARS IN THIS AREA WHO NOT MINABLE WHO ROOF SHALLOW ROOF & FRACTURES.
BLEEDER RECOMMENDED BY RG. TO BE AT LIMITS OF MINABLE AREA WHERE REACHED AS WERE BARGE JOBS WITH BHT UP PROJECTED BLEEDER LIMITS.
NO BONY. COAL 42" & SLIT POOR ROOF ALONG WITH 3½" BOT. & MUCH ROOF WATER DID NOT WARRANT THIS AREA TO BE TERMED MINABLE.
STEEL TIMBERS TUNNEL
DRAINAGE POINTS
ORIGINAL VICTOR NO. 29 MINE
400' SCALE PLAN DATED 11-1-58 FURNISHED BY FETTERMAN ENGR. CO.
MAP SHOWING
PROPERTY AND MINING OPERATIONS
OF THE
IMPERIAL KEYSTONE COAL CO.
SITUATE IN
CHERRYHILL, RAYNE & GREEN TWPS., INDIANA CO. PA.
SCALE: 1" = 400'
JUNE 2, 1954
FETTERMAN ENGINEERING CO.
POSTED TO:
SURFACE PURCHASE LEASE
SURFACE LEASED
COAL FIELD
DRAINAGE, VENTILATION & HAULAGE RIGHTS