

LANDS OF THE ALTOONA COAL AND COKE CO.

LOGAN TOWNSHIP, BLAIR COUNTY AND GALLITZIN TOWNSHIP, GAMBIA COUNTY, PENNA.


SCALE: 1" = 400'

JOS. S. SULLIVAN & CO.
ENGINEERS
ALTOONA, PENNA.

MINING WORKINGS SHOWN TO DATE OF SEPTEMBER 1931

DISCLAIMER: This map is provided as a courtesy to the Pennsylvania Bureau of Deep Mine Safety by American Premier Underwriters, Inc. (The Penn. Central Railroad Corporation) and its subsidiary United Railroad Corp., which own or control, but do not operate, the coal mines depicted herein.

American Premier Underwriters, Inc. and United Railroad Corp. disclaim any representation or duty to any person as to the accuracy or completeness of the map or its contents for any purpose except the purpose stated herein. Any person who uses this map for any purpose other than the purpose stated herein does so at his own risk and agrees to hold American Premier Underwriters, Inc., United Railroad Corp. and their respective officers, directors, agents, employees and employees harmless from damage or liability arising from its use.

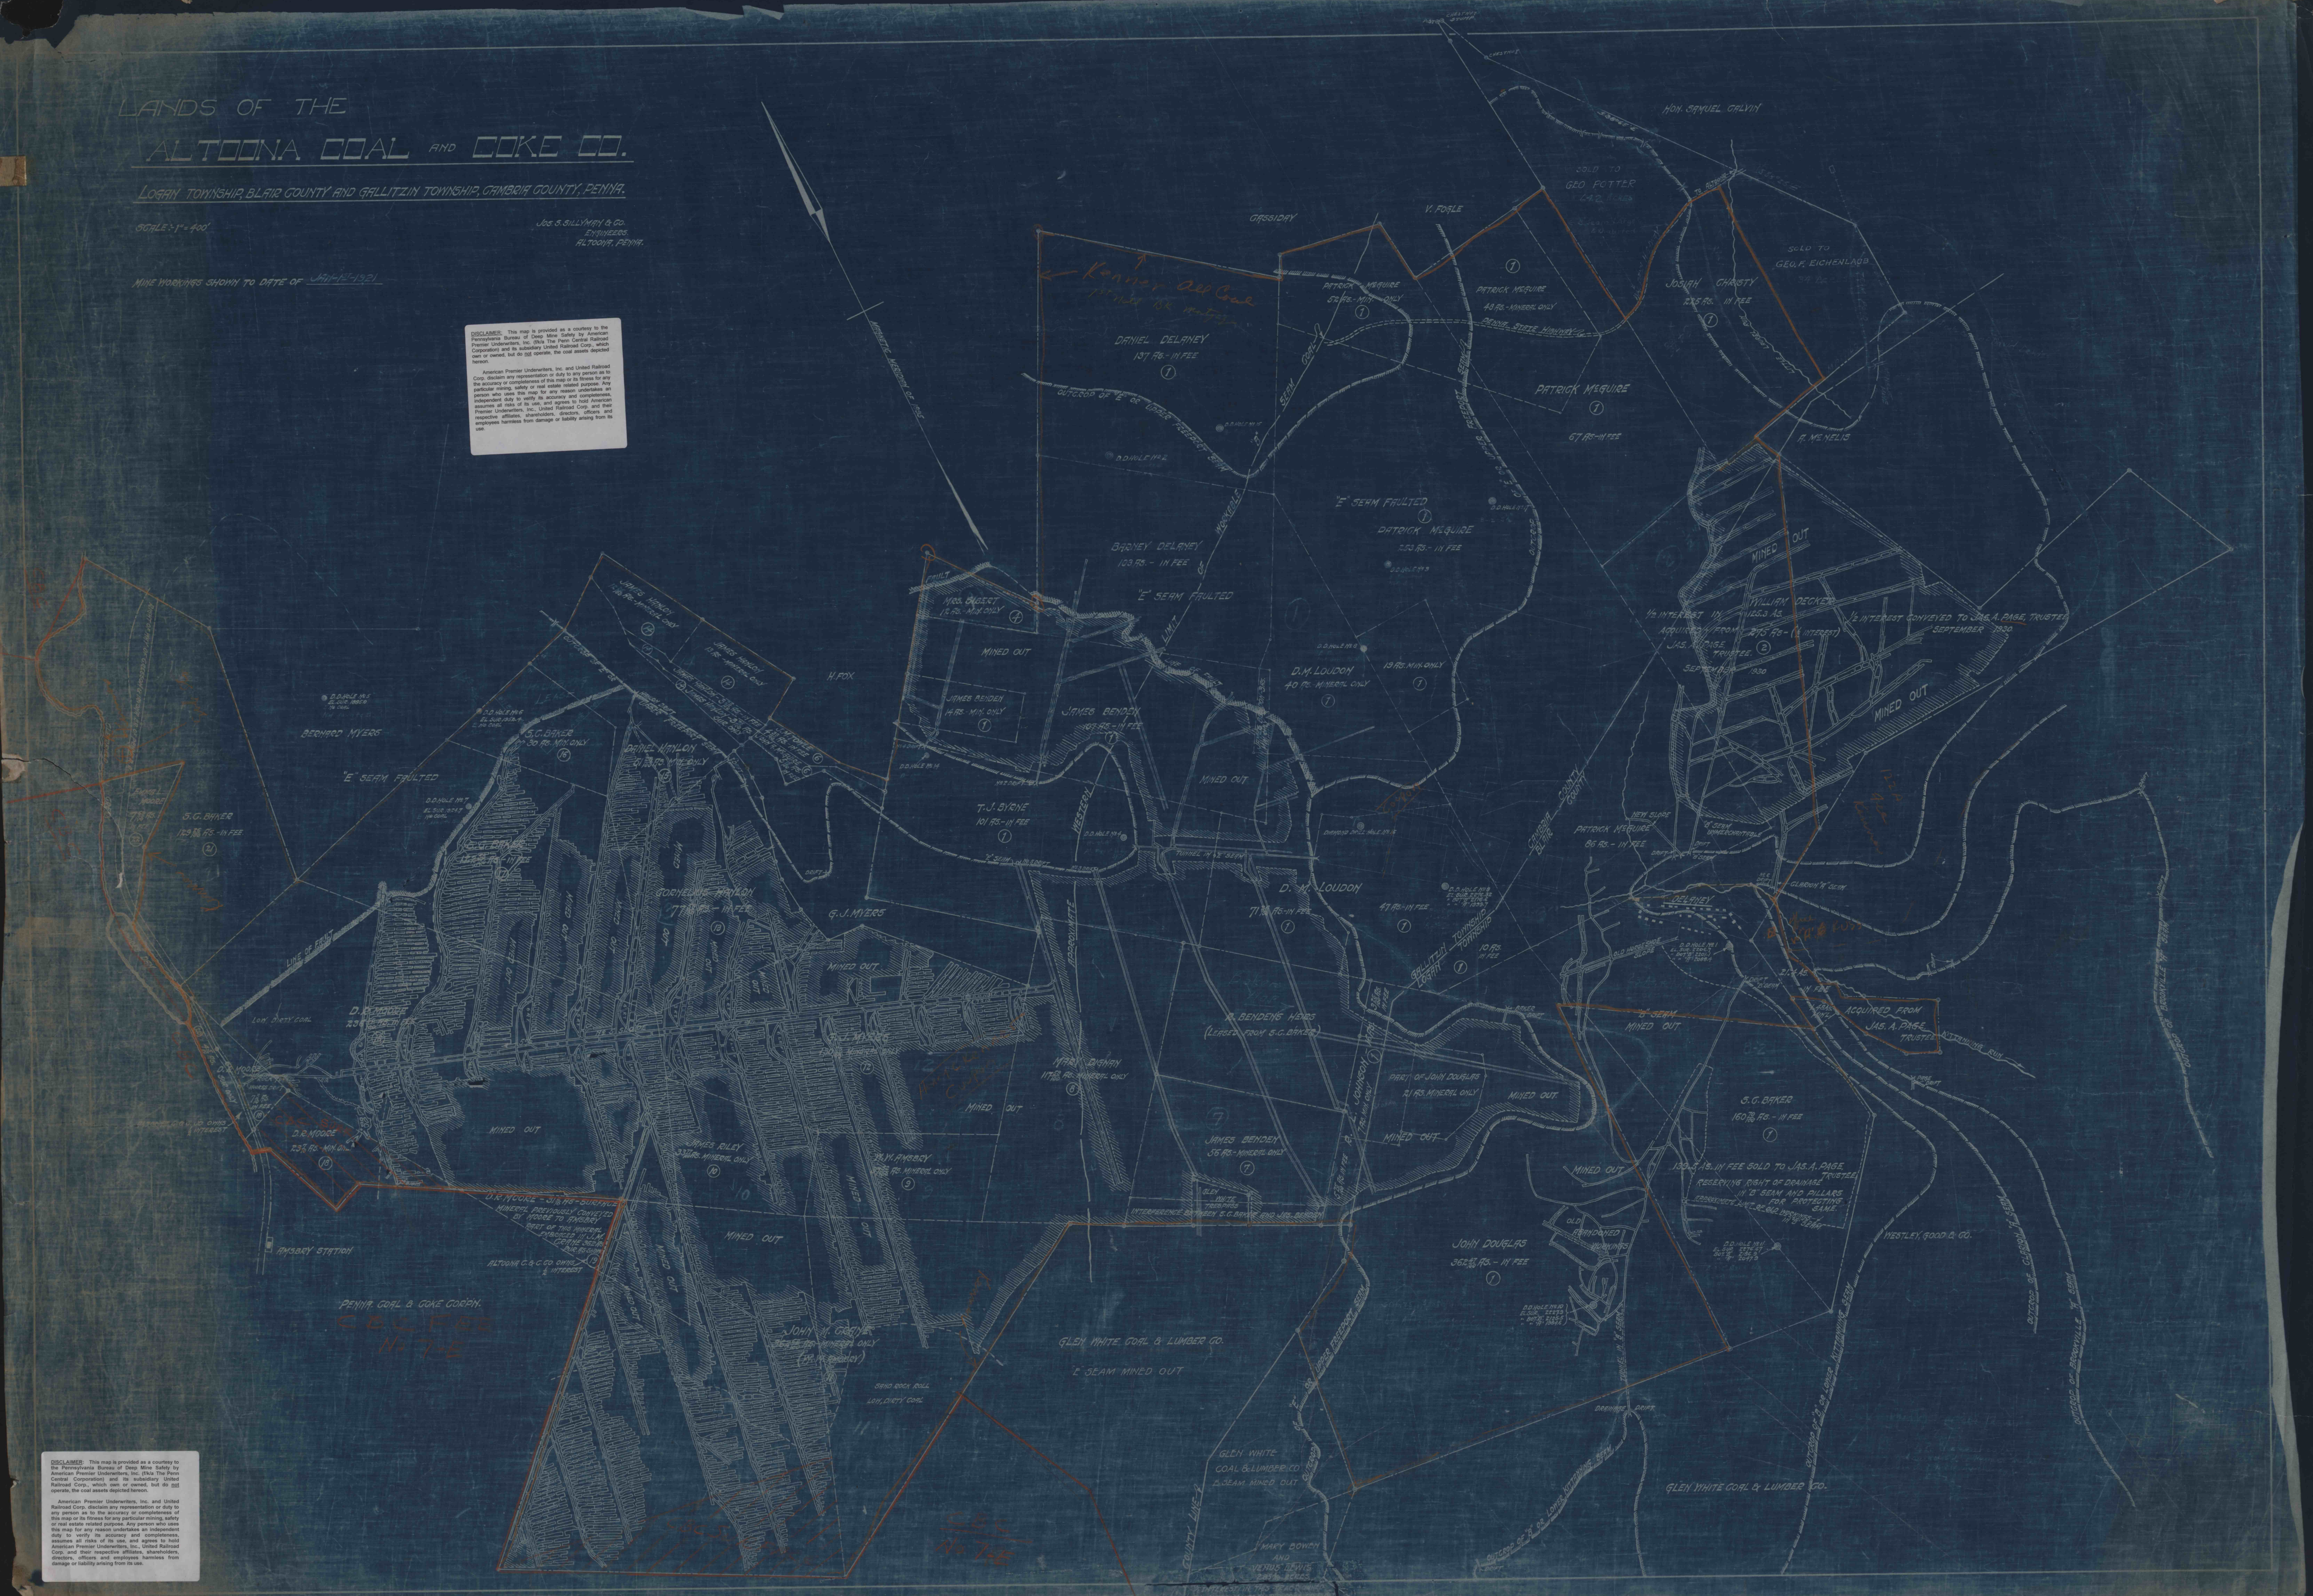

DISCLAIMER: This map is provided as a courtesy to the Pennsylvania Bureau of Deep Mine Safety by American Premier Underwriters, Inc. (The Penn. Central Railroad Corporation) and its subsidiary United Railroad Corp., which own or control, but do not operate, the coal mines depicted herein.

American Premier Underwriters, Inc. and United Railroad Corp. disclaim any representation or duty to any person as to the accuracy or completeness of the map or its contents for any purpose except the purpose stated herein. Any person who uses this map for any purpose other than the purpose stated herein does so at his own risk and agrees to hold American Premier Underwriters, Inc., United Railroad Corp. and their respective officers, directors, agents, employees and employees harmless from damage or liability arising from its use.