



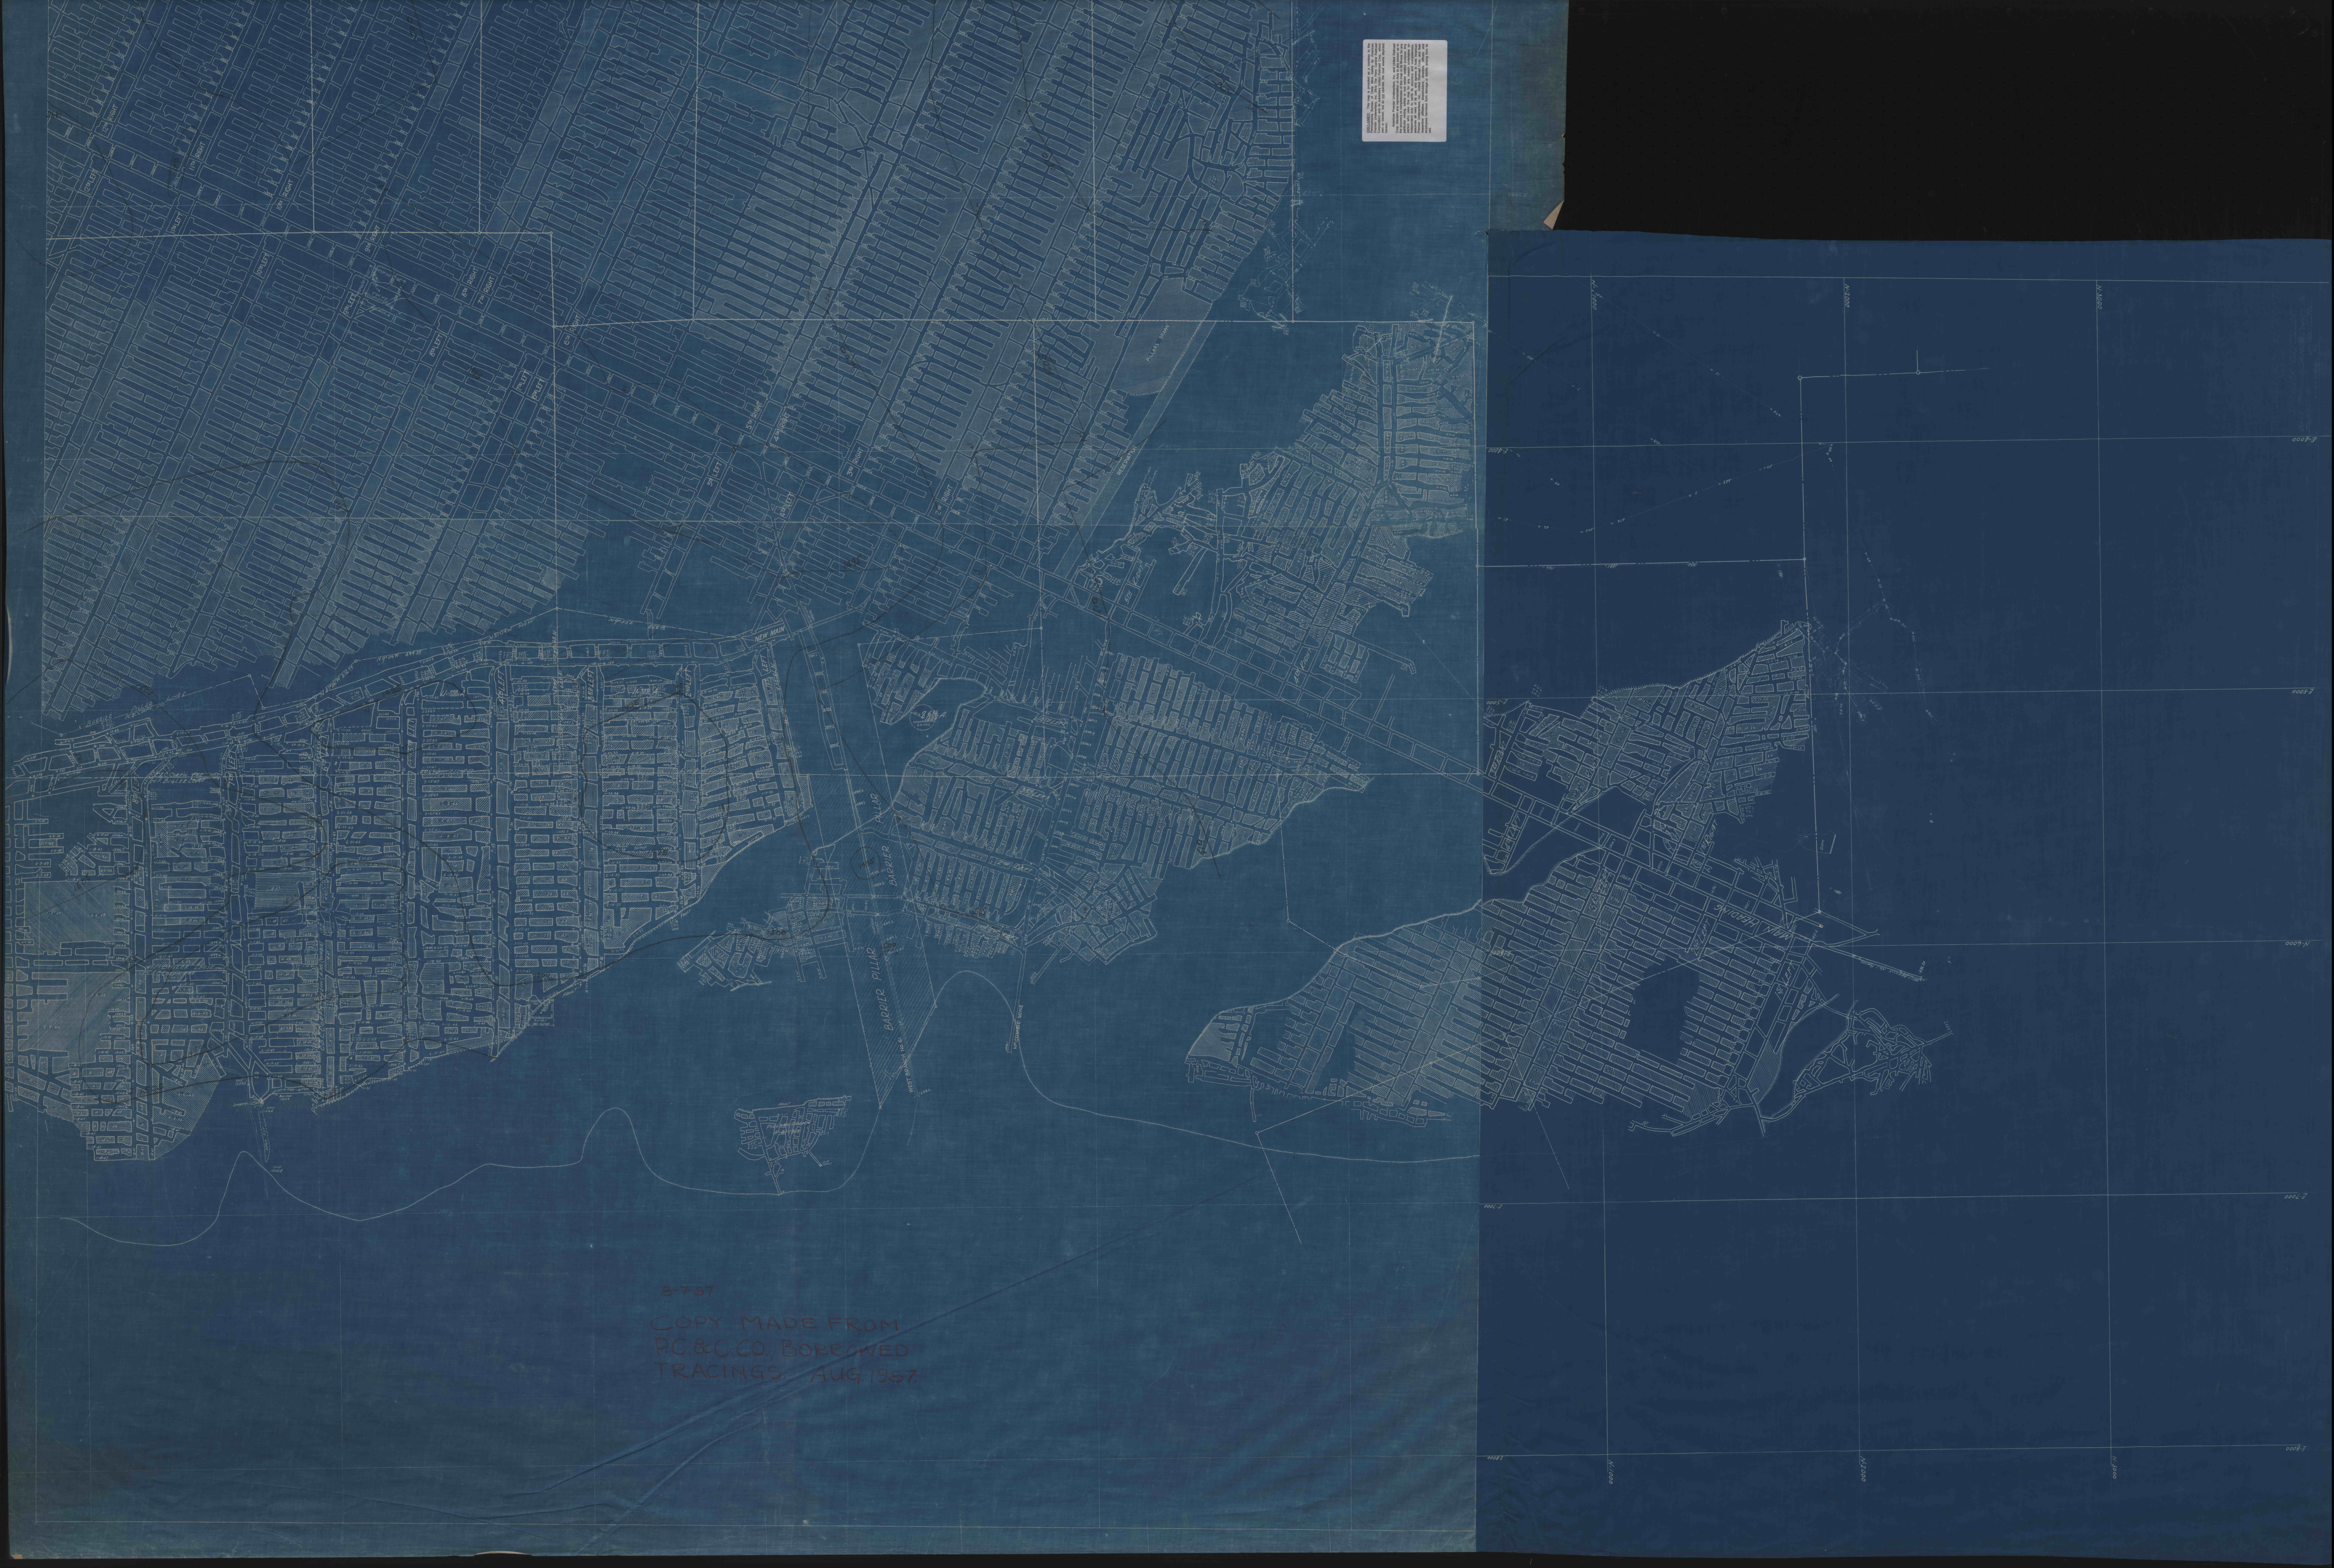

B-787
COPY MADE FROM
PC&C CO. BORROWED
TRACINGS AUG 1957