


DISCLAIMER: This map is provided as a courtesy to the Pennsylvania Bureau of Deep Mine Safety by American Premier Underwriters, Inc. (Via The Penn Central Railroad Corporation) and its subsidiary United Railroad Corp., which own or owned, but do not operate, the coal assets depicted herein.

American Premier Underwriters, Inc. and United Railroad Corp. disclaim any representation or duty to any person as to the accuracy or completeness of this map or its fitness for any particular mining, safety or real estate related purpose. Any person who uses this map for any reason undertakes an independent duty to verify its accuracy and completeness, assumes all risks of its use, and agrees to hold American Premier Underwriters, Inc., United Railroad Corp. and their respective affiliates, shareholders, directors, officers and employees harmless from damage or liability arising from its use.

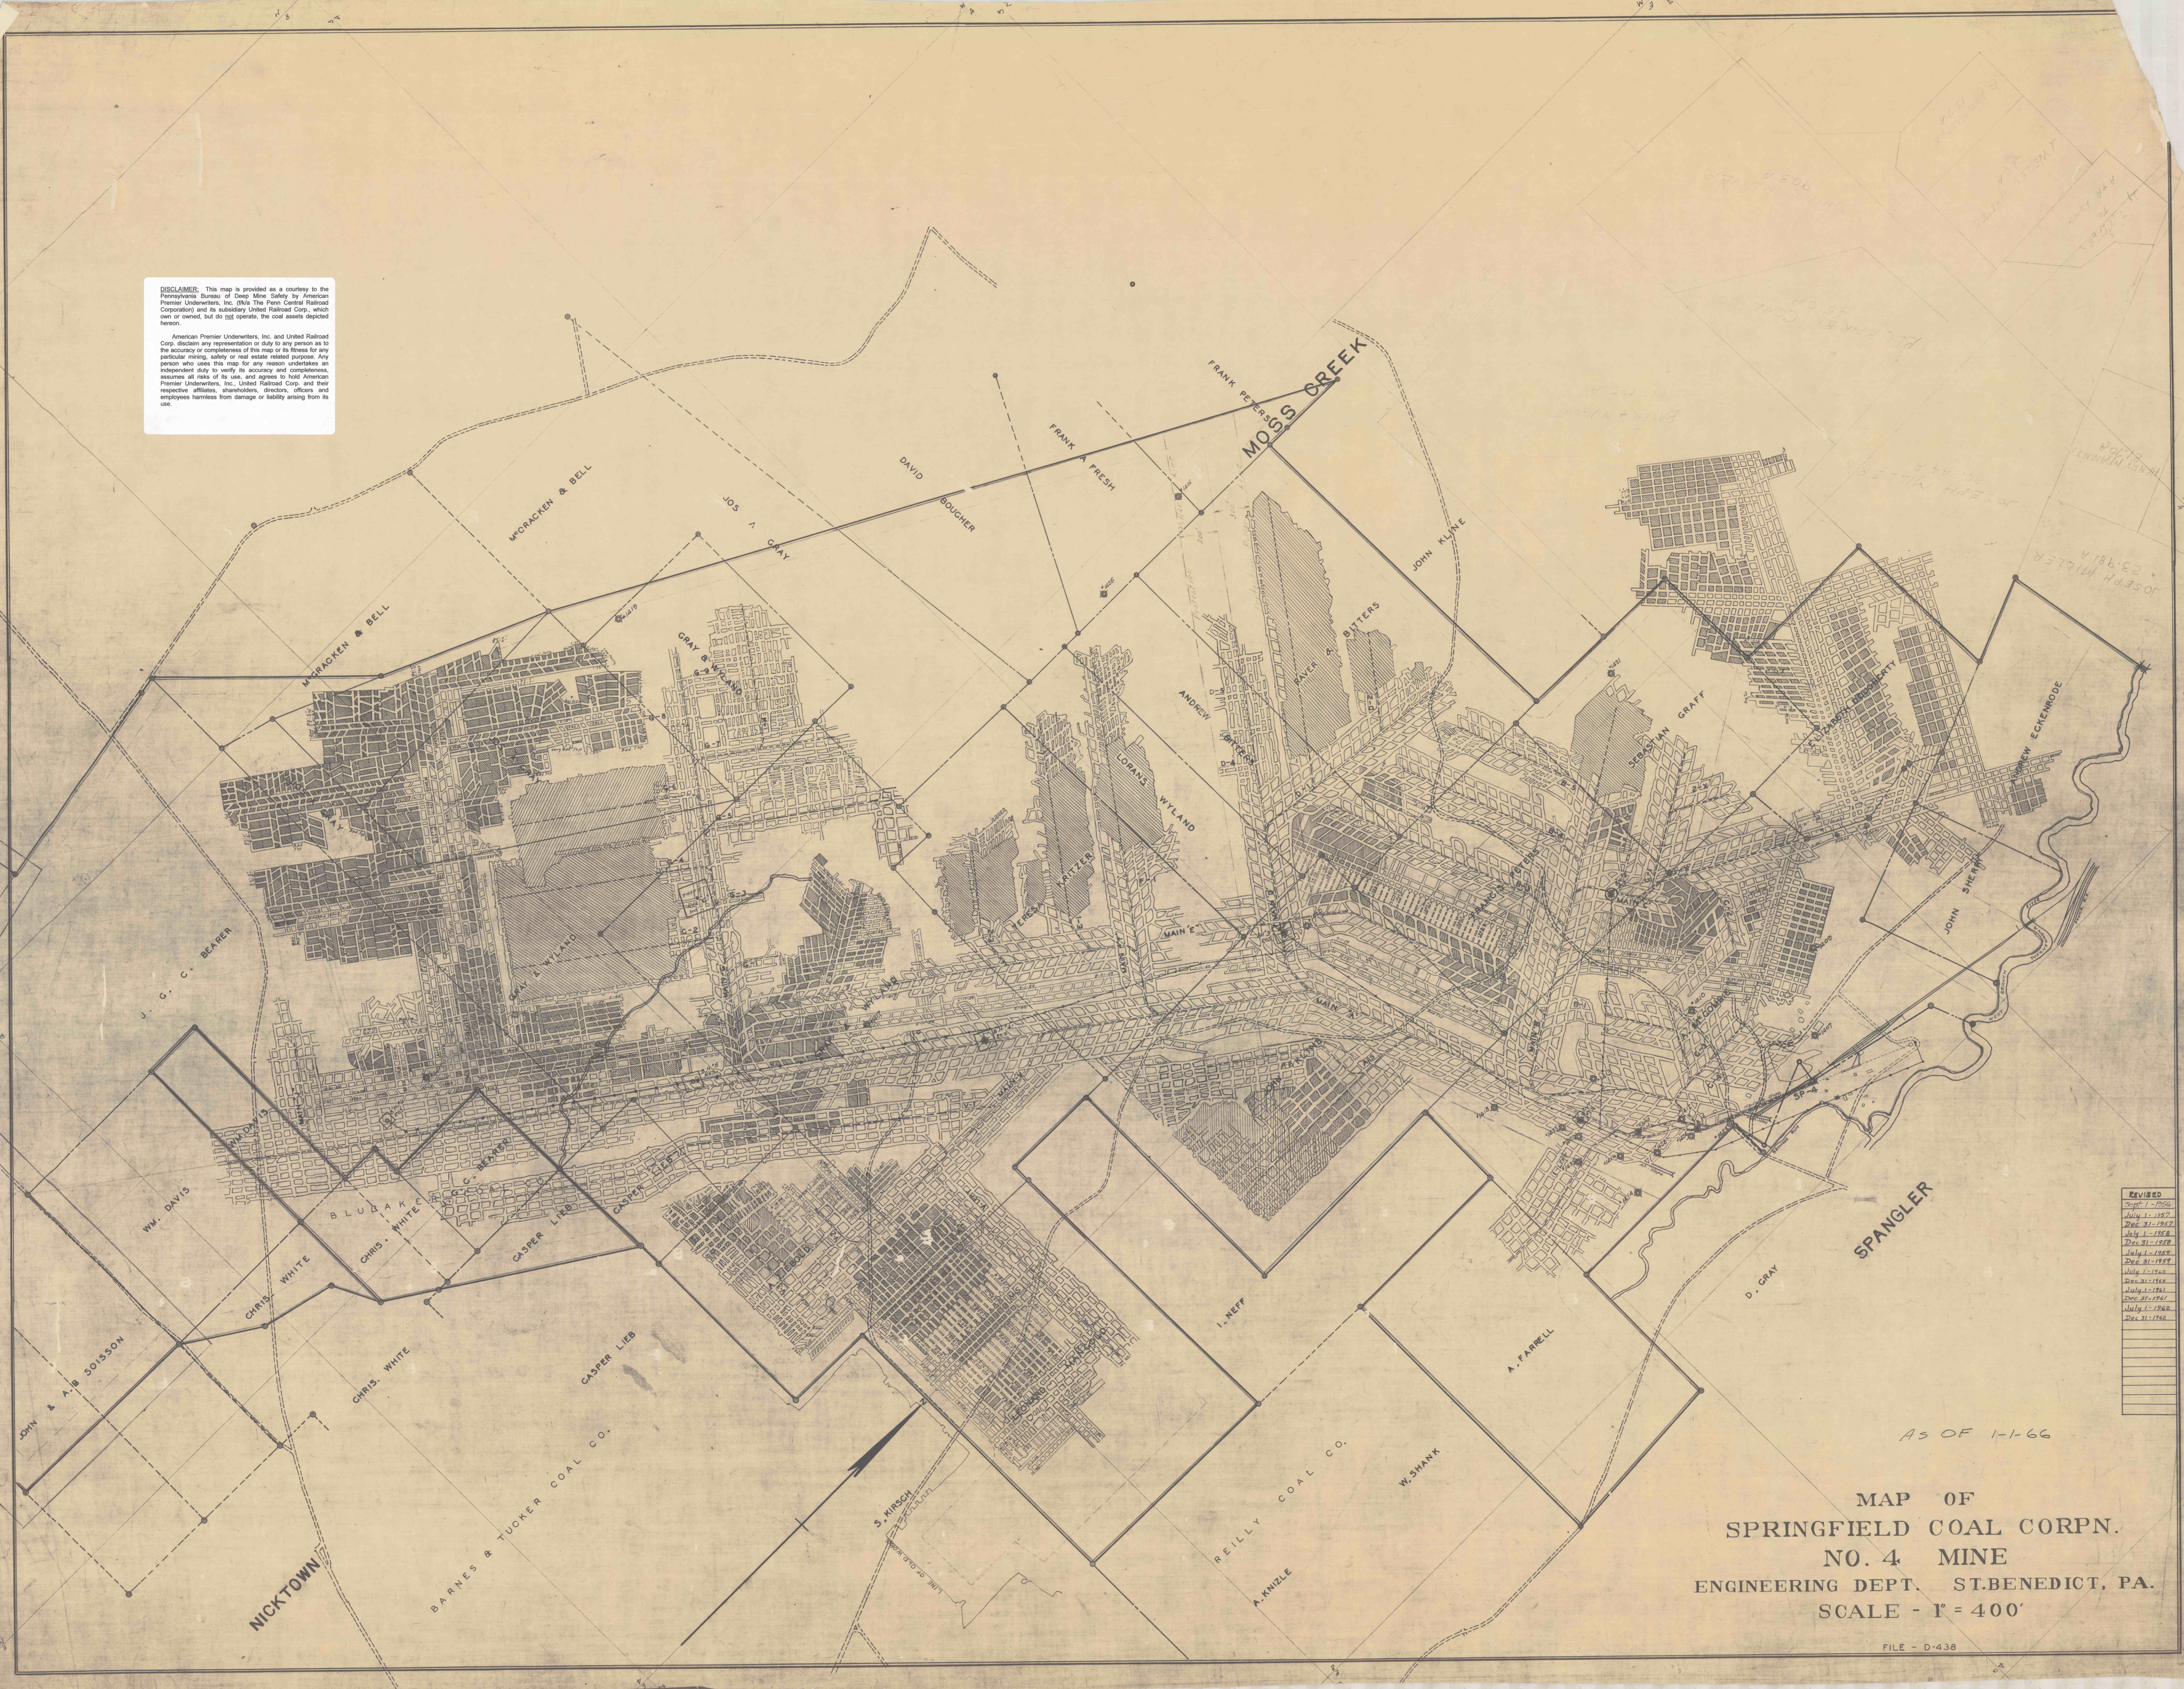

REVISED
Sept 1 - 1956
July 1 - 1957
Dec 31 - 1957
July 1 - 1958
Dec 31 - 1958
July 1 - 1959
Dec 31 - 1959
July 1 - 1960
Dec 31 - 1960
July 1 - 1961
Dec 31 - 1961
July 1 - 1962
Dec 31 - 1962

AS OF 1-1-66

MAP OF
 SPRINGFIELD COAL CORPN.
 NO. 4 MINE
 ENGINEERING DEPT. ST. BENEDICT, PA.
 SCALE - 1" = 400'