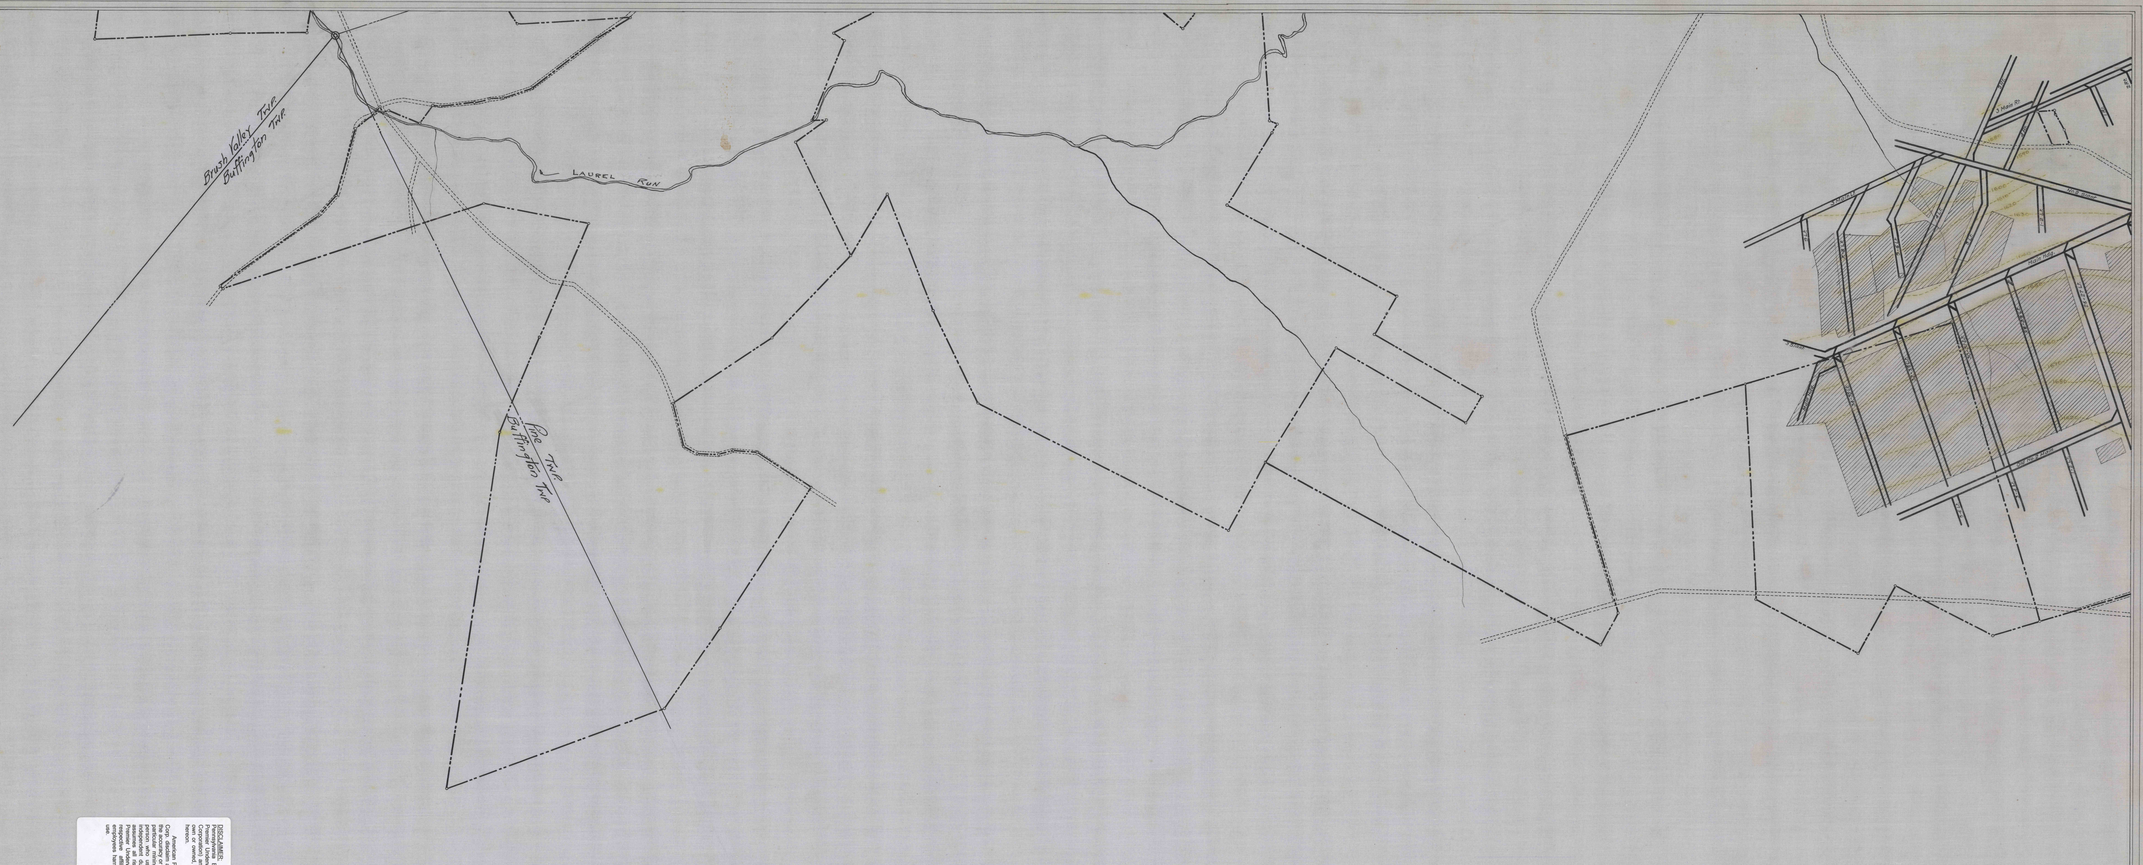

DISCLAIMER: The map is provided as a courtesy to the Pioneer Underwriters, Inc. (PUI). The Penn Central Railroad Company and its subsidiaries (PC) and PUI assume no liability for errors or omitted, but do not warrant the accuracy of such information.

American Premier Underwriters, Inc. and United Railroad Corp. disclaim any representation or duty to any person as to the accuracy or completeness of the information contained in this map. Any person who uses this map for any reason assumes all risks of its use, and agrees to hold American Premier Underwriters, Inc. and United Railroad Corp. and their respective affiliates, shareholders, directors, officers and employees harmless from damage or liability arising from its use.

TRACING No. 3 - SHOWING MINE WORK
1" = 400'.
BOTTOM