


11
 12
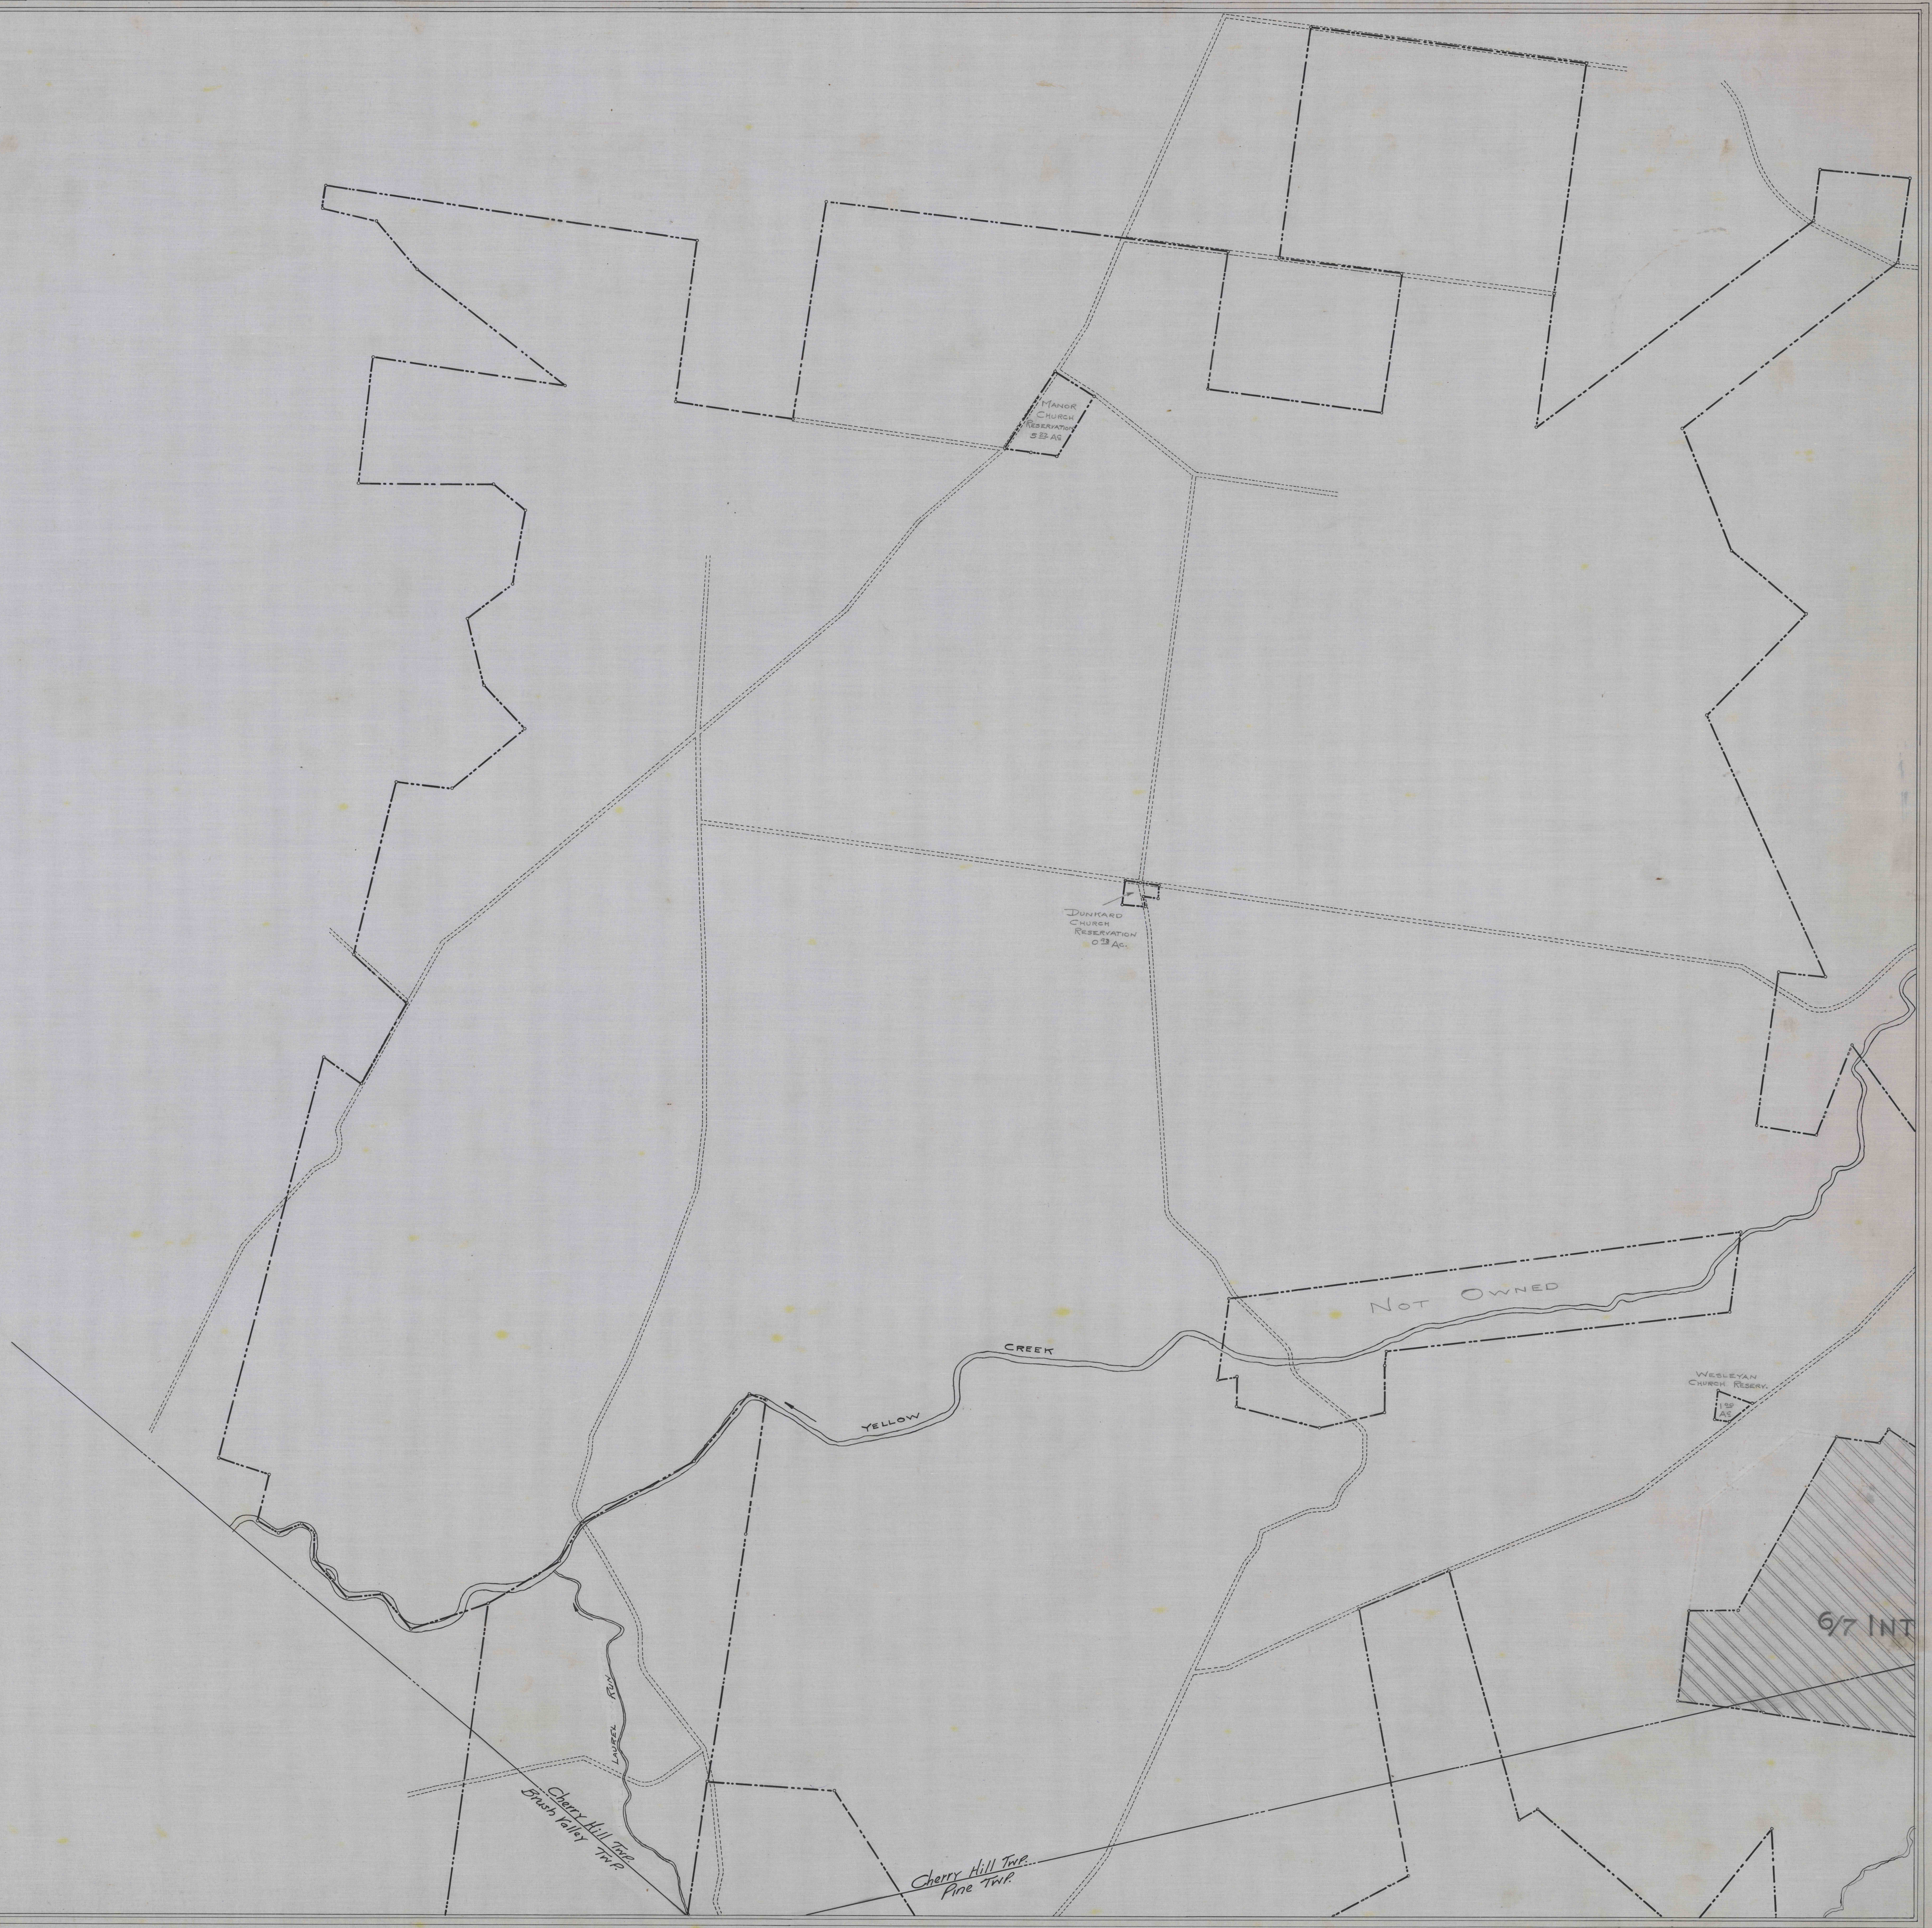

TRACING No. 7 - SHOWING MINE WORK.
 1" = 400'
 BOTTOM.