



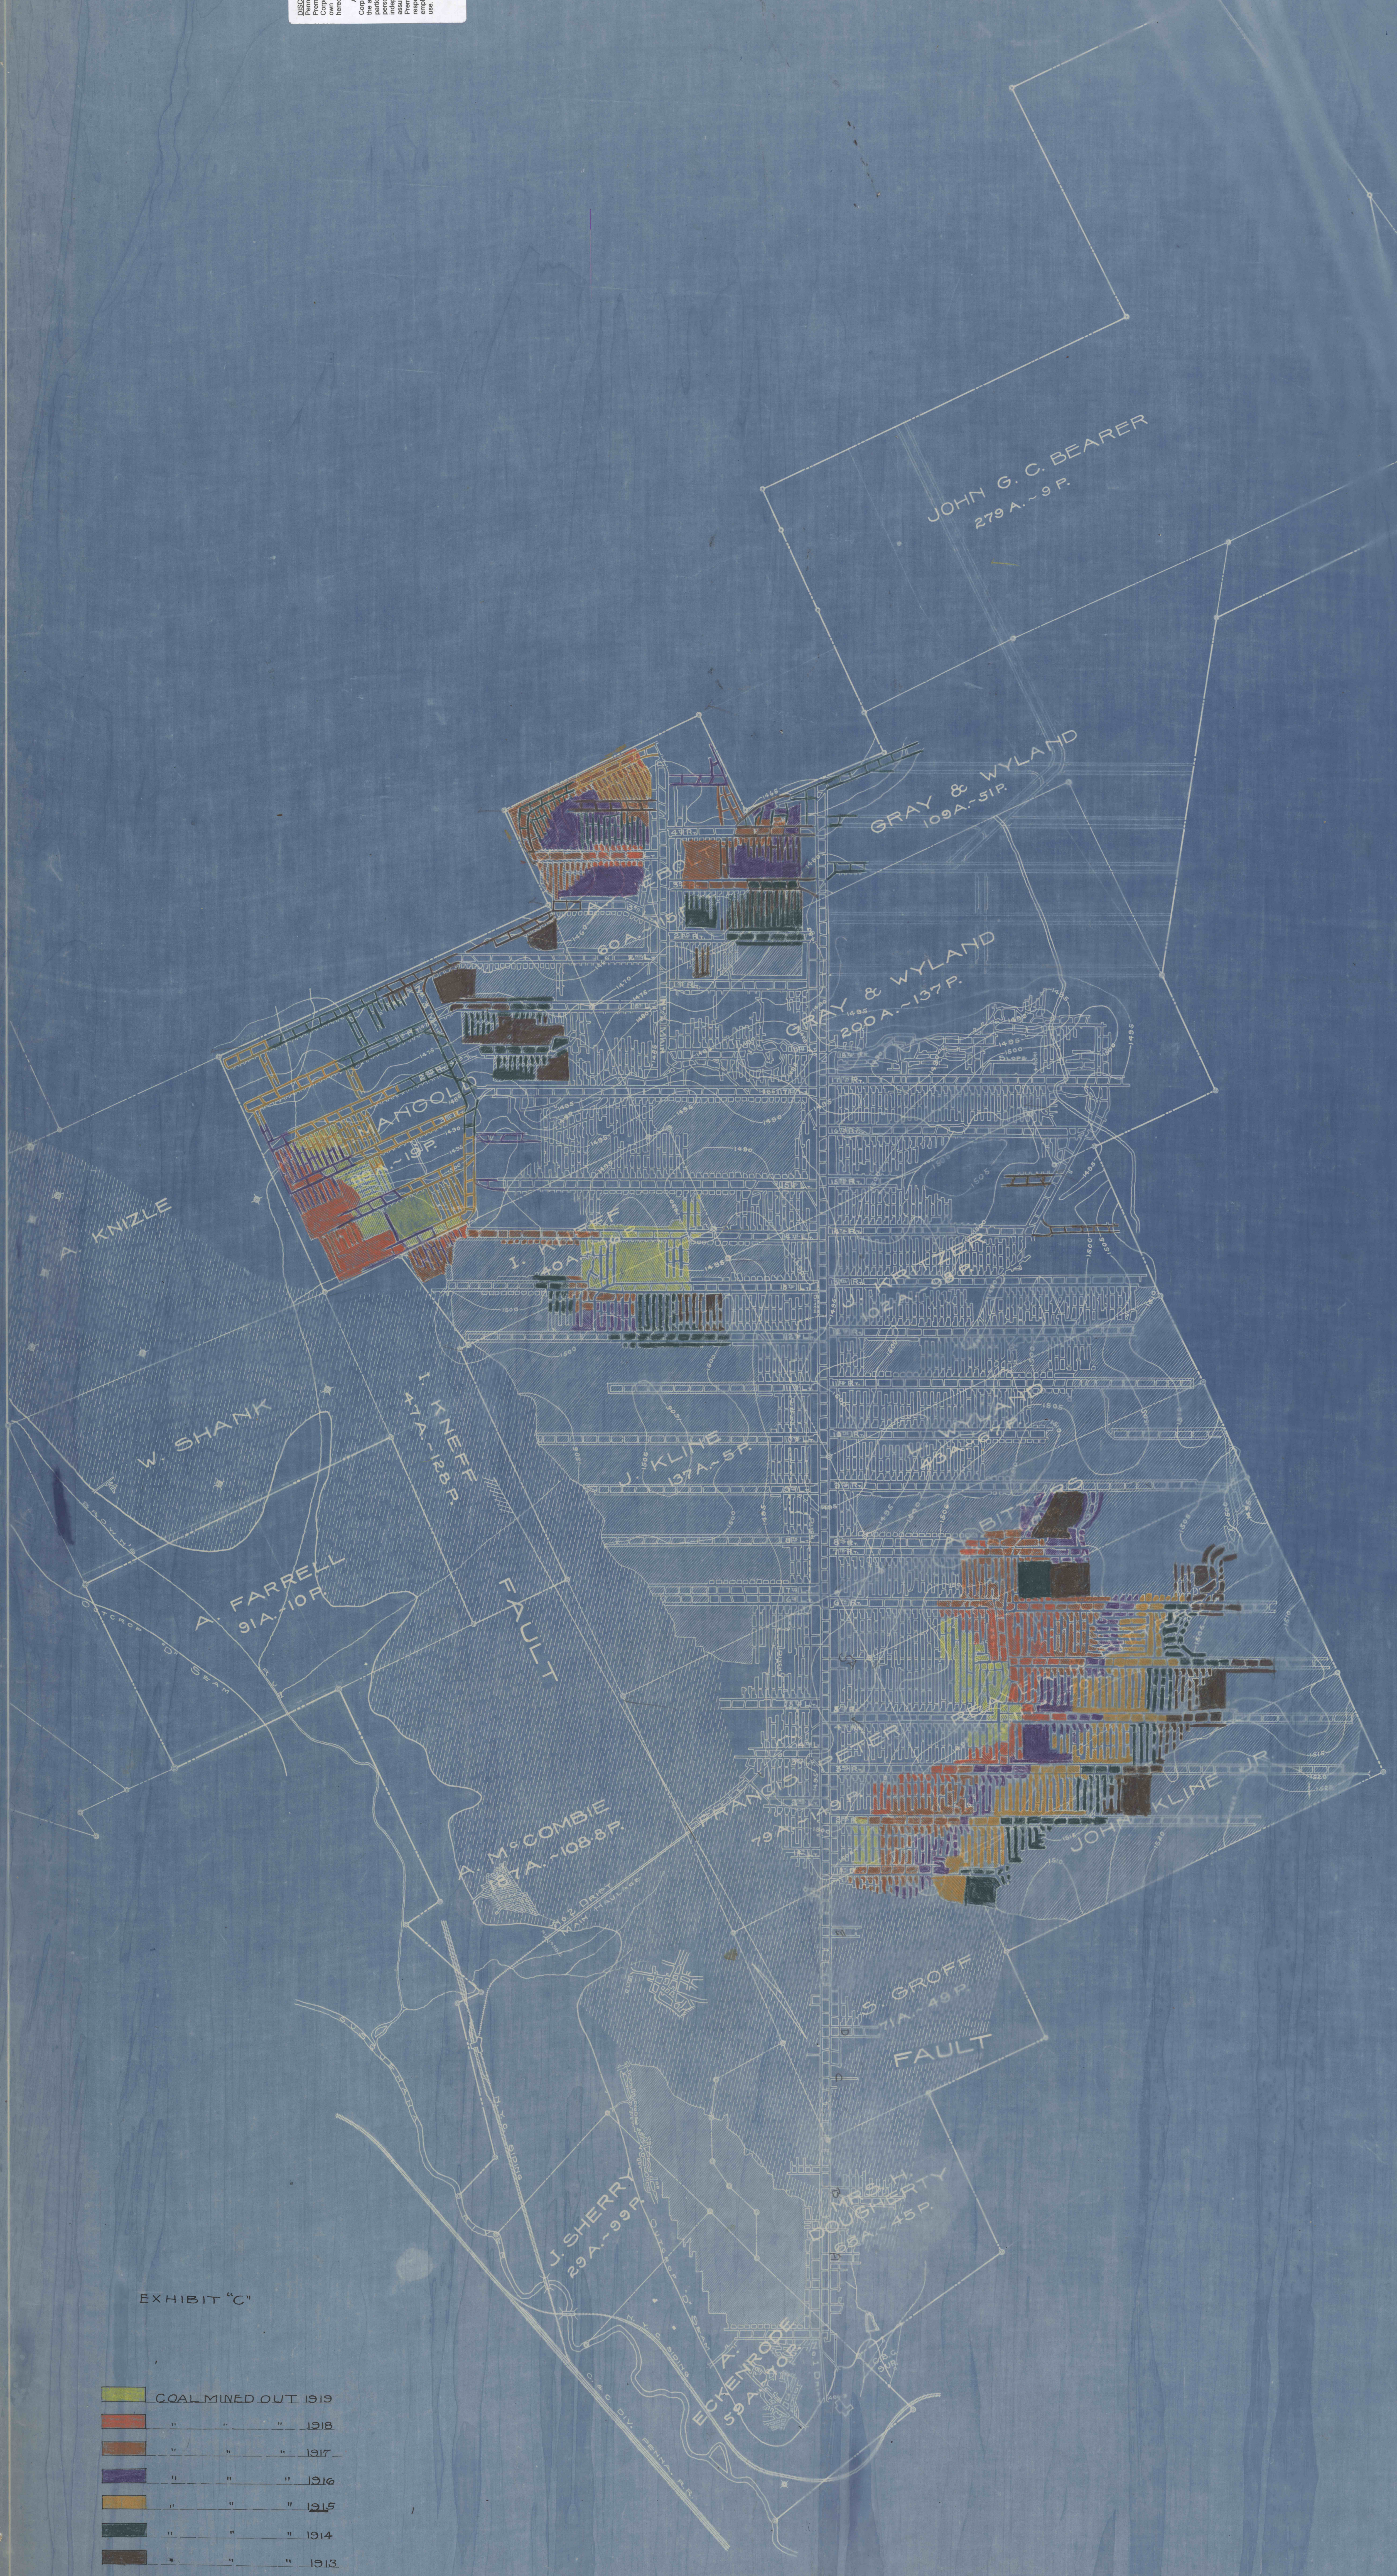


EXHIBIT "C"

Orange	" " " 1918
Red	" " " 1917
Purple	" " " 1916
Yellow	" " " 1915
Dark Green	" " " 1914
Black	" " " 1913

WEST BRANCH MINE  
 OF THE  
 CLEARFIELD BITUMINOUS COAL CORP'N  
 BARR TWP, CAMBRIA CO, PENNA.  
 SCALE 1"=400'  
 MAY, 1916  
 R.M.H.  
 DICKSON