




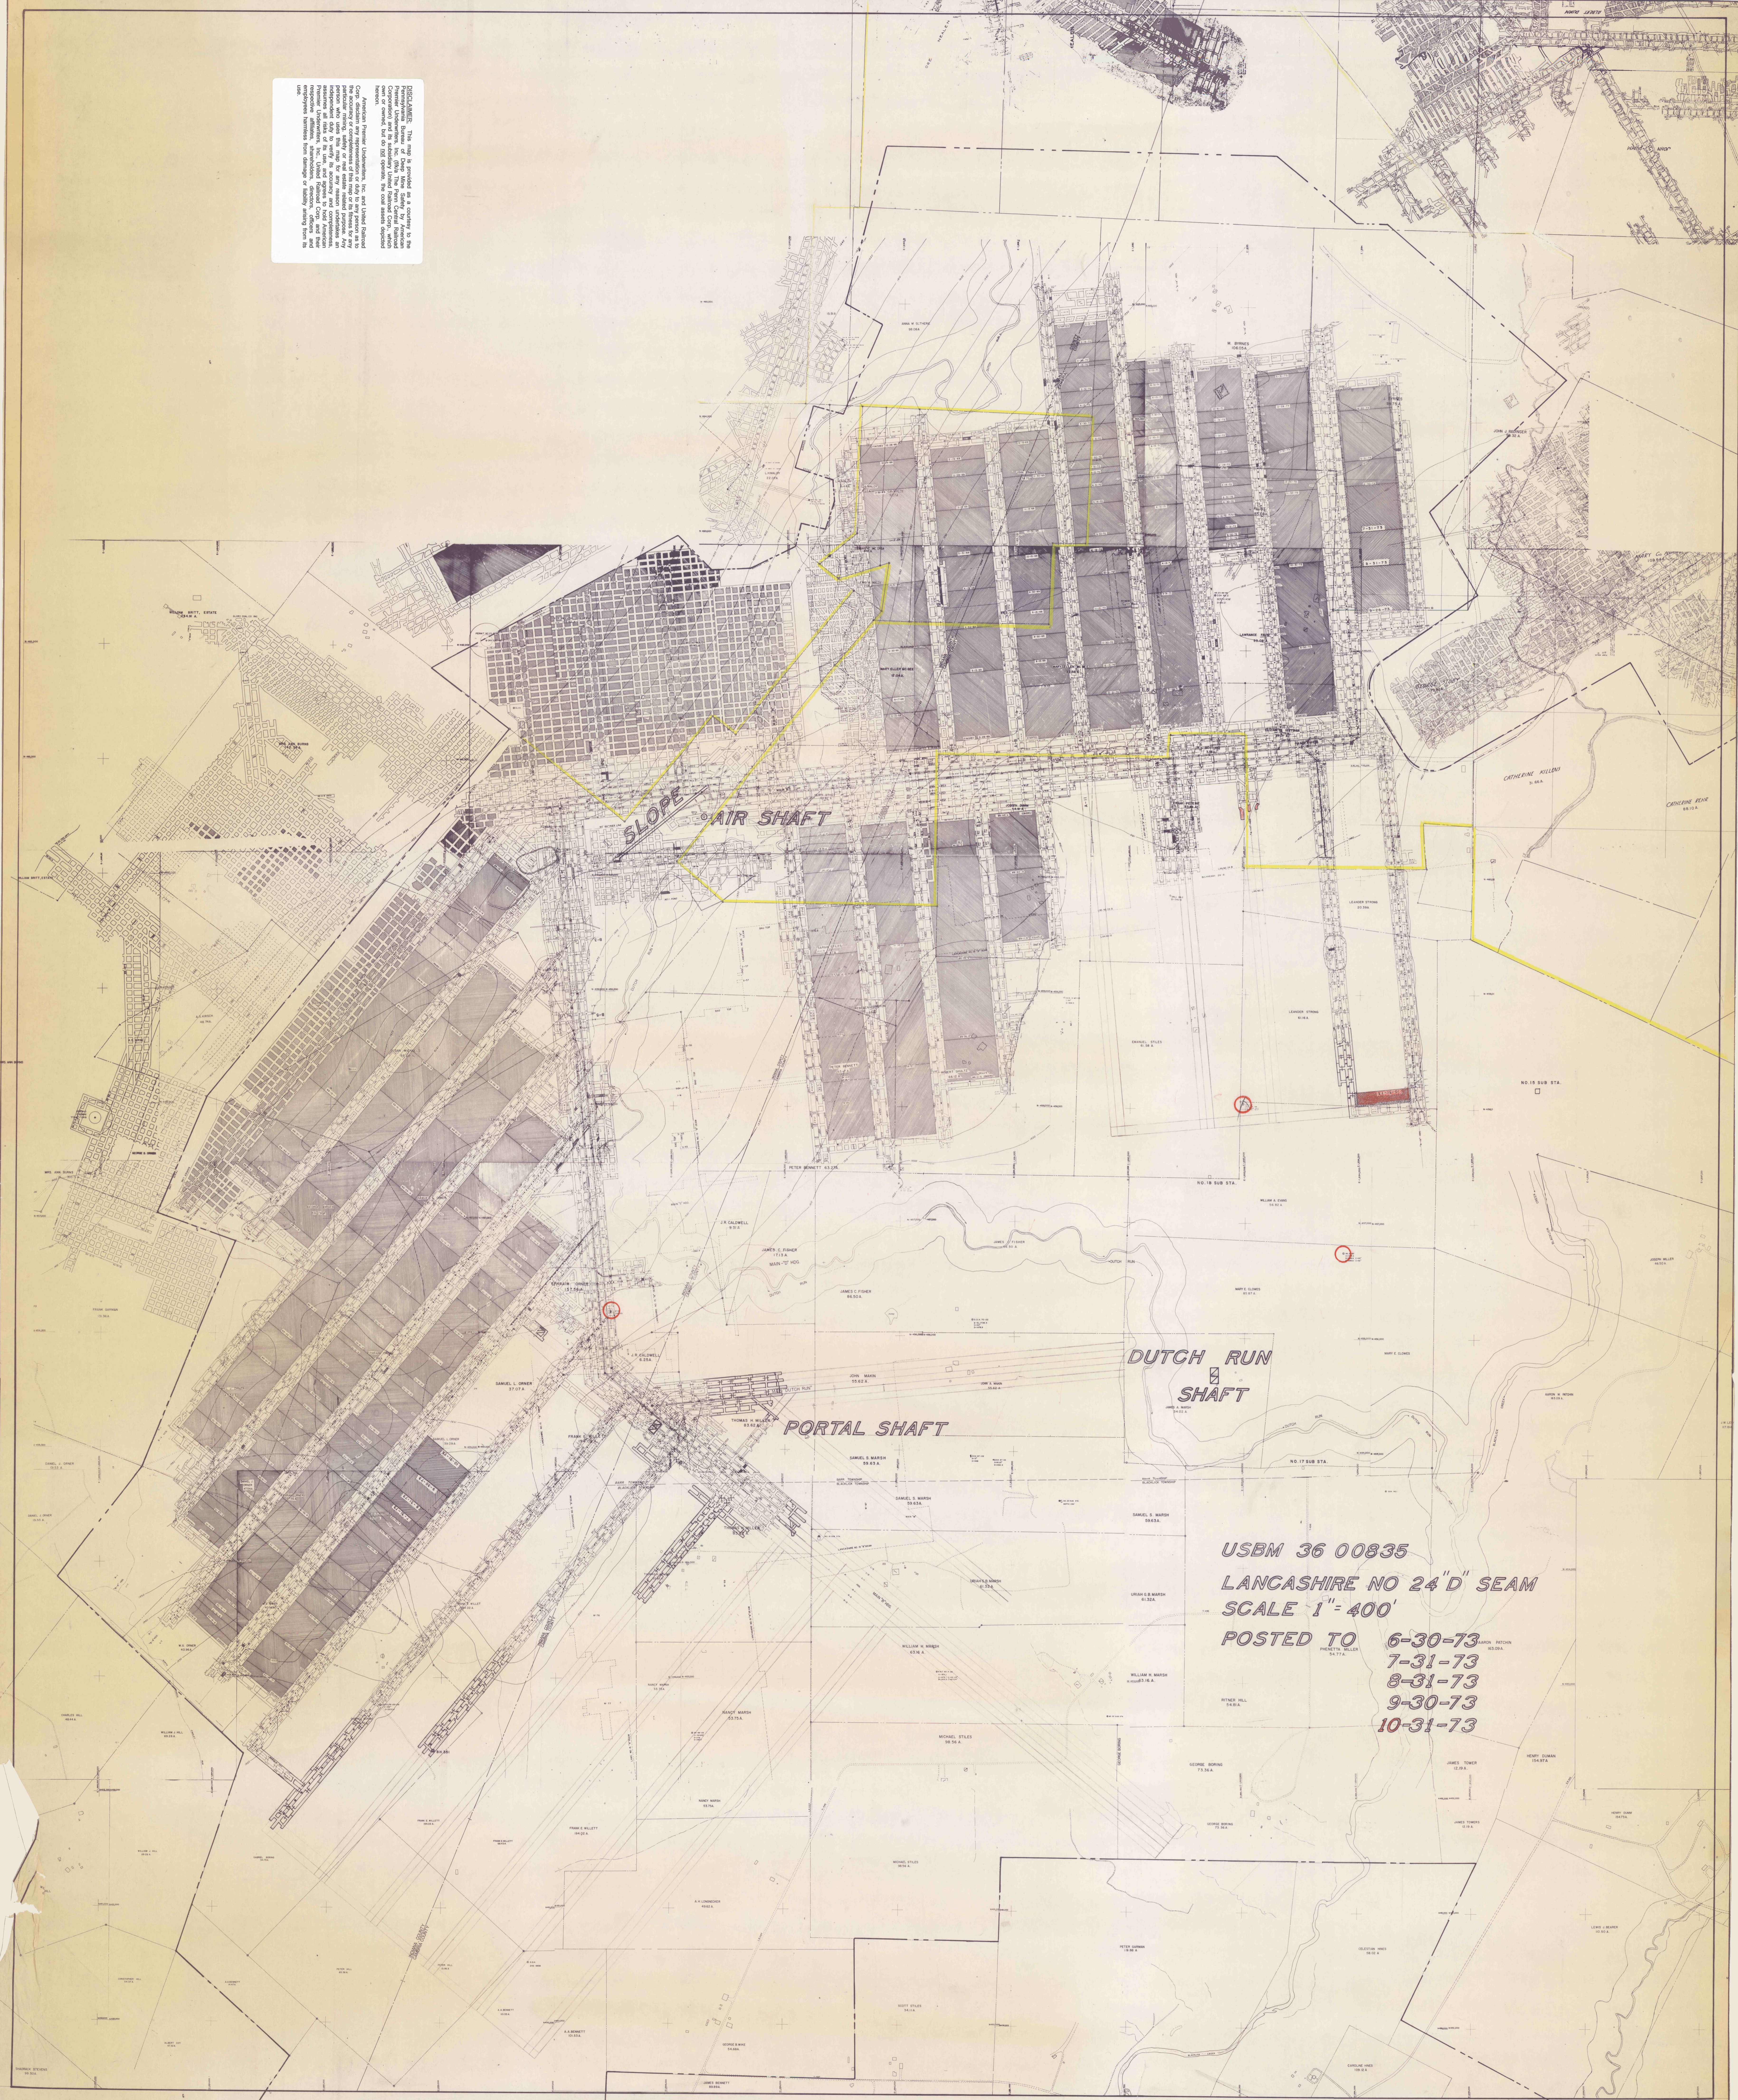

USBM 36 00835
 LANCASHIRE NO 24 "D" SEAM
 SCALE 1" = 400'
 POSTED TO
 6-30-73
 7-31-73
 8-31-73
 9-30-73
 10-31-73