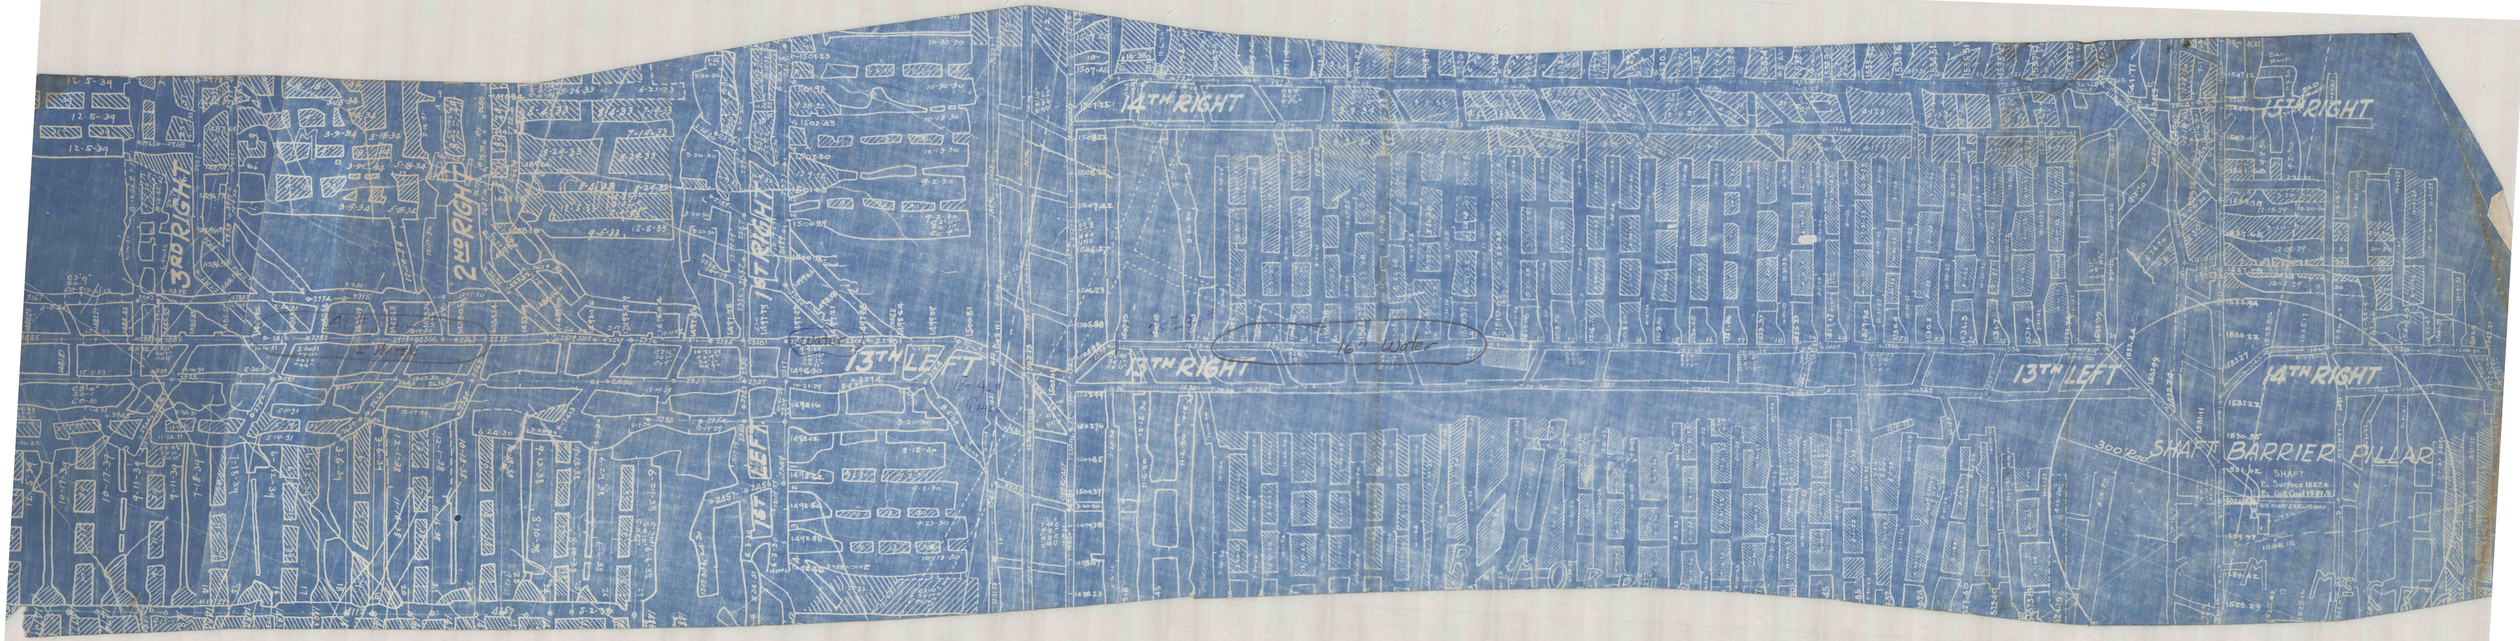
3RD RIGHT
2ND RIGHT
1ST RIGHT
1ST LEFT
13TH LEFT
14TH RIGHT
13TH RIGHT
13TH LEFT
14TH RIGHT
15TH RIGHT
16" Water
12" Water
300' Barrier
SHAFT
BARRIER PILLAR
SHAFT
EL. Surface 1827.6
EL. Top Coal 1792.9
BOREHOLE