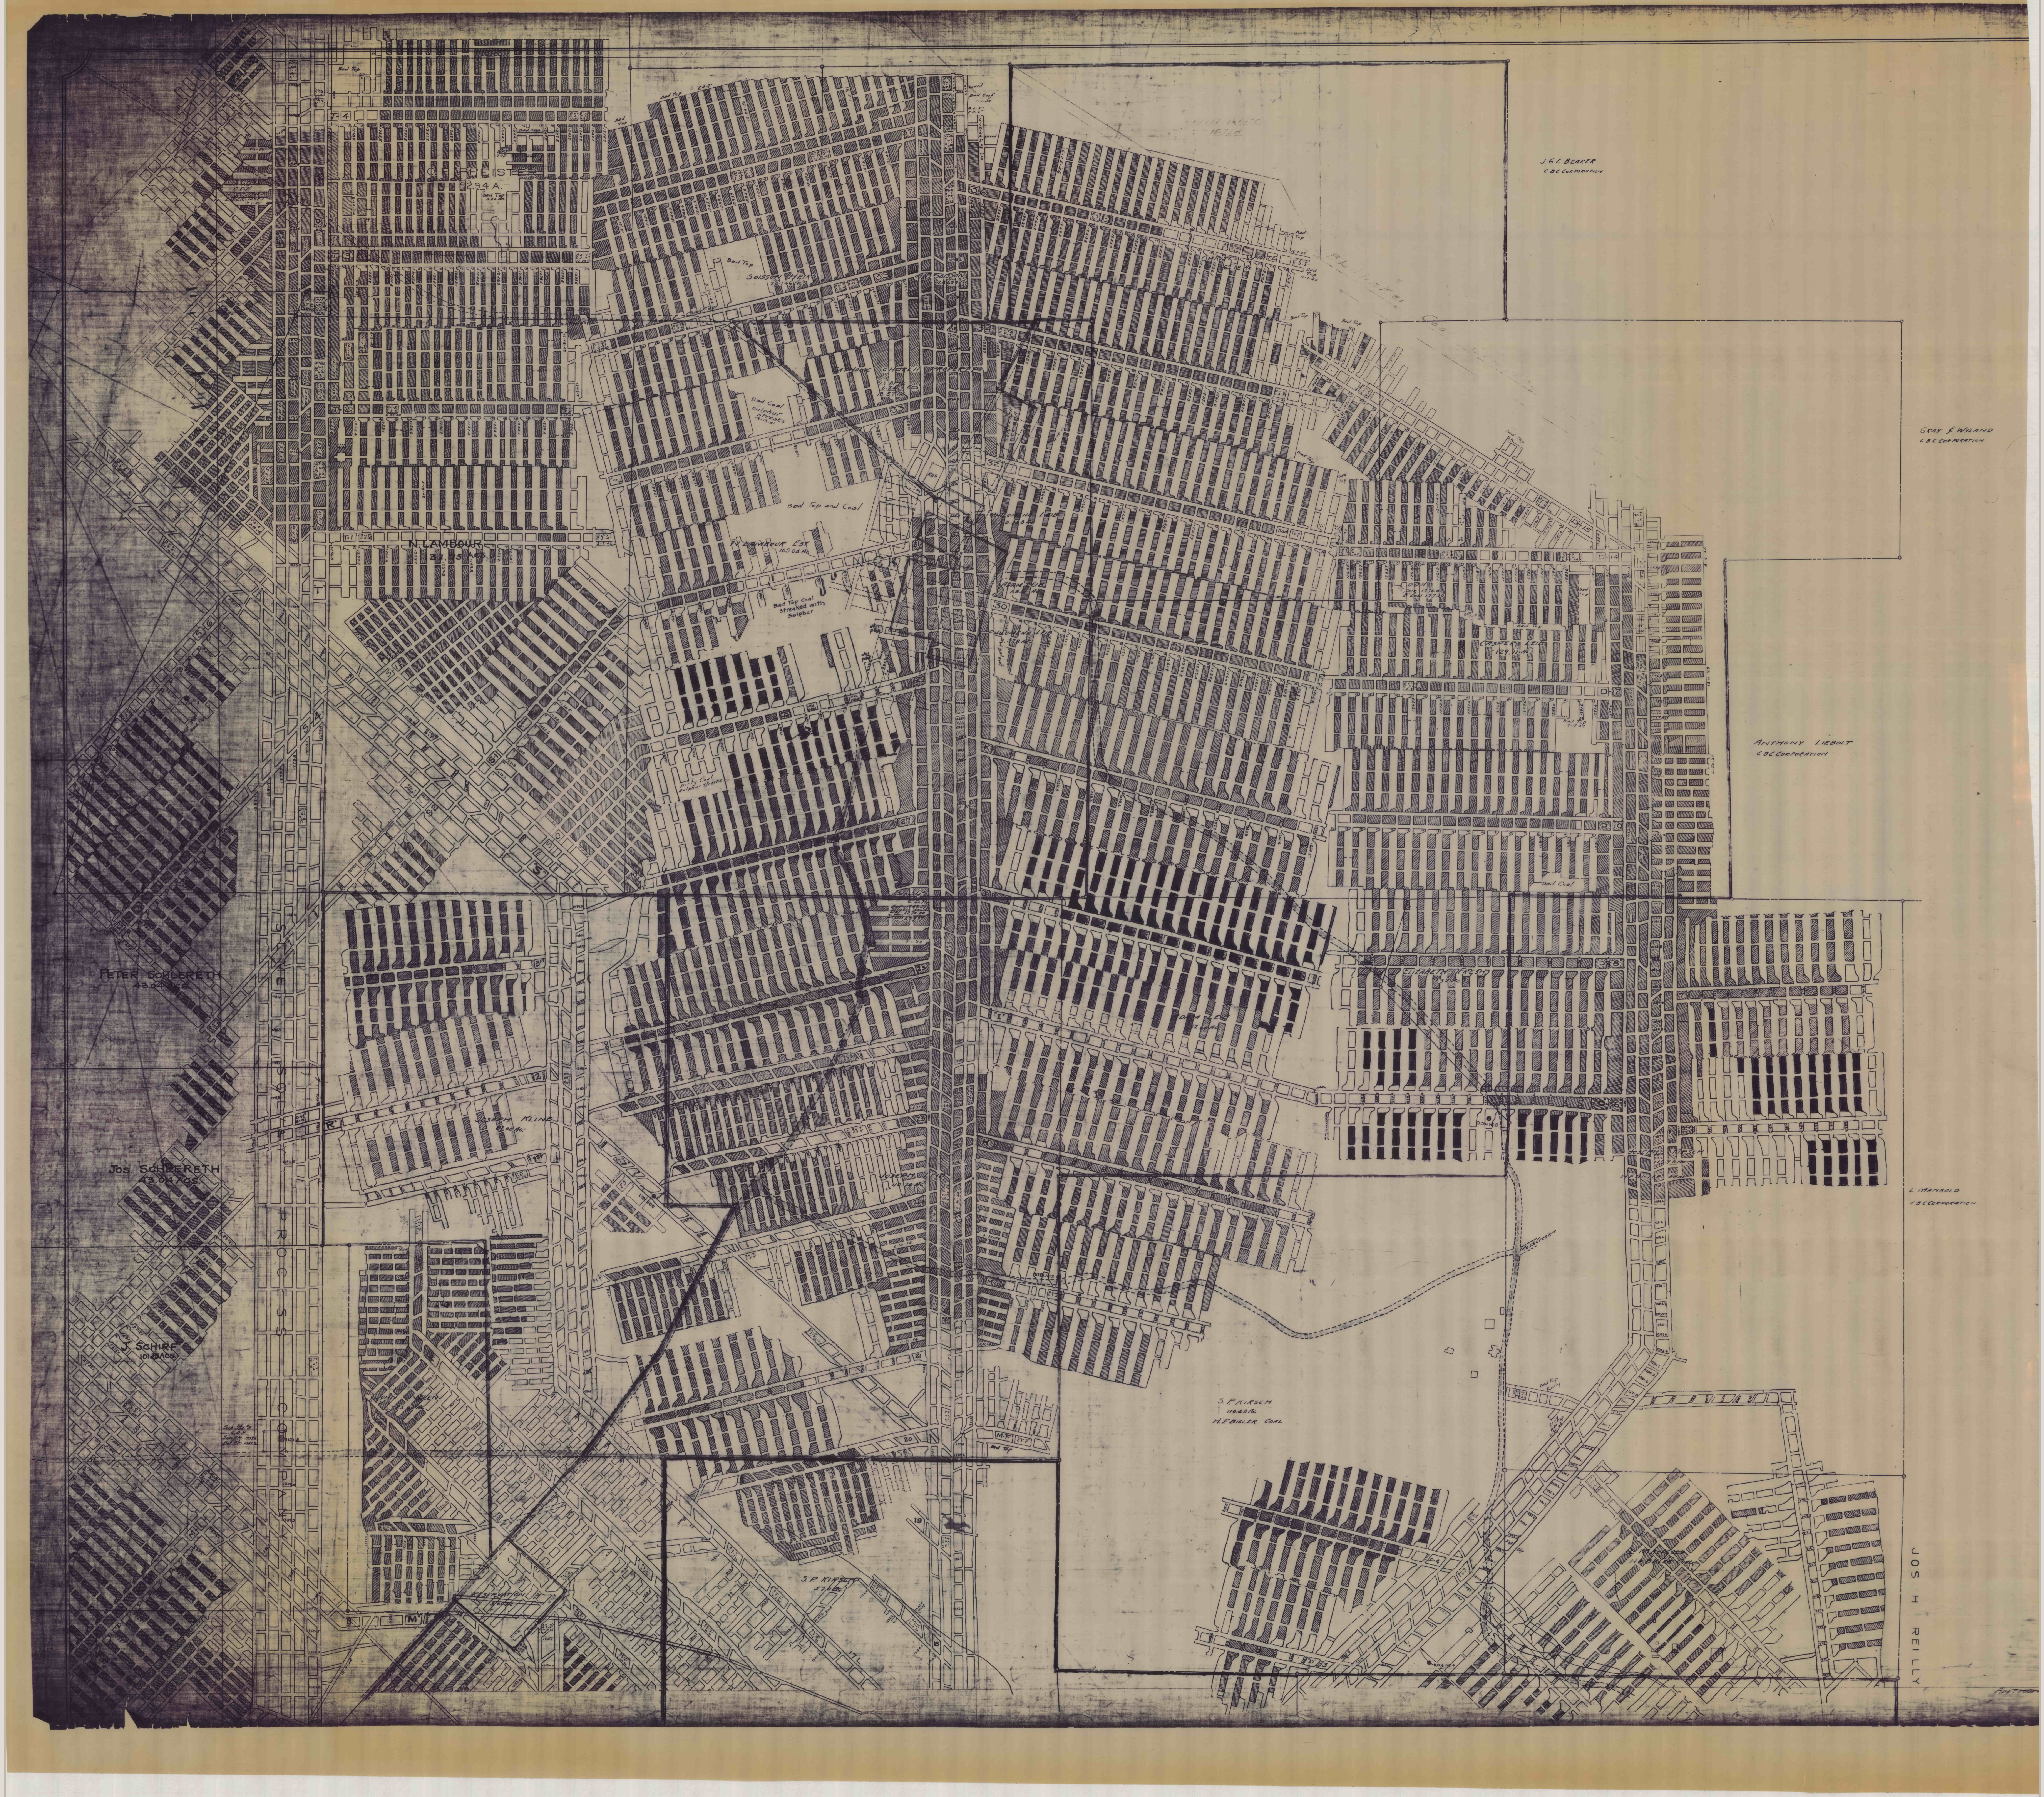
C. R. PFEISTER
52.94 A.
Bad Top
N. LAMBOUR
131.85 Acs.
T-4
T-3
T-1
T
SOISSON HEIRS
24.74 Ac.
A. D. SOISSON
24.659 Ac.
CATHOLIC CHURCH PROPERTY
13.81 Ac.
0.24 Ac. RES
13.57 Ac.
Bad Coal
Sulphur
Streaks
12-13-41
Bad Top and Coal
N. LAMBOUR EST.
105.04 Ac.
NICKTOWN
RES
Bad Top Coal
Streaked with
Sulphur
PHILOMENA LEIB
0.338 Ac.
ADAM LEIB
18.5 Ac.
PHILOMENA LEIB
3.328 Ac.
Bad Roof
Dirty Coal
Sulphur streaks
CHRIST WHITE
67.18 Ac.
J. G. C. BEARER
C B C CORPORATION
GRAY & WYLAND
C. B. C. CORPORATION
CASPER LEIB
129.11 Ac.
Bad Top
D-15
D-14
D-12
D-10
D-8
D-6
D-4
D-3
Bad Coal
ANTHONY LIEBOLT
C B C CORPORATION
ELIZABETH FRESH
5.32 Ac.
D.D.H. No. 2
JOSEPH
H. F. BIGLER COAL
Moss Creek
L. MANGOLD
C B C CORPORATION
S. P. KIRSCH
110.48 Ac.
H. F. BIGLER COAL
Bad Top
Reilly
L. MANGOLD
H. F. BIGLER COAL
D.D.H. No. 4
JOS H REILLY
ANTHONY
JOSEPH LEIB
140.74 Ac.
S. P. KIRSCH
57.6 Ac.
PETER SCHLERETH
43.04 Acs.
JOS. SCHLERETH
43.04 Acs.
J SCHIRF
101.25 Acs.
JOSEPH KLINE
63.00 Ac.
RESERVATION
3.00 Ac.
PROCESS COMPANY
Sub-Sta. #3
C.D.H.
Sur. Ele. 1757.5
Bot. Ele. 1381.3
S
S-1
S-2
S-4
S-5
S-6
R
M
M-F
M-G
H
I
K
17
18
19
20
21
22
23
24
25
27
29
30
31
32
33
34
35
36
37
splice line