


DATE OF LAST SURVEY	BY	REMARKS
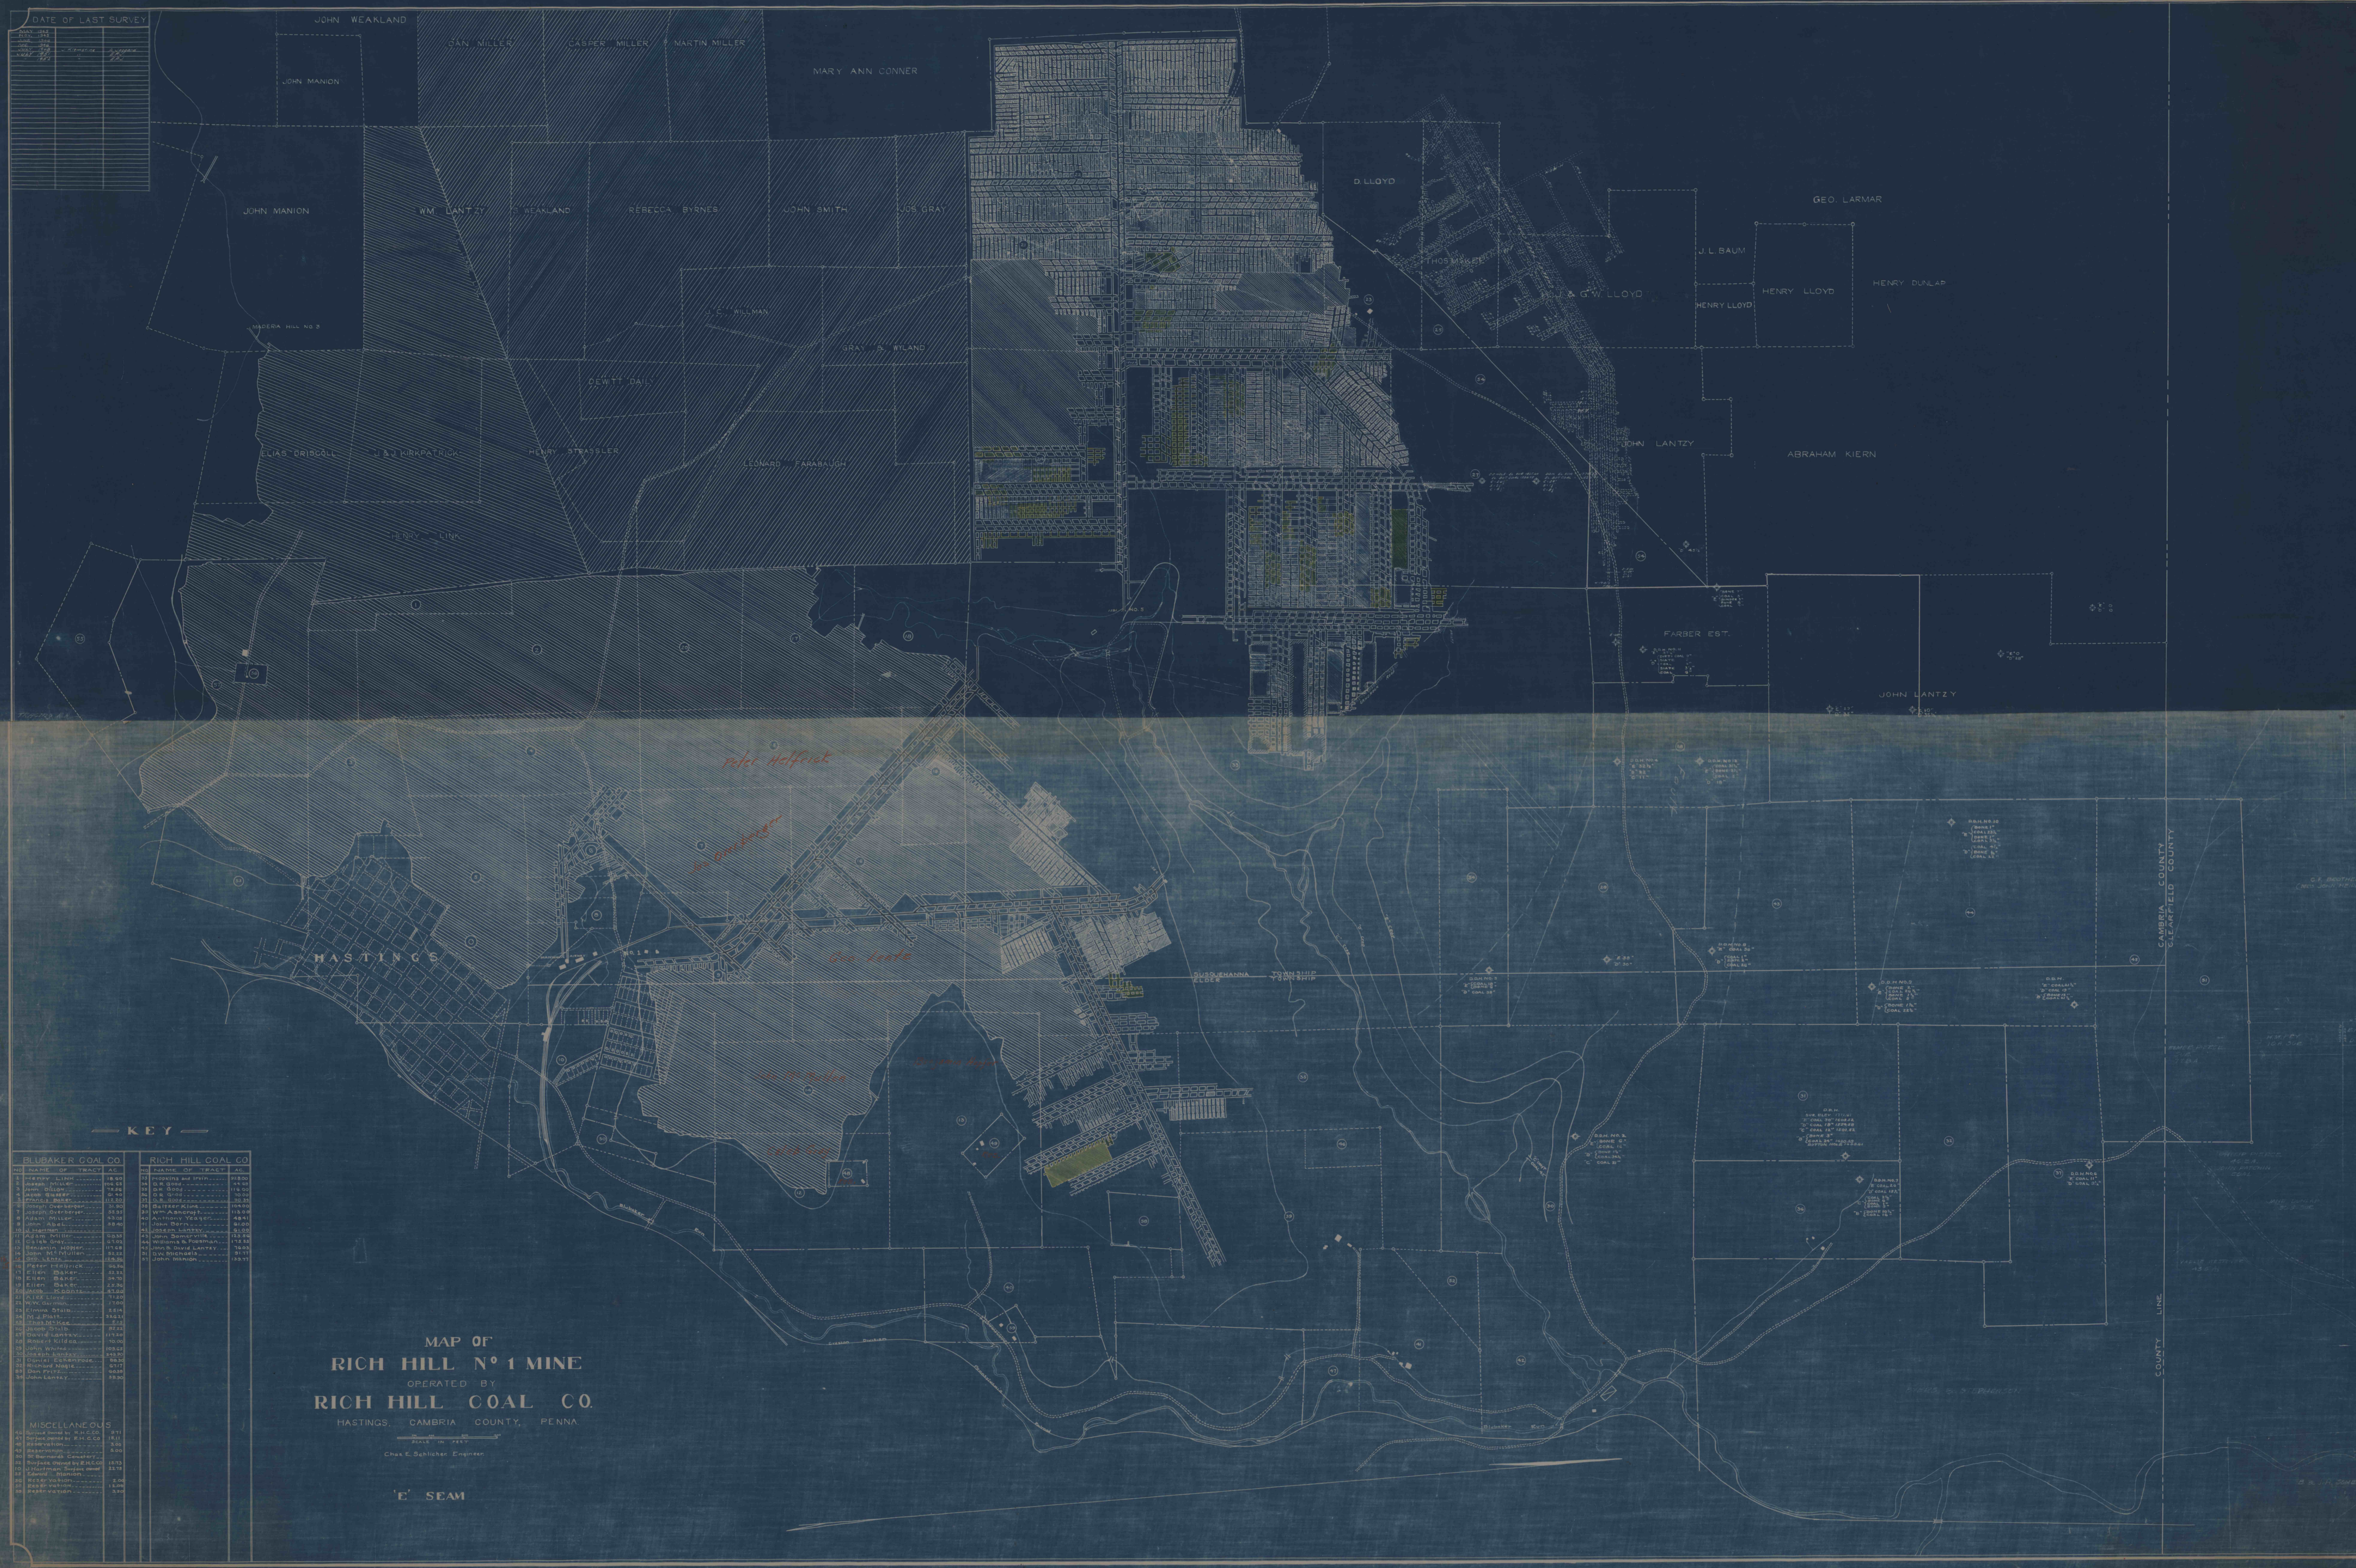

**KEY**

BLUBAKER COAL CO.		RICH HILL COAL CO.	
NO.	NAME OF TRACT AC.	NO.	NAME OF TRACT AC.
1	Henry Link	18	Proprietor and Tract
2	John Miller	19	Rich Hill

MISCELLANEOUS	

**MAP OF  
RICH HILL NO. 1 MINE**  
OPERATED BY  
**RICH HILL COAL CO.**  
HASTINGS, CAMBRIA COUNTY, PENNA.

Scale: 1" = 100'  
Chas. E. Schlicher, Engineer

**E' SEAM**

CAMBRIA COUNTY  
CLEARFIELD COUNTY  
COUNTY LINE