


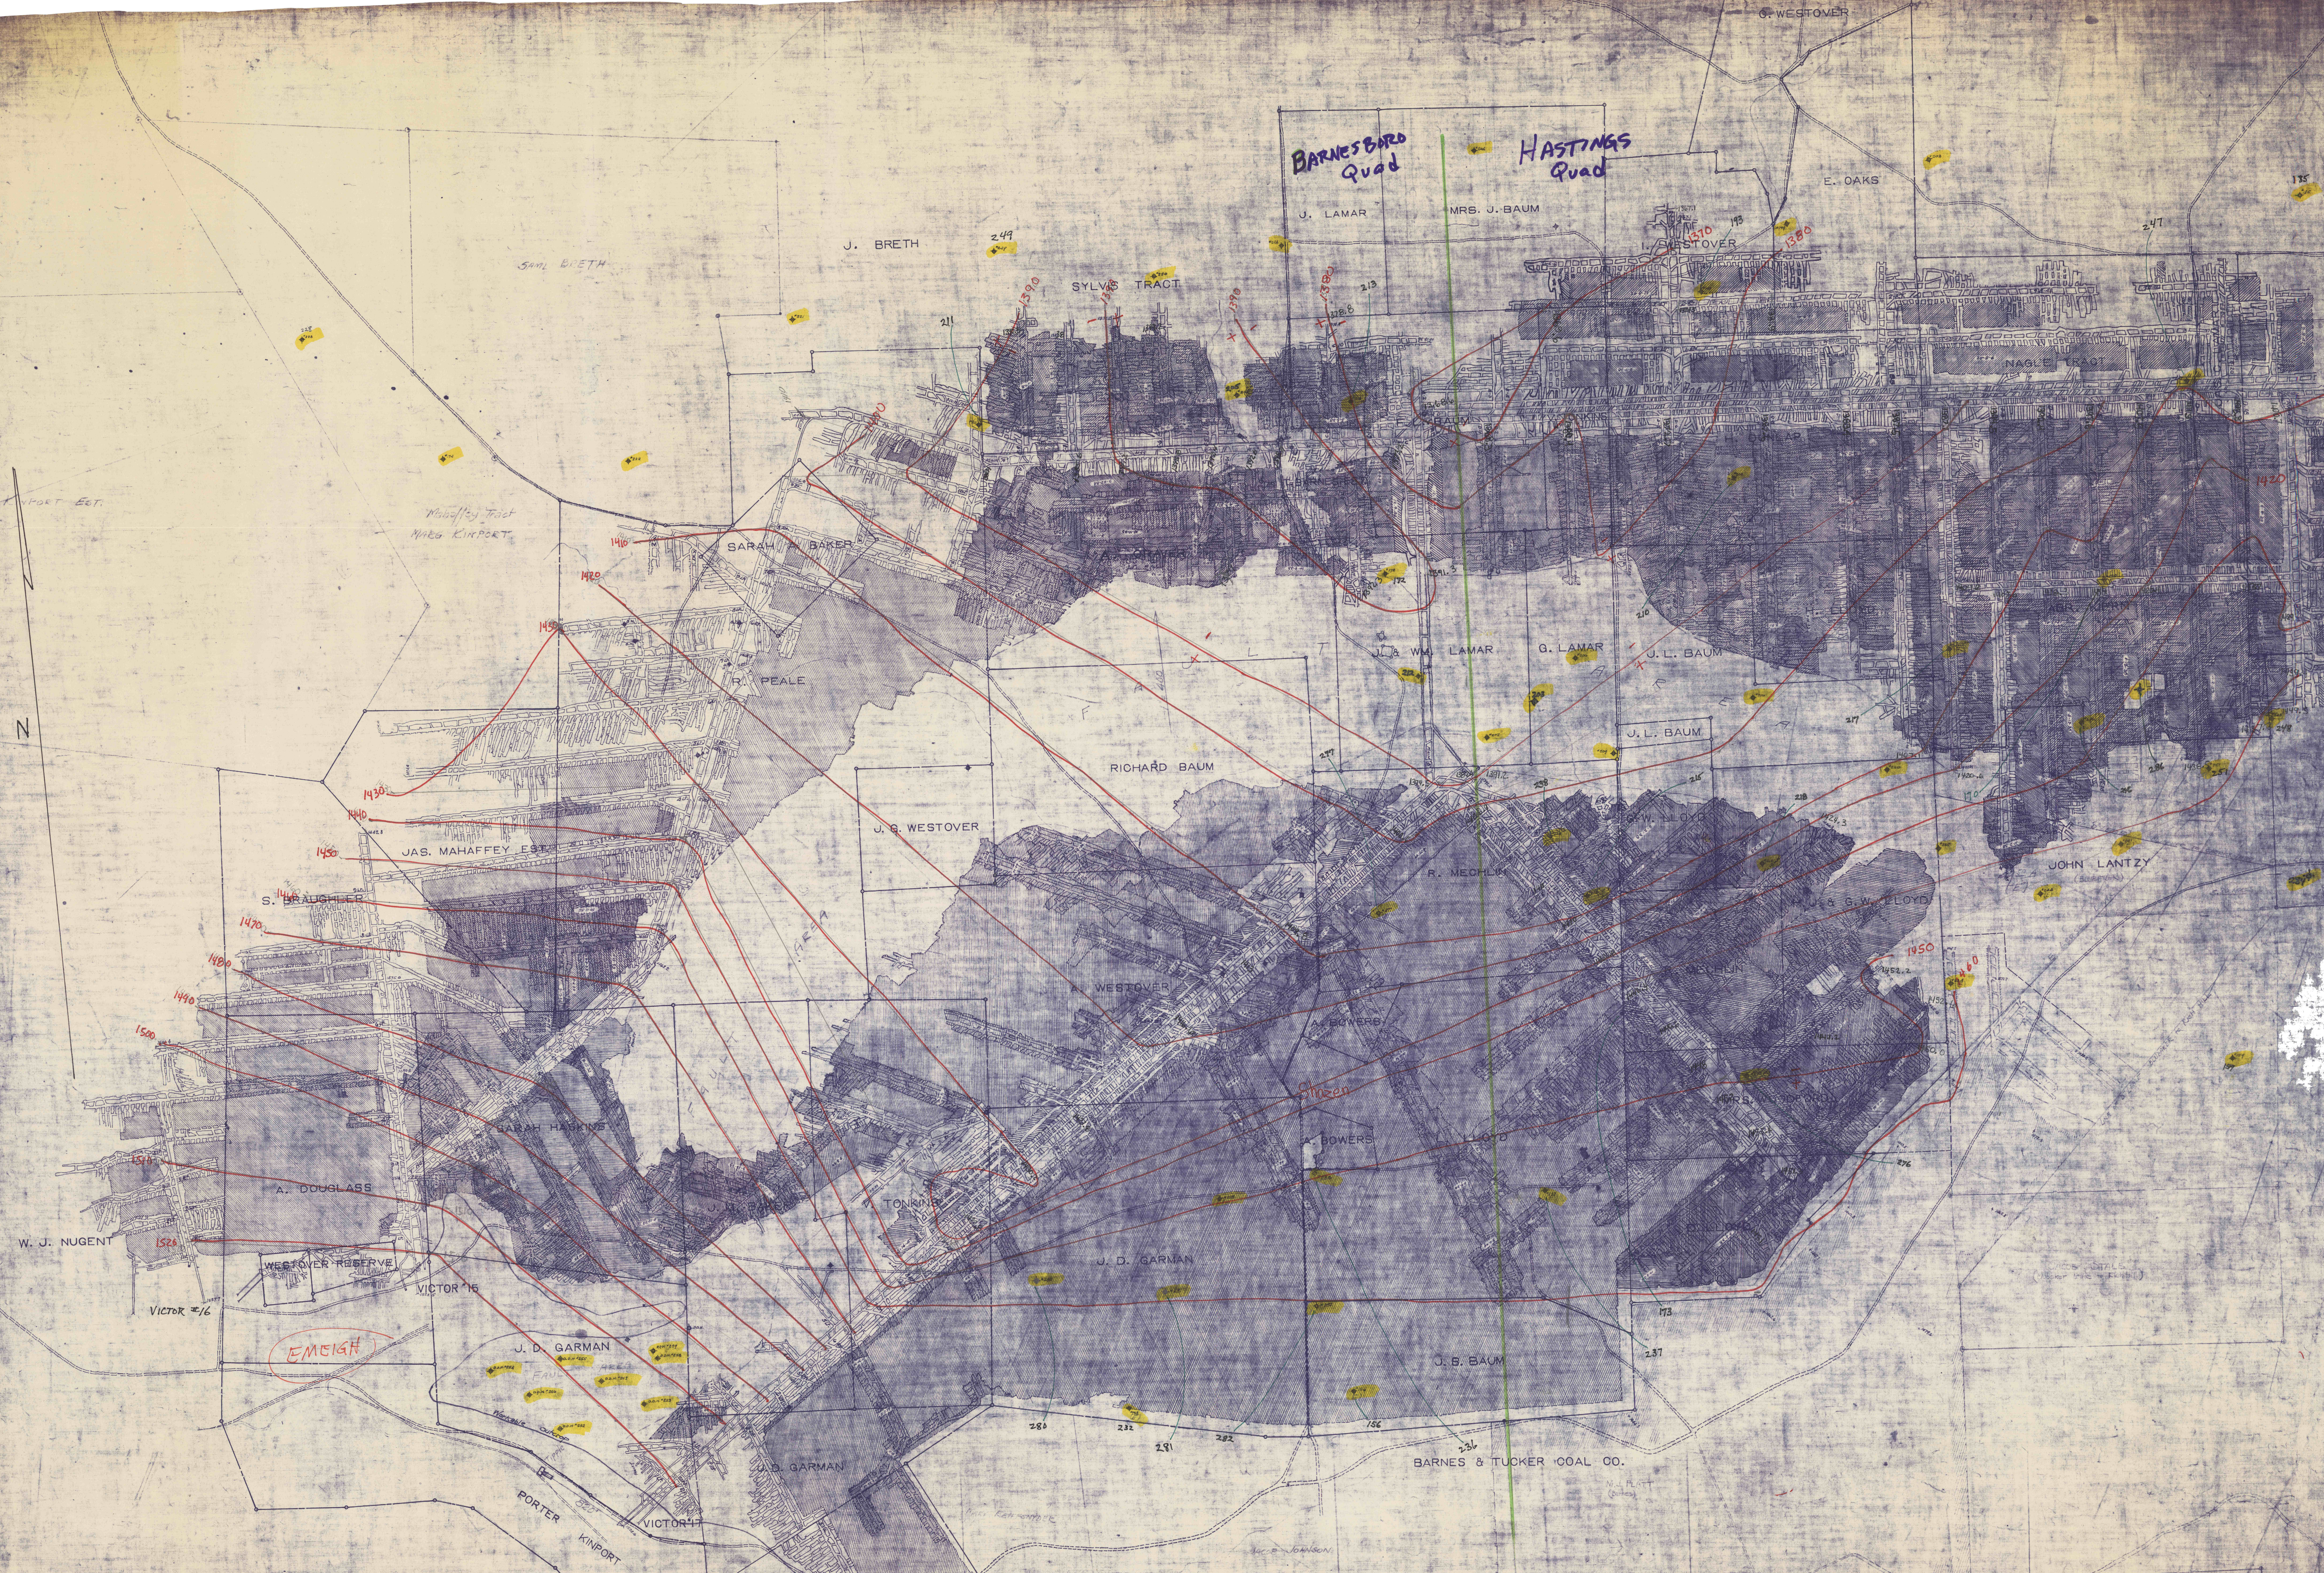

MAP OF MINES
CHERRY TREE COAL CO.
EMEIGH, CAMBRIA CO. PENNA.
SCALE - 1 IN. = 400 FT.