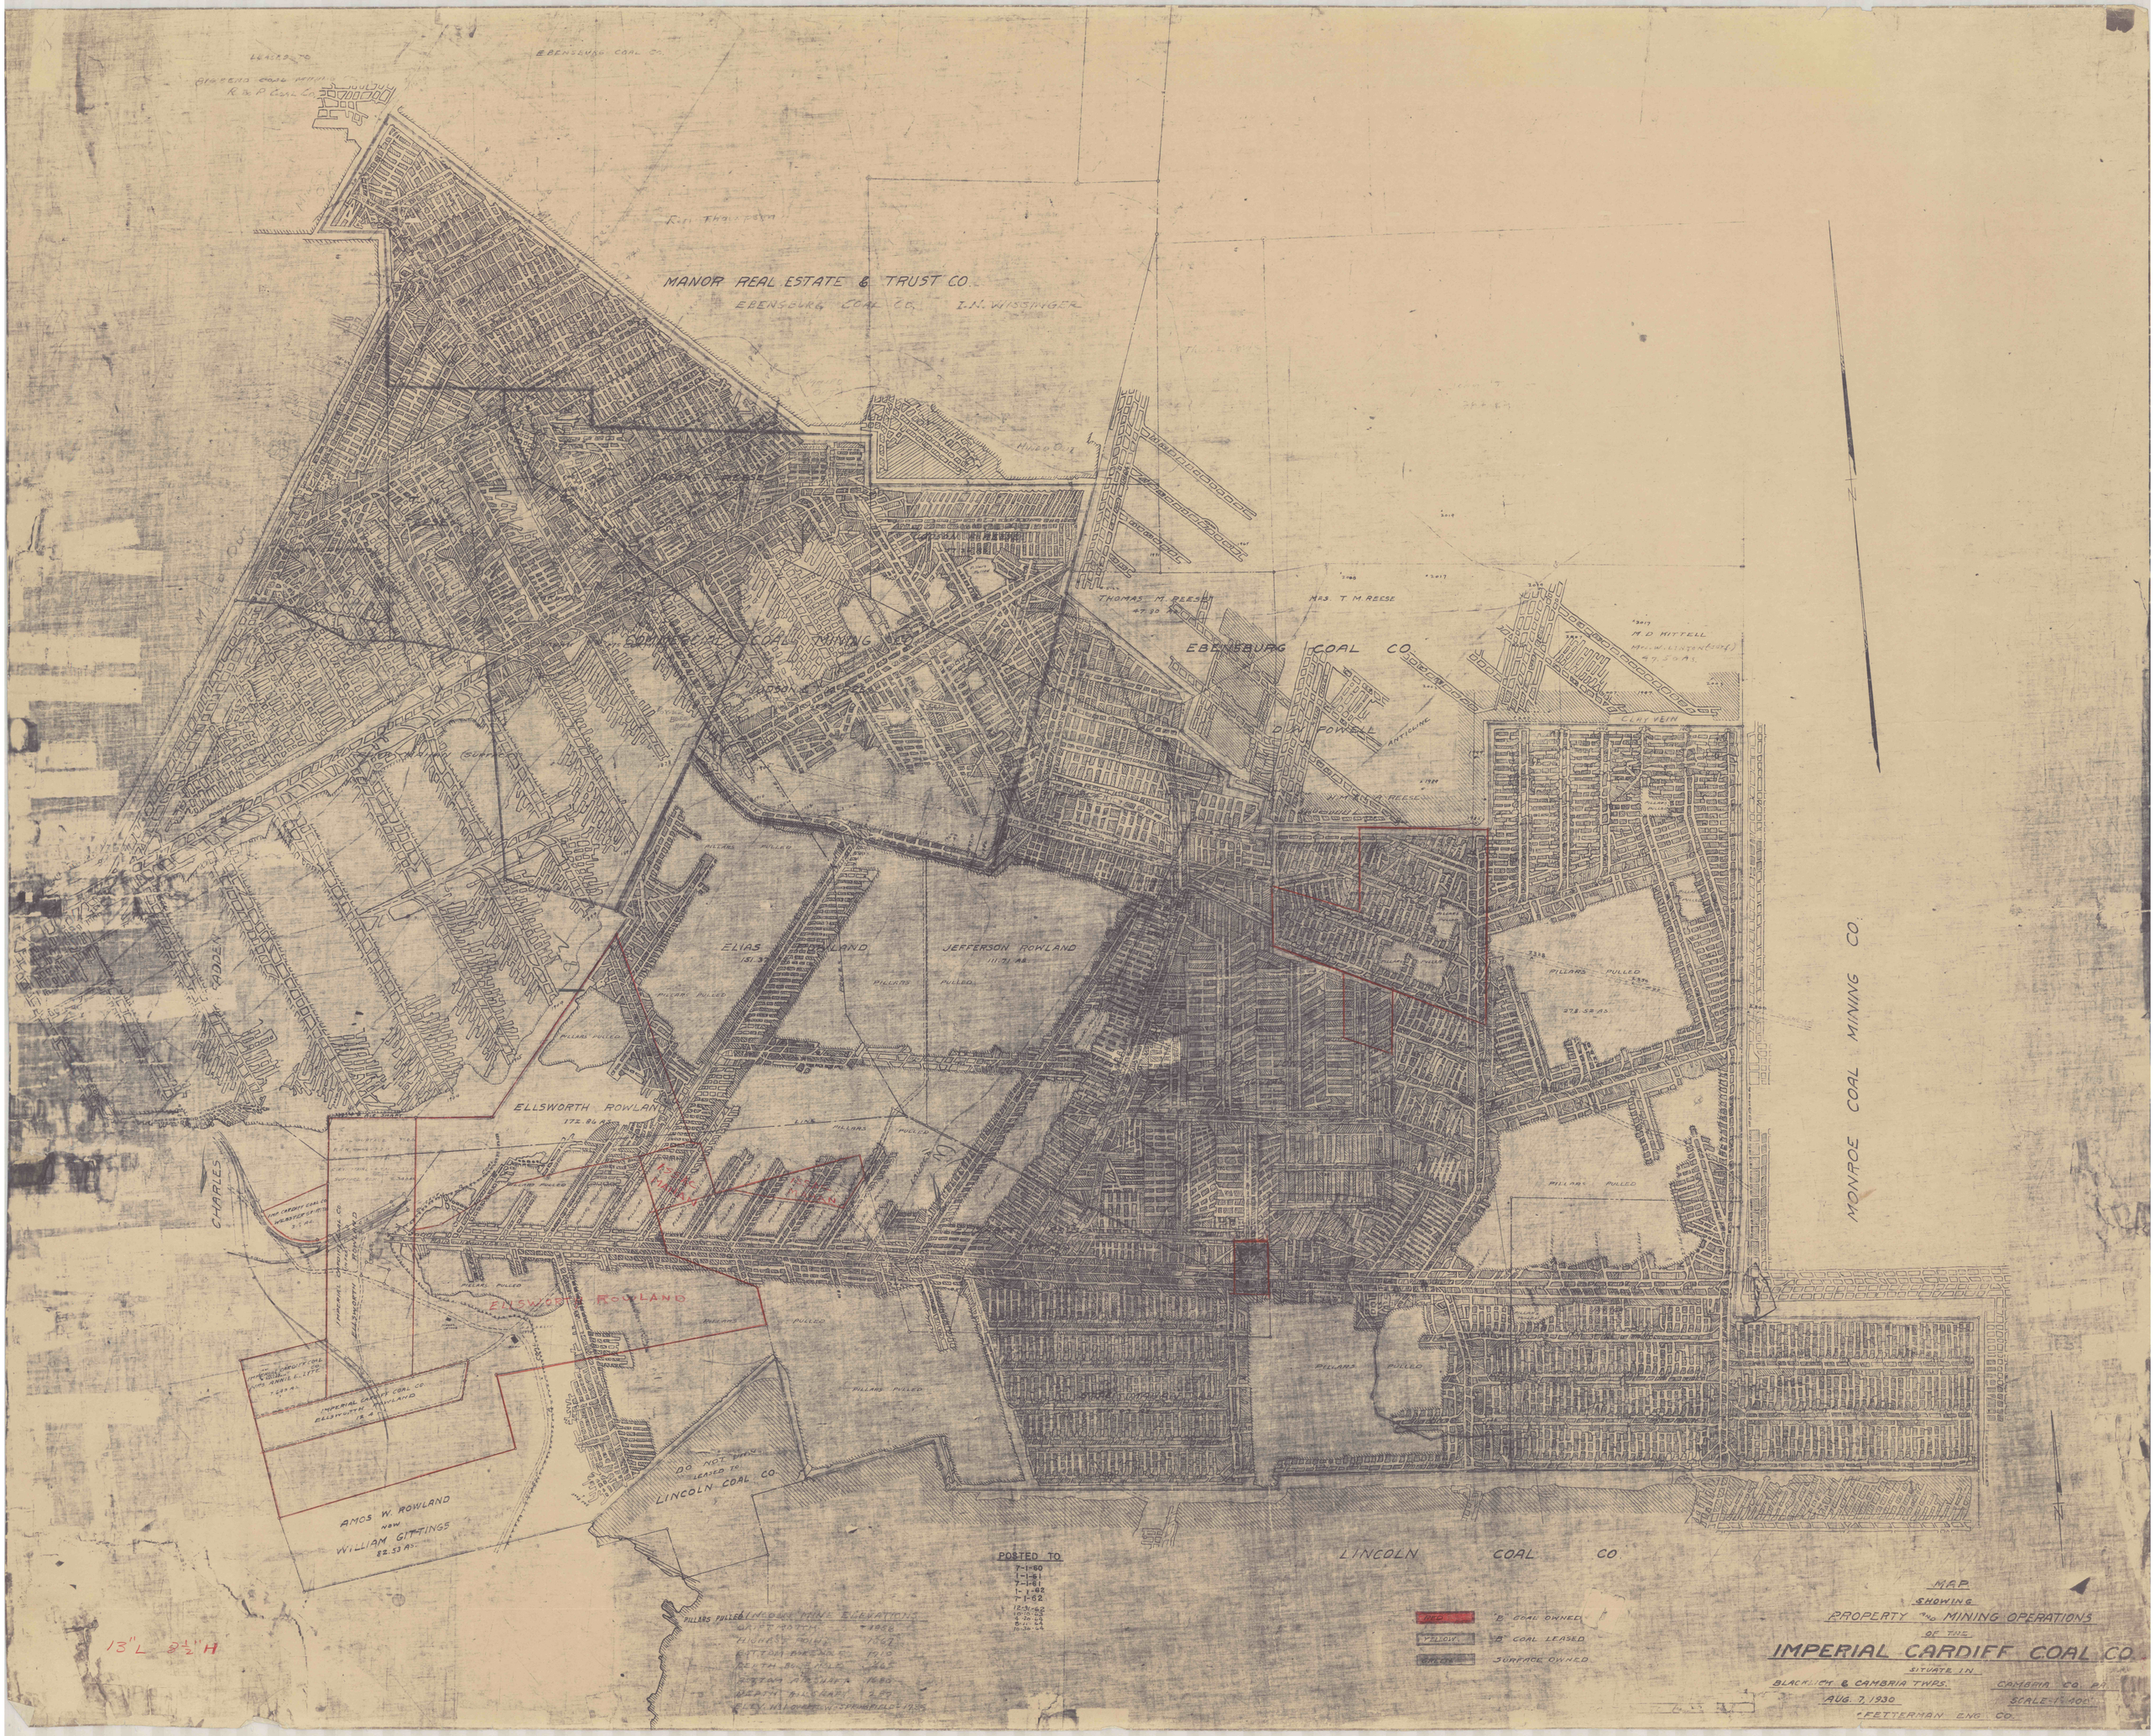
MANOR REAL ESTATE & TRUST CO.
EBENSBURG COAL CO.
I.N. WISSINGER
THOMAS M. REESE
MRS. T. M. REESE
EBENSBURG COAL CO.
M. D. KITTELL
CLAY VEIN
ELIAS ROWLAND
JEFFERSON ROWLAND
ELLSWORTH ROWLAND
CHARLES
MONROE COAL MINING CO.
AMOS W. ROWLAND
NOW
WILLIAM GITTINGS
82.53 AS.
DO NOT MINE
LEASED TO
LINCOLN COAL CO.
LINCOLN COAL CO.
PILLARS PULLED
POSTED TO
7-1-60
1-1-61
7-1-61
1-1-62
7-1-62
12-31-62
10-10-63
6-30-63
8-11-64
10-30-64
LINCOLN MINE ELEVATIONS
DRIFT MOUTH 1958
HIGHEST POINT 1667
BOTTOM BOREHOLE 1710
DEPTH BOREHOLE 1465
BOTTOM AIRSHAFT 1680
DEPTH AIRSHAFT 289
ELEV. NO. 1 OVERFLOW - SPRINGFIELD - 1735
RED "B" COAL OWNED
YELLOW "B" COAL LEASED
GREEN SURFACE OWNED
13"L 8½"H
MAP
SHOWING
PROPERTY AND MINING OPERATIONS
OF THE
IMPERIAL CARDIFF COAL CO.
SITUATE IN
BLACKLICK & CAMBRIA TWPS.
CAMBRIA CO. PA.
AUG. 7, 1930
SCALE 1" = 400'
FETTERMAN ENG. CO.