


CHERRYHILL MINES
IMPERIAL COAL CORP.
 CHERRYHILL TWP. INDIANA CO., PA.

FEB., 24, 1964.
 REVISED JULY 1, 1965.

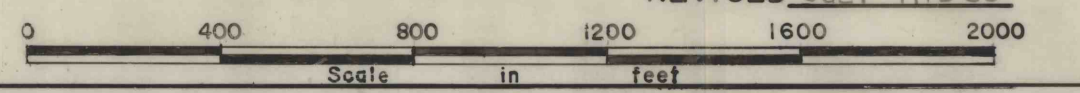

ENGINEER