

WATKINS COAL CO.

BLUBAKER
WATKINS COAL CO. (Lessor)
COAL CO. (Lessee)

BLUBAKER COAL CO.

JOS. GRAY
30 A.

MARY A. CONNER
127 A.

WHIPPOORWILL TRAC
418 A. 83 P.


DAVID ATHELTON

D. F. McNULTY

GEO. GARMAN
84 A.

B. F. PITT
92.0 A.

Main Hdq. D'sears

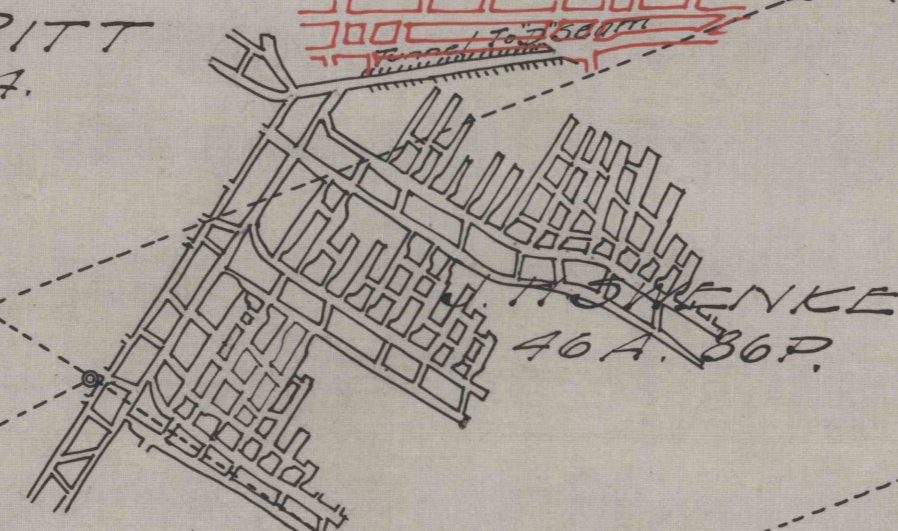

SARAH MYERS
26 A. 29 P.

LEVI FLOUSE
96 A. 27 P.

LEVI FLOUSE
71 A. 10 P.

M. WESTOVER
52 A. 34 P.

JACOB JOHNSON
182 A. 142 P.

P. KINPORTS
20 A.

S. LANGHAM
52 A. 5 P.

M. BELFONDYER
56 A. 9 P.

CHEBBYTREE COAL CO.

EMPIRE COAL MINING CO.

MAP OF
BARNES & TUCKER CO'S
Nos. 9-10 & TUNNEL MINES "E" SEAM.
SHOWING WORKINGS MARCH 1, 1913.
Scale 1"=400' Jan. 1921
Chas. E. Schlicher Engr.

74K