


LOGAN COAL COMPANY
MAP OF No 2
WAGNER MINE
BEAVERDALE PA.
January 1912.
Andrew B. Grichton, Eng.
JOHNSTOWN PA.
Scale: 1 inch = 400 feet.

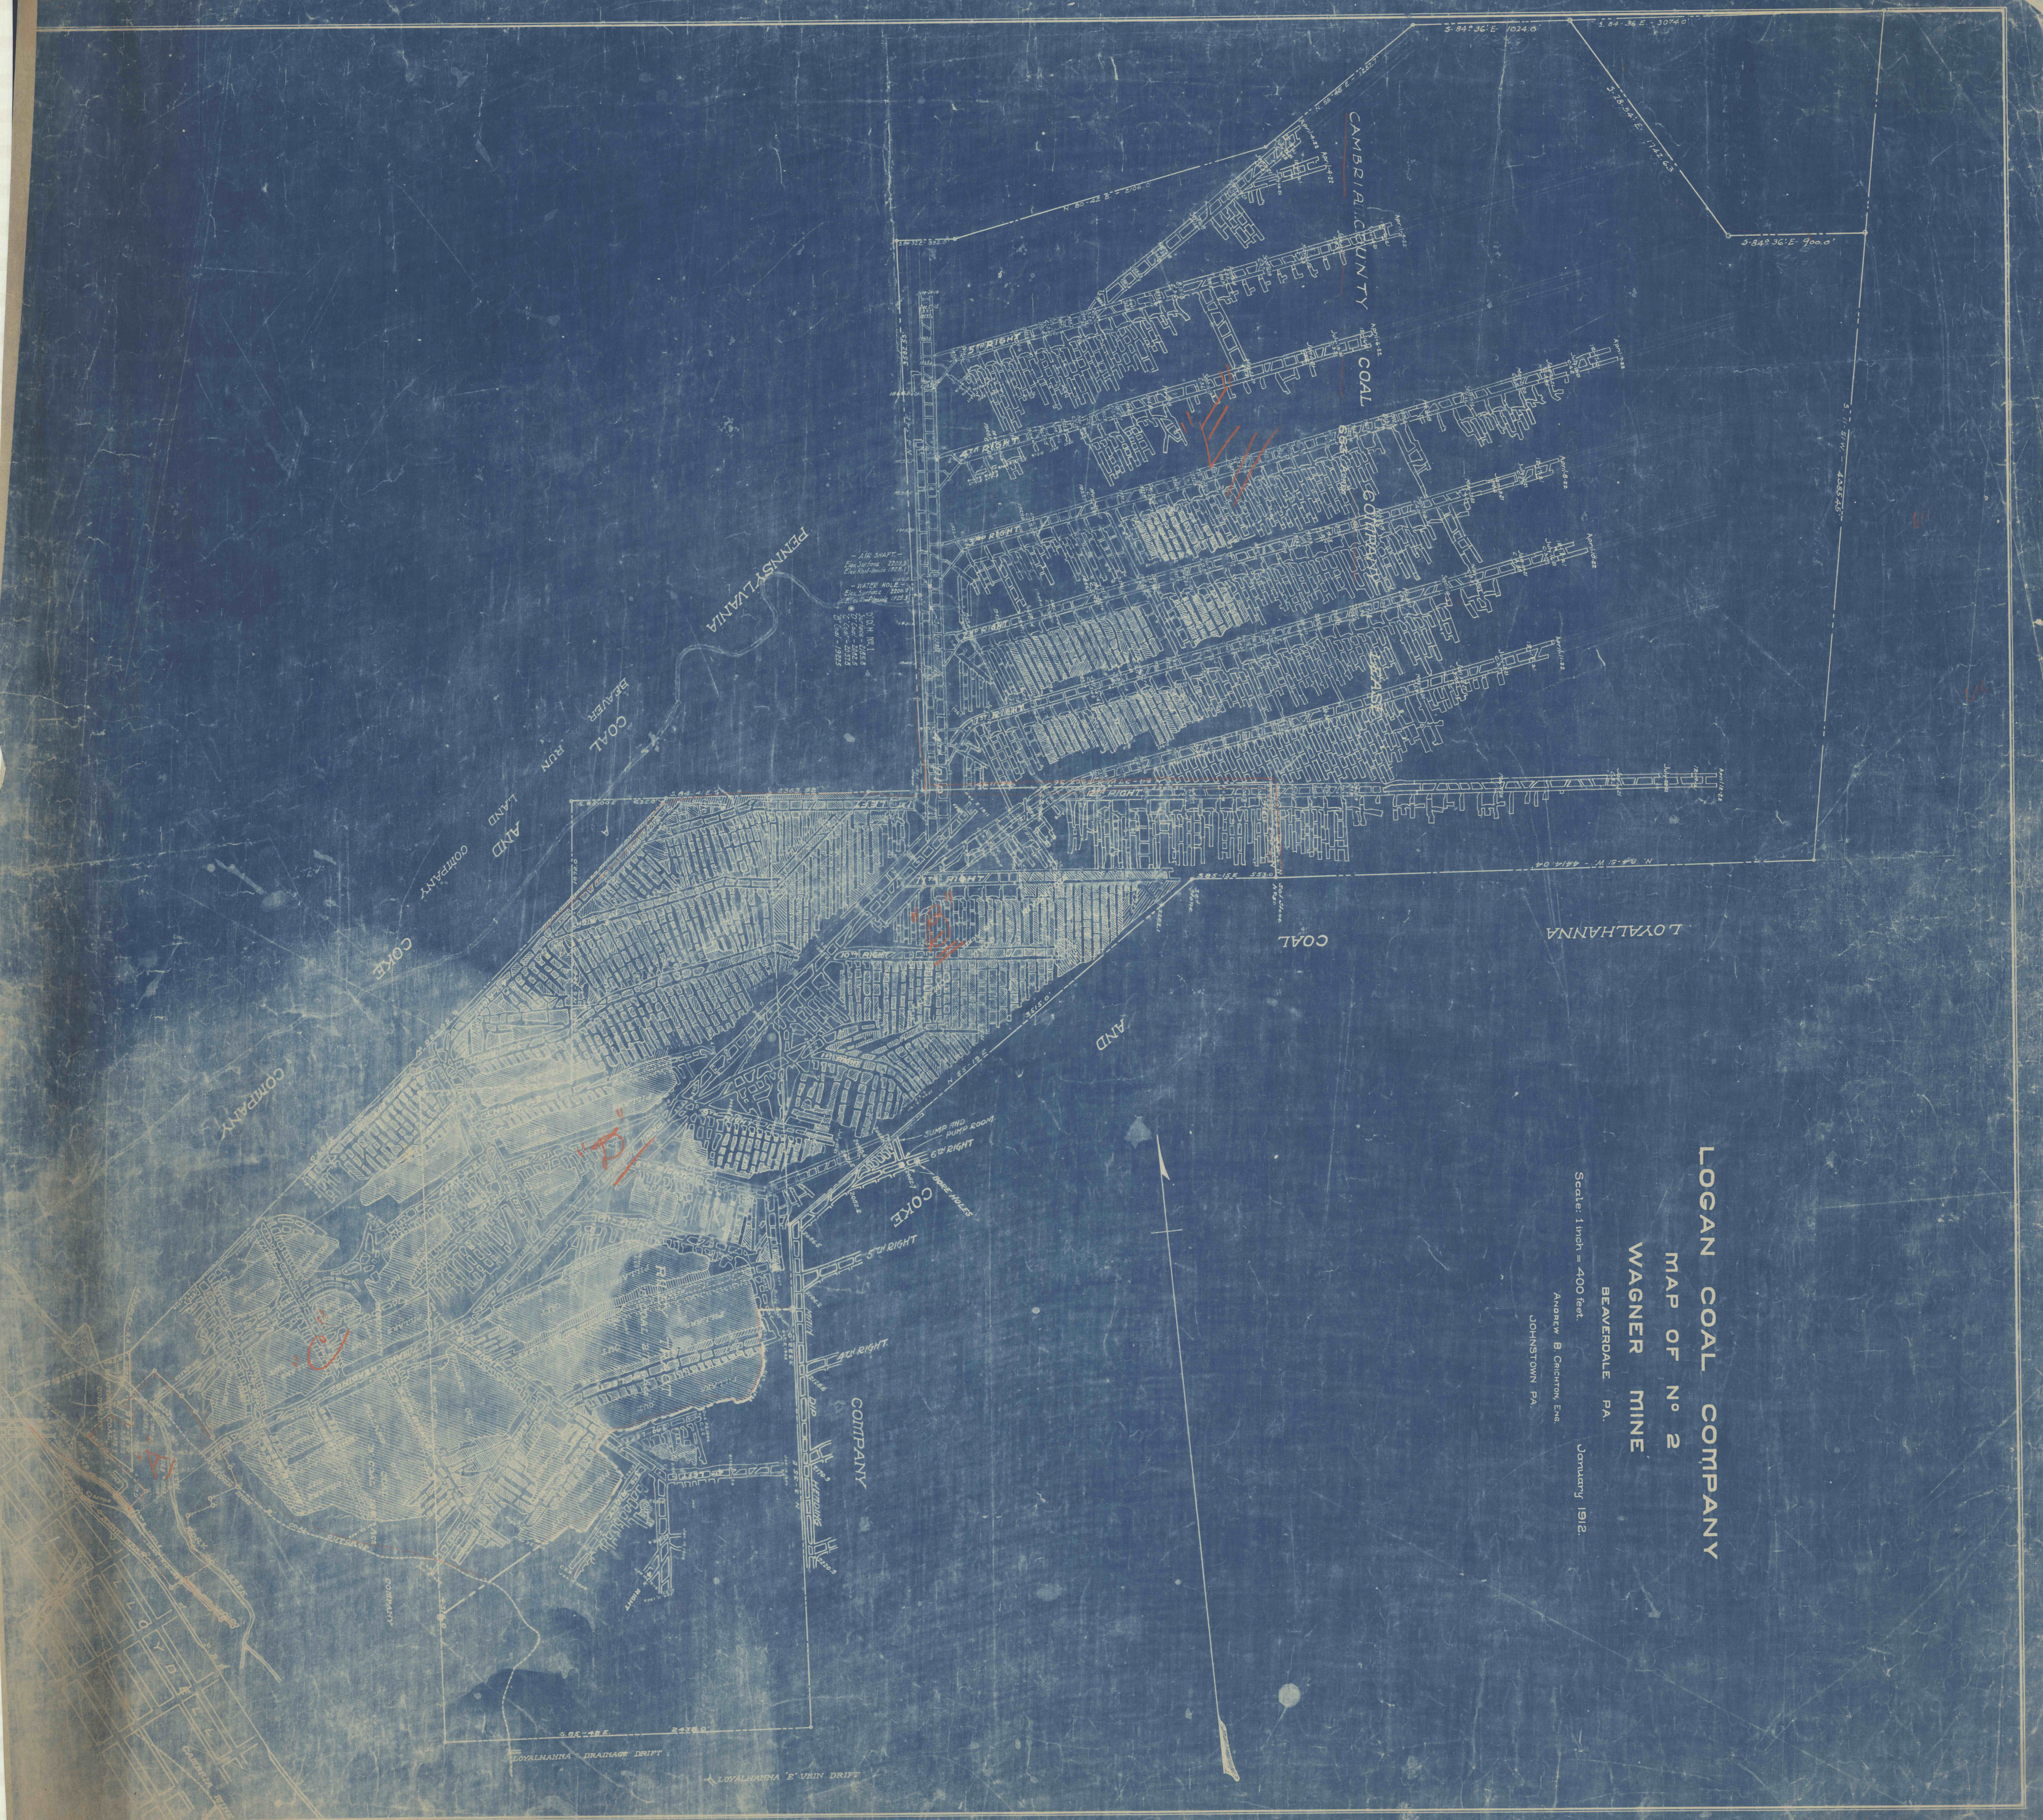















