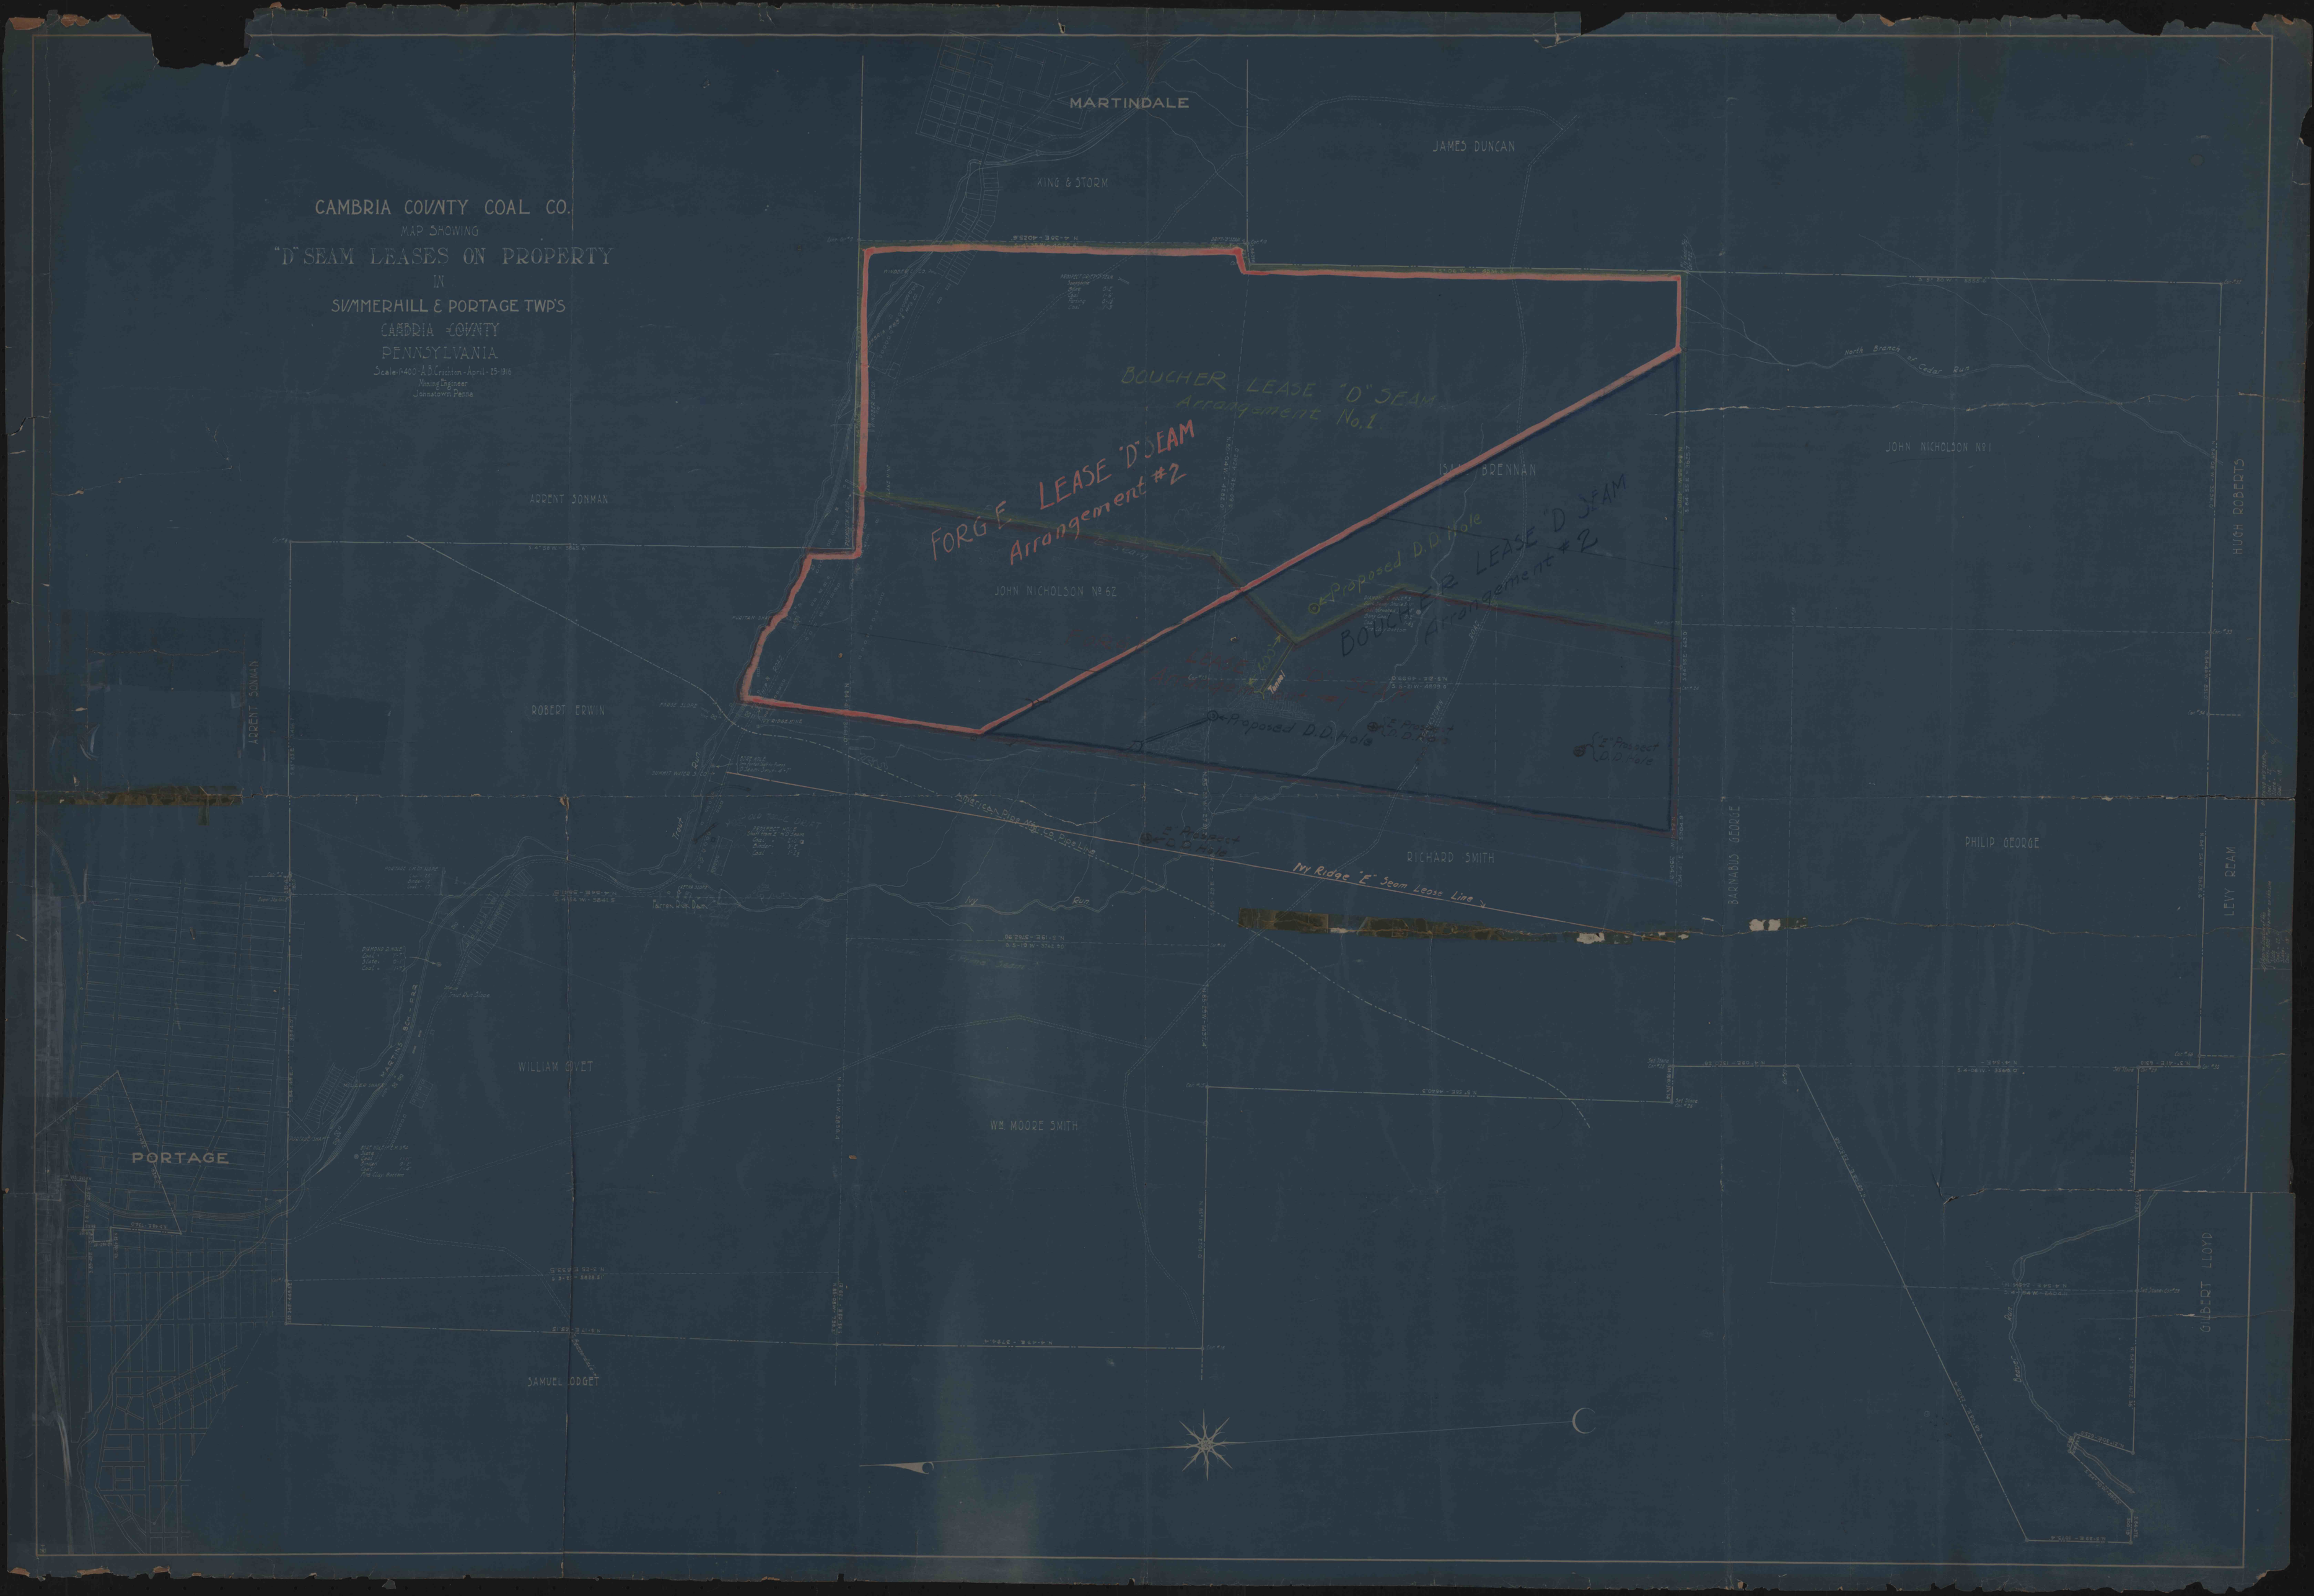
CAMBRIA COUNTY COAL CO.
MAP SHOWING
"D" SEAM LEASES ON PROPERTY
IN
SUMMERHILL & PORTAGE TWP'S
CAMBRIA COUNTY
PENNSYLVANIA
Scale 1:400 - A.B. Crichton - April - 23 - 1916
Mining Engineer
Johnstown Penna
MARTINDALE
JAMES DUNCAN
KING & STORM
BOUCHER LEASE "D" SEAM
Arrangement No. 1
FORGE LEASE "D" SEAM
Arrangement #2
BOUCHER LEASE "D" SEAM
Arrangement #2
Proposed D.D. Hole
JOHN NICHOLSON No 62
JOHN NICHOLSON No 1
ARRENT SONMAN
ROBERT ERWIN
HUGH ROBERTS
RICHARD SMITH
BARNABUS GEORGE
PHILIP GEORGE
LEVY REAM
Ivy Ridge "E" Seam Lease Line
WILLIAM OVET
WM. MOORE SMITH
PORTAGE
SAMUEL ODGET
GILBERT LLOYD