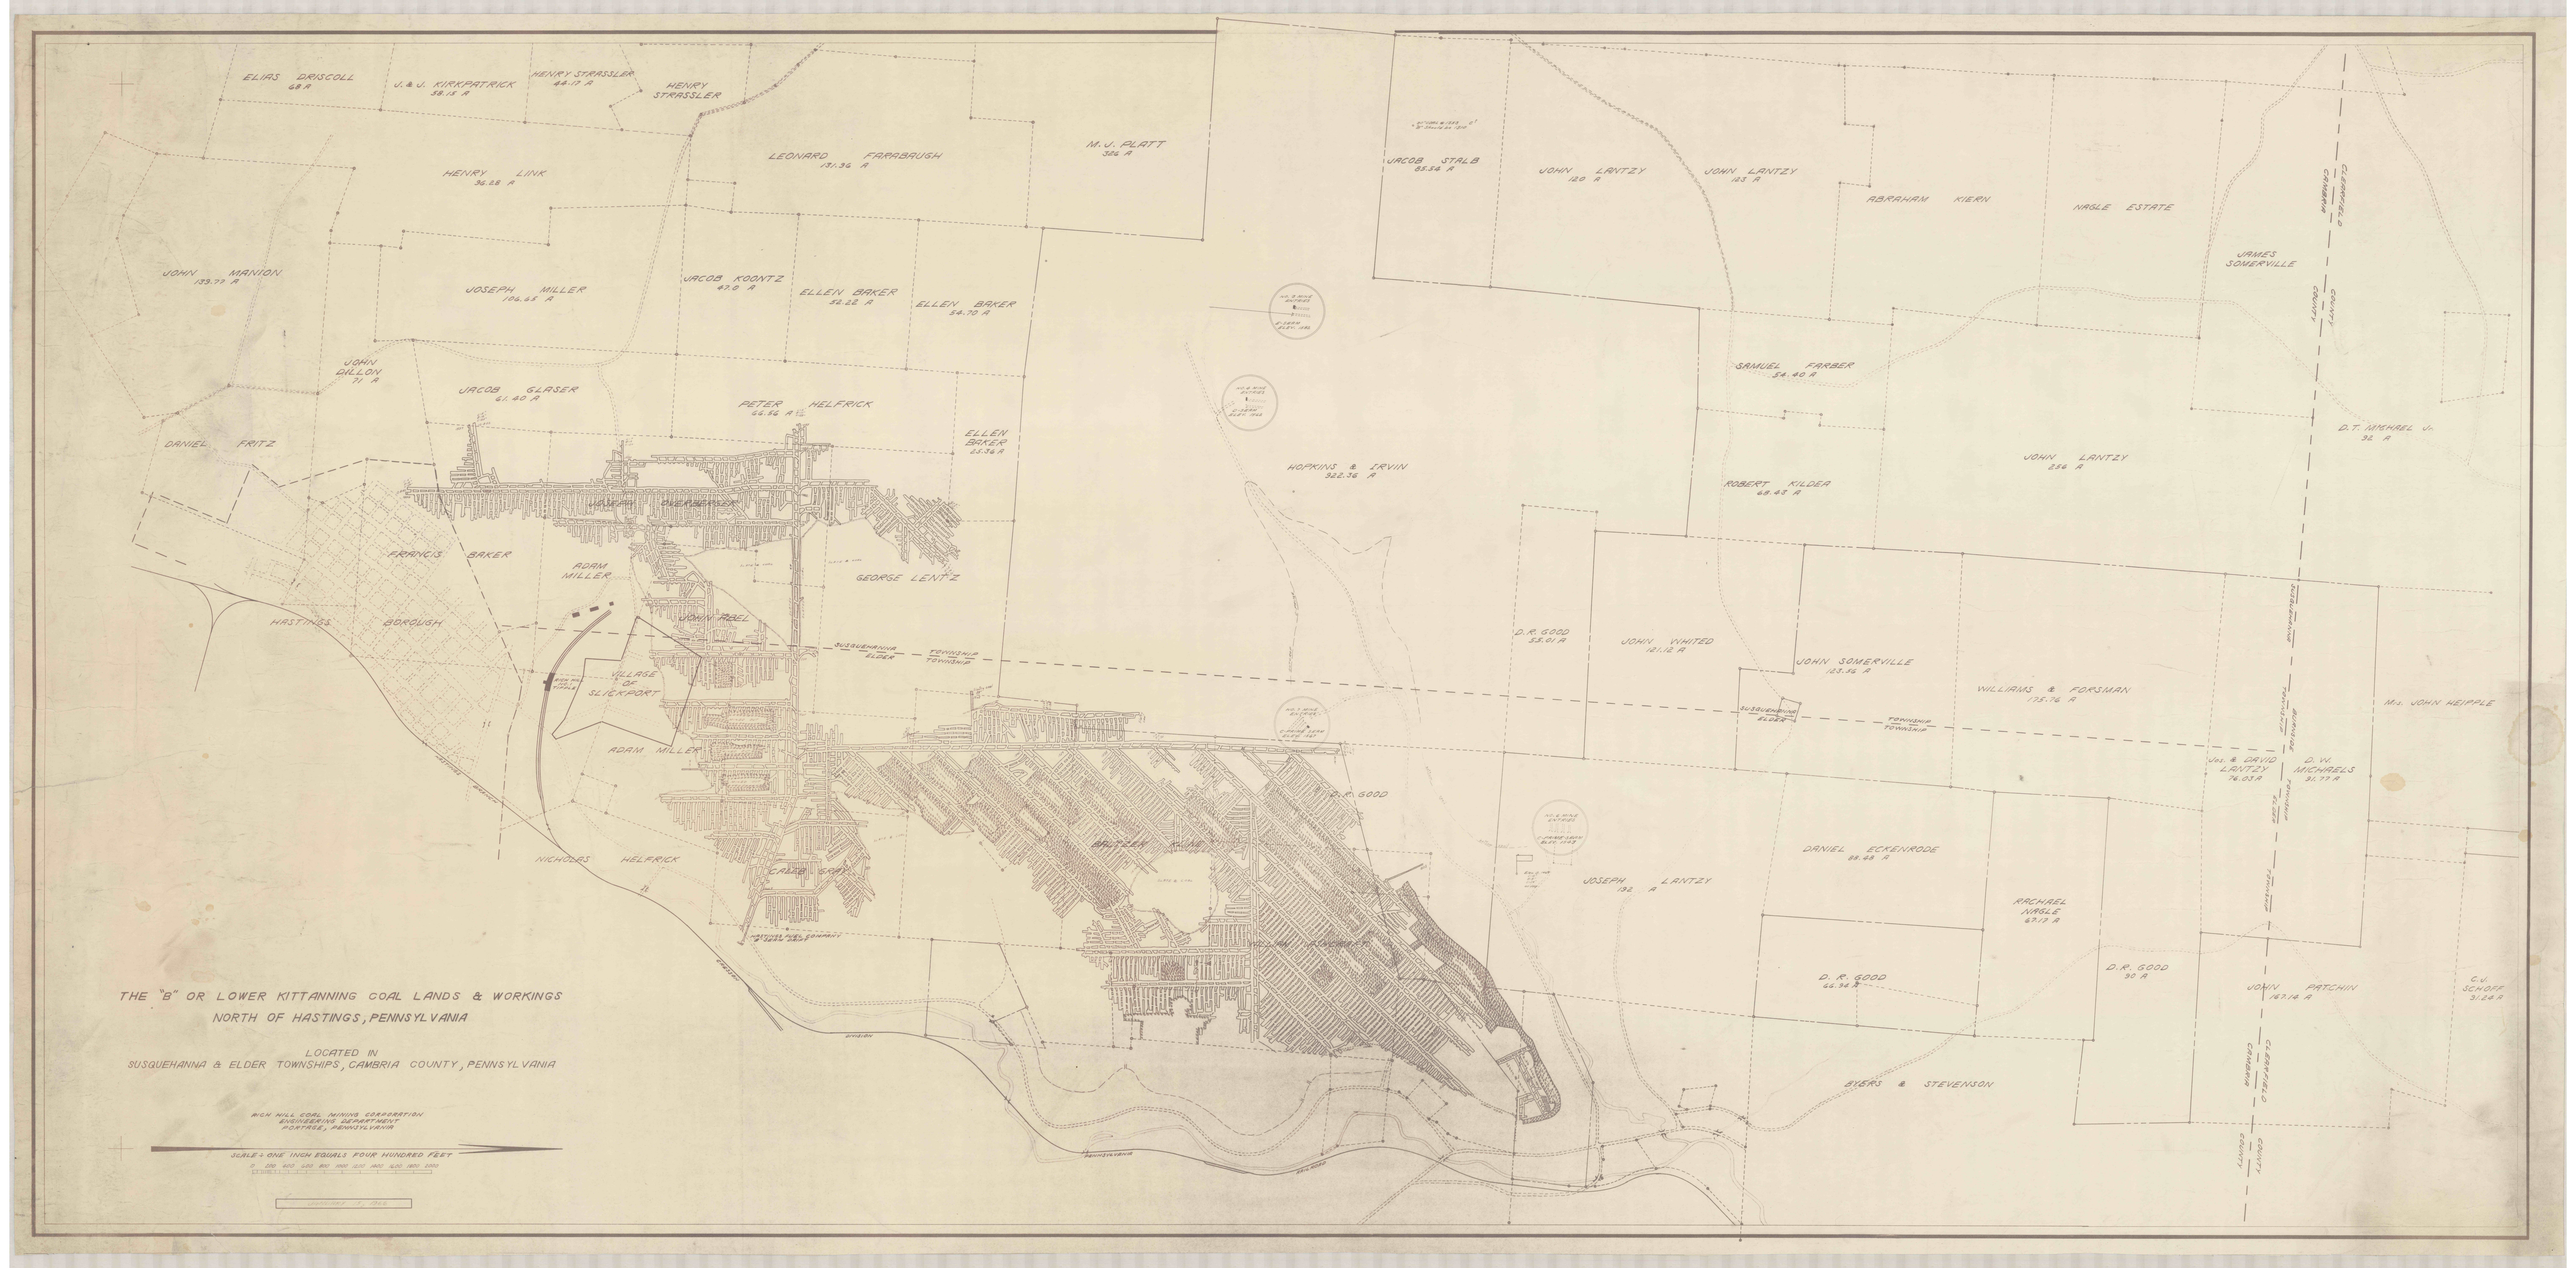
THE "B" OR LOWER KITTANNING COAL LANDS & WORKINGS
NORTH OF HASTINGS, PENNSYLVANIA
LOCATED IN
SUSQUEHANNA & ELDER TOWNSHIPS, CAMBRIA COUNTY, PENNSYLVANIA
SCALE: ONE INCH EQUALS FOUR HUNDRED FEET
0 200 400 600 800 1000 1200 1400 1600 1800 2000
ELIAS DRISCOLL 68 A
J. & J. KIRKPATRICK 58.15 A
HENRY STRASSLER 44.17 A
HENRY STRASSLER
LEONARD FARABAUGH 131.36 A
M. J. PLATT 326 A
HENRY LINK 36.28 A
JOHN MAXION 133.77 A
JOSEPH MILLER 106.45 A
JACOB KOONTZ 47.0 A
ELLEN BAKER 58.22 A
ELLEN BAKER 54.70 A
JOHN DILLON 71 A
JACOB GLASER 61.40 A
PETER HELFRICK 66.56 A
ELLEN BAKER 25.36 A
DANIEL FRITZ
FRANCIS BAKER
ADAM MILLER
GEORGE LENTZ
HASTINGS BOROUGH
VILLAGE OF SLICKPORT
ADAM MILLER
NICHOLAS HELFRICK
SUSQUEHANNA ELDER TOWNSHIP TOWNSHIP
HOPKINS & IRVIN 322.36 A
JACOB STALB 85.54 A
JOHN LANTZY 120 A
JOHN LANTZY 183 A
ABRAHAM KIERN
NAGLE ESTATE
JAMES SOMERVILLE
SAMUEL FARBER 54.40 A
ROBERT KILDER 68.43 A
JOHN LANTZY 256 A
D.T. MICHAEL Jr. 32 A
D.R. GOOD 55.01 A
JOHN WHITED 121.12 A
JOHN SOMERVILLE 183.16 A
WILLIAMS & FORSMAN 175.76 A
Mrs. JOHN HEIPPLE
Jas. & DAVID LAITZY 76.05 A
D.W. MICHAELS 31.77 A
D.R. GOOD
DANIEL ECKENRODE 88.48 A
JOSEPH LANTZY 132 A
RACHAEL NAGLE 67.7 A
D.R. GOOD 66.34 A
D.R. GOOD 30 A
JOHN PATCHIN 167.14 A
C.J. SCHOFF 31.28 A
BYERS & STEVENSON
CLEARFIELD COUNTY
CAMBRIA COUNTY