


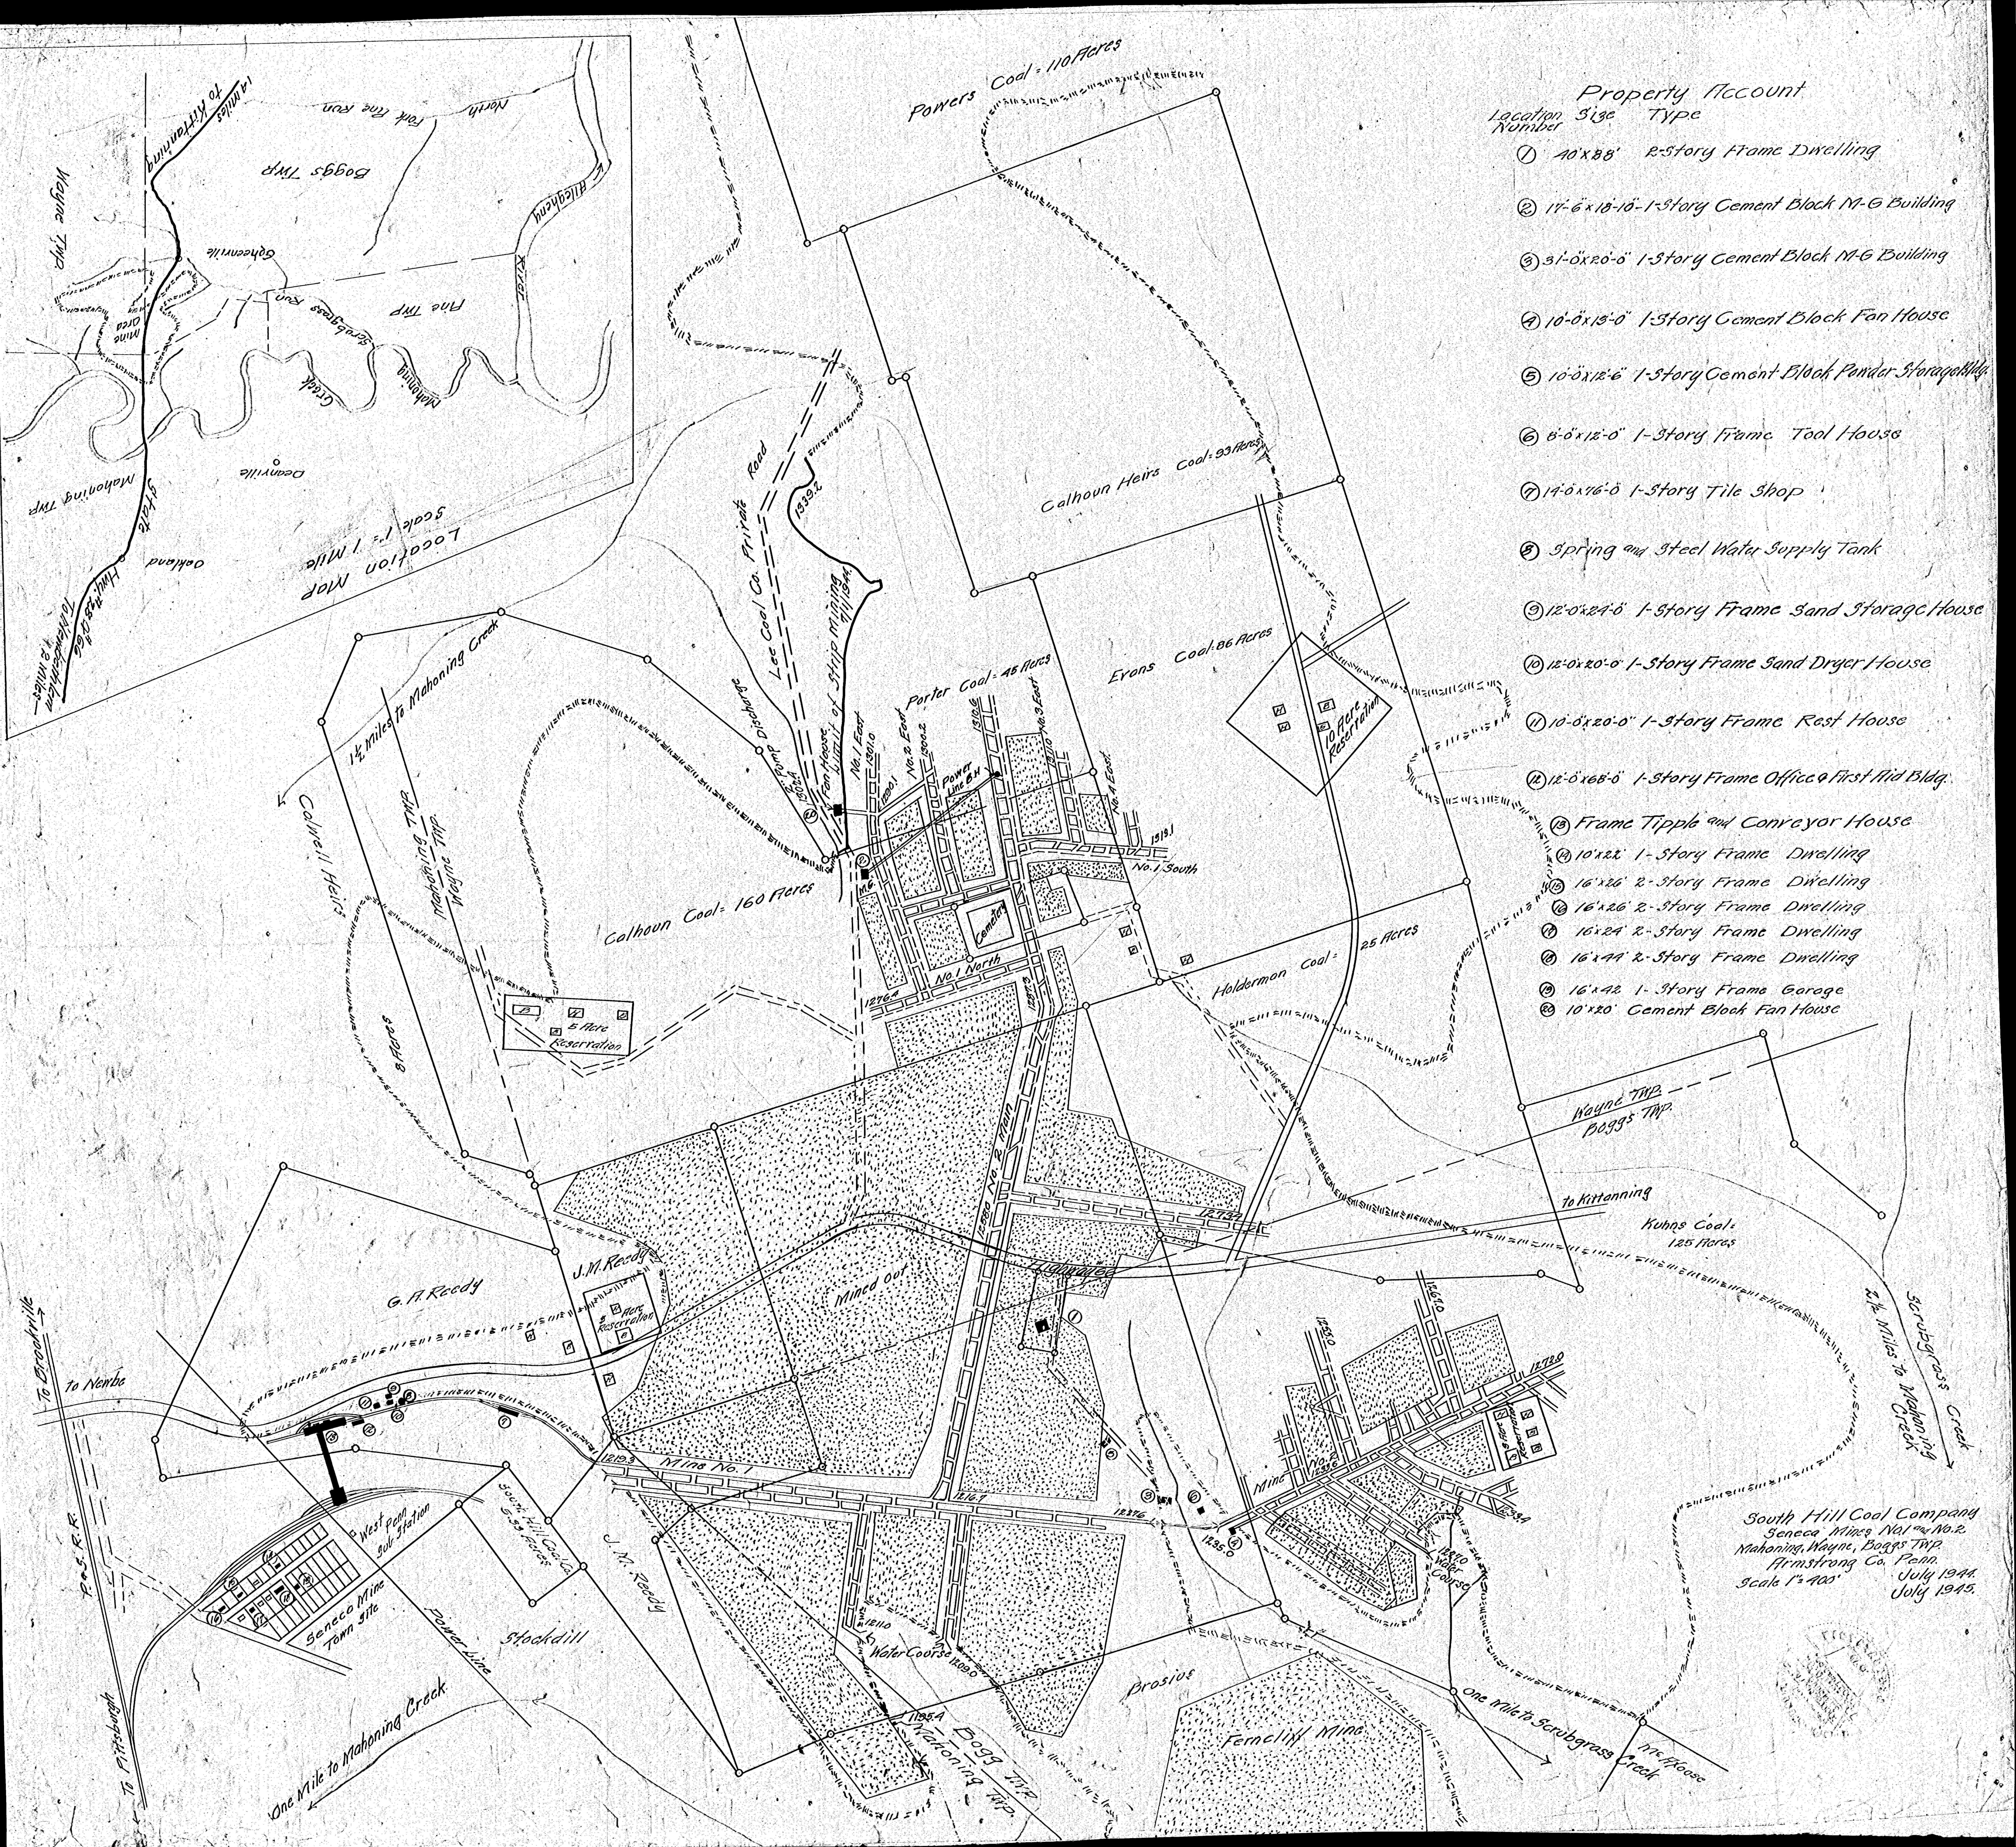

- Property Account
- | Location Number | Size | Type |
|-----------------|---------------|---|
| ① | 40'x88' | 2-story Frame Dwelling |
| ② | 17'-6"x18'-0" | 1-story Cement Block M-G Building |
| ③ | 31'-0"x20'-0" | 1-story Cement Block M-G Building |
| ④ | 10'-0"x13'-0" | 1-story Cement Block Fan House |
| ⑤ | 10'-0"x12'-6" | 1-story Cement Block Pender Storage Bldg. |
| ⑥ | 8'-0"x12'-0" | 1-story Frame Tool House |
| ⑦ | 14'-0"x16'-0" | 1-story Tile Shop |
| ⑧ | | Spring and Steel Water Supply Tank |
| ⑨ | 12'-0"x24'-0" | 1-story Frame Sand Storage House |
| ⑩ | 12'-0"x20'-0" | 1-story Frame Sand Dryer House |
| ⑪ | 10'-0"x20'-0" | 1-story Frame Rest House |
| ⑫ | 12'-0"x16'-0" | 1-story Frame Office & First Aid Bldg. |
| ⑬ | | Frame Tipple and Conveyor House |
| ⑭ | 10'x22' | 1-story Frame Dwelling |
| ⑮ | 16'x26' | 2-story Frame Dwelling |
| ⑯ | 16'x26' | 2-story Frame Dwelling |
| ⑰ | 16'x24' | 2-story Frame Dwelling |
| ⑱ | 16'x44' | 2-story Frame Dwelling |
| ⑲ | 16'x42' | 1-story Frame Garage |
| ⑳ | 10'x20' | Cement Block Fan House |

South Hill Coal Company
Seneca Mines No. 2
Mahoning, Wayne, Boggs Twp.
Armstrong Co. Penn.
July 1944
July 1945
Scale 1" = 400'