


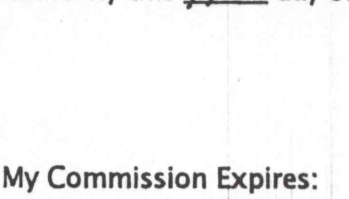
COPY

VESTA MINE
 FEDERAL I. D. NO. 36-00962
 FEDERAL I. D. NO. 36-07646
 SHEET 17 OF 18
 1" = 400' JANUARY 2001

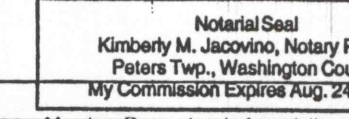
I, the undersigned, hereby certify that to the best of my knowledge and belief, this map is accurate as of January 19, 2001, and shows the mining as of June 23, 1987 as represented by Master Coal Lease on November 7, 1998 and shows all of the information required by the mining laws of this state.


 PETER L. LUTTRELL
 Registered Professional Engineer

Taken and sworn to before me the undersigned authority this 19th day of January 2001.


 Kimberley M. Jacobino
 Notary Public

My Commission Expires:


 Kimberley M. Jacobino, Notary Public
