


RECEIVED
DEPT. OF ENVIRONMENTAL PROTECTION
PA. DEPT. OF ENVIRONMENTAL PROTECTION
JAN 11 2001

RECEIVED
BUREAU OF WILDLIFE
JAN 11 2001

1

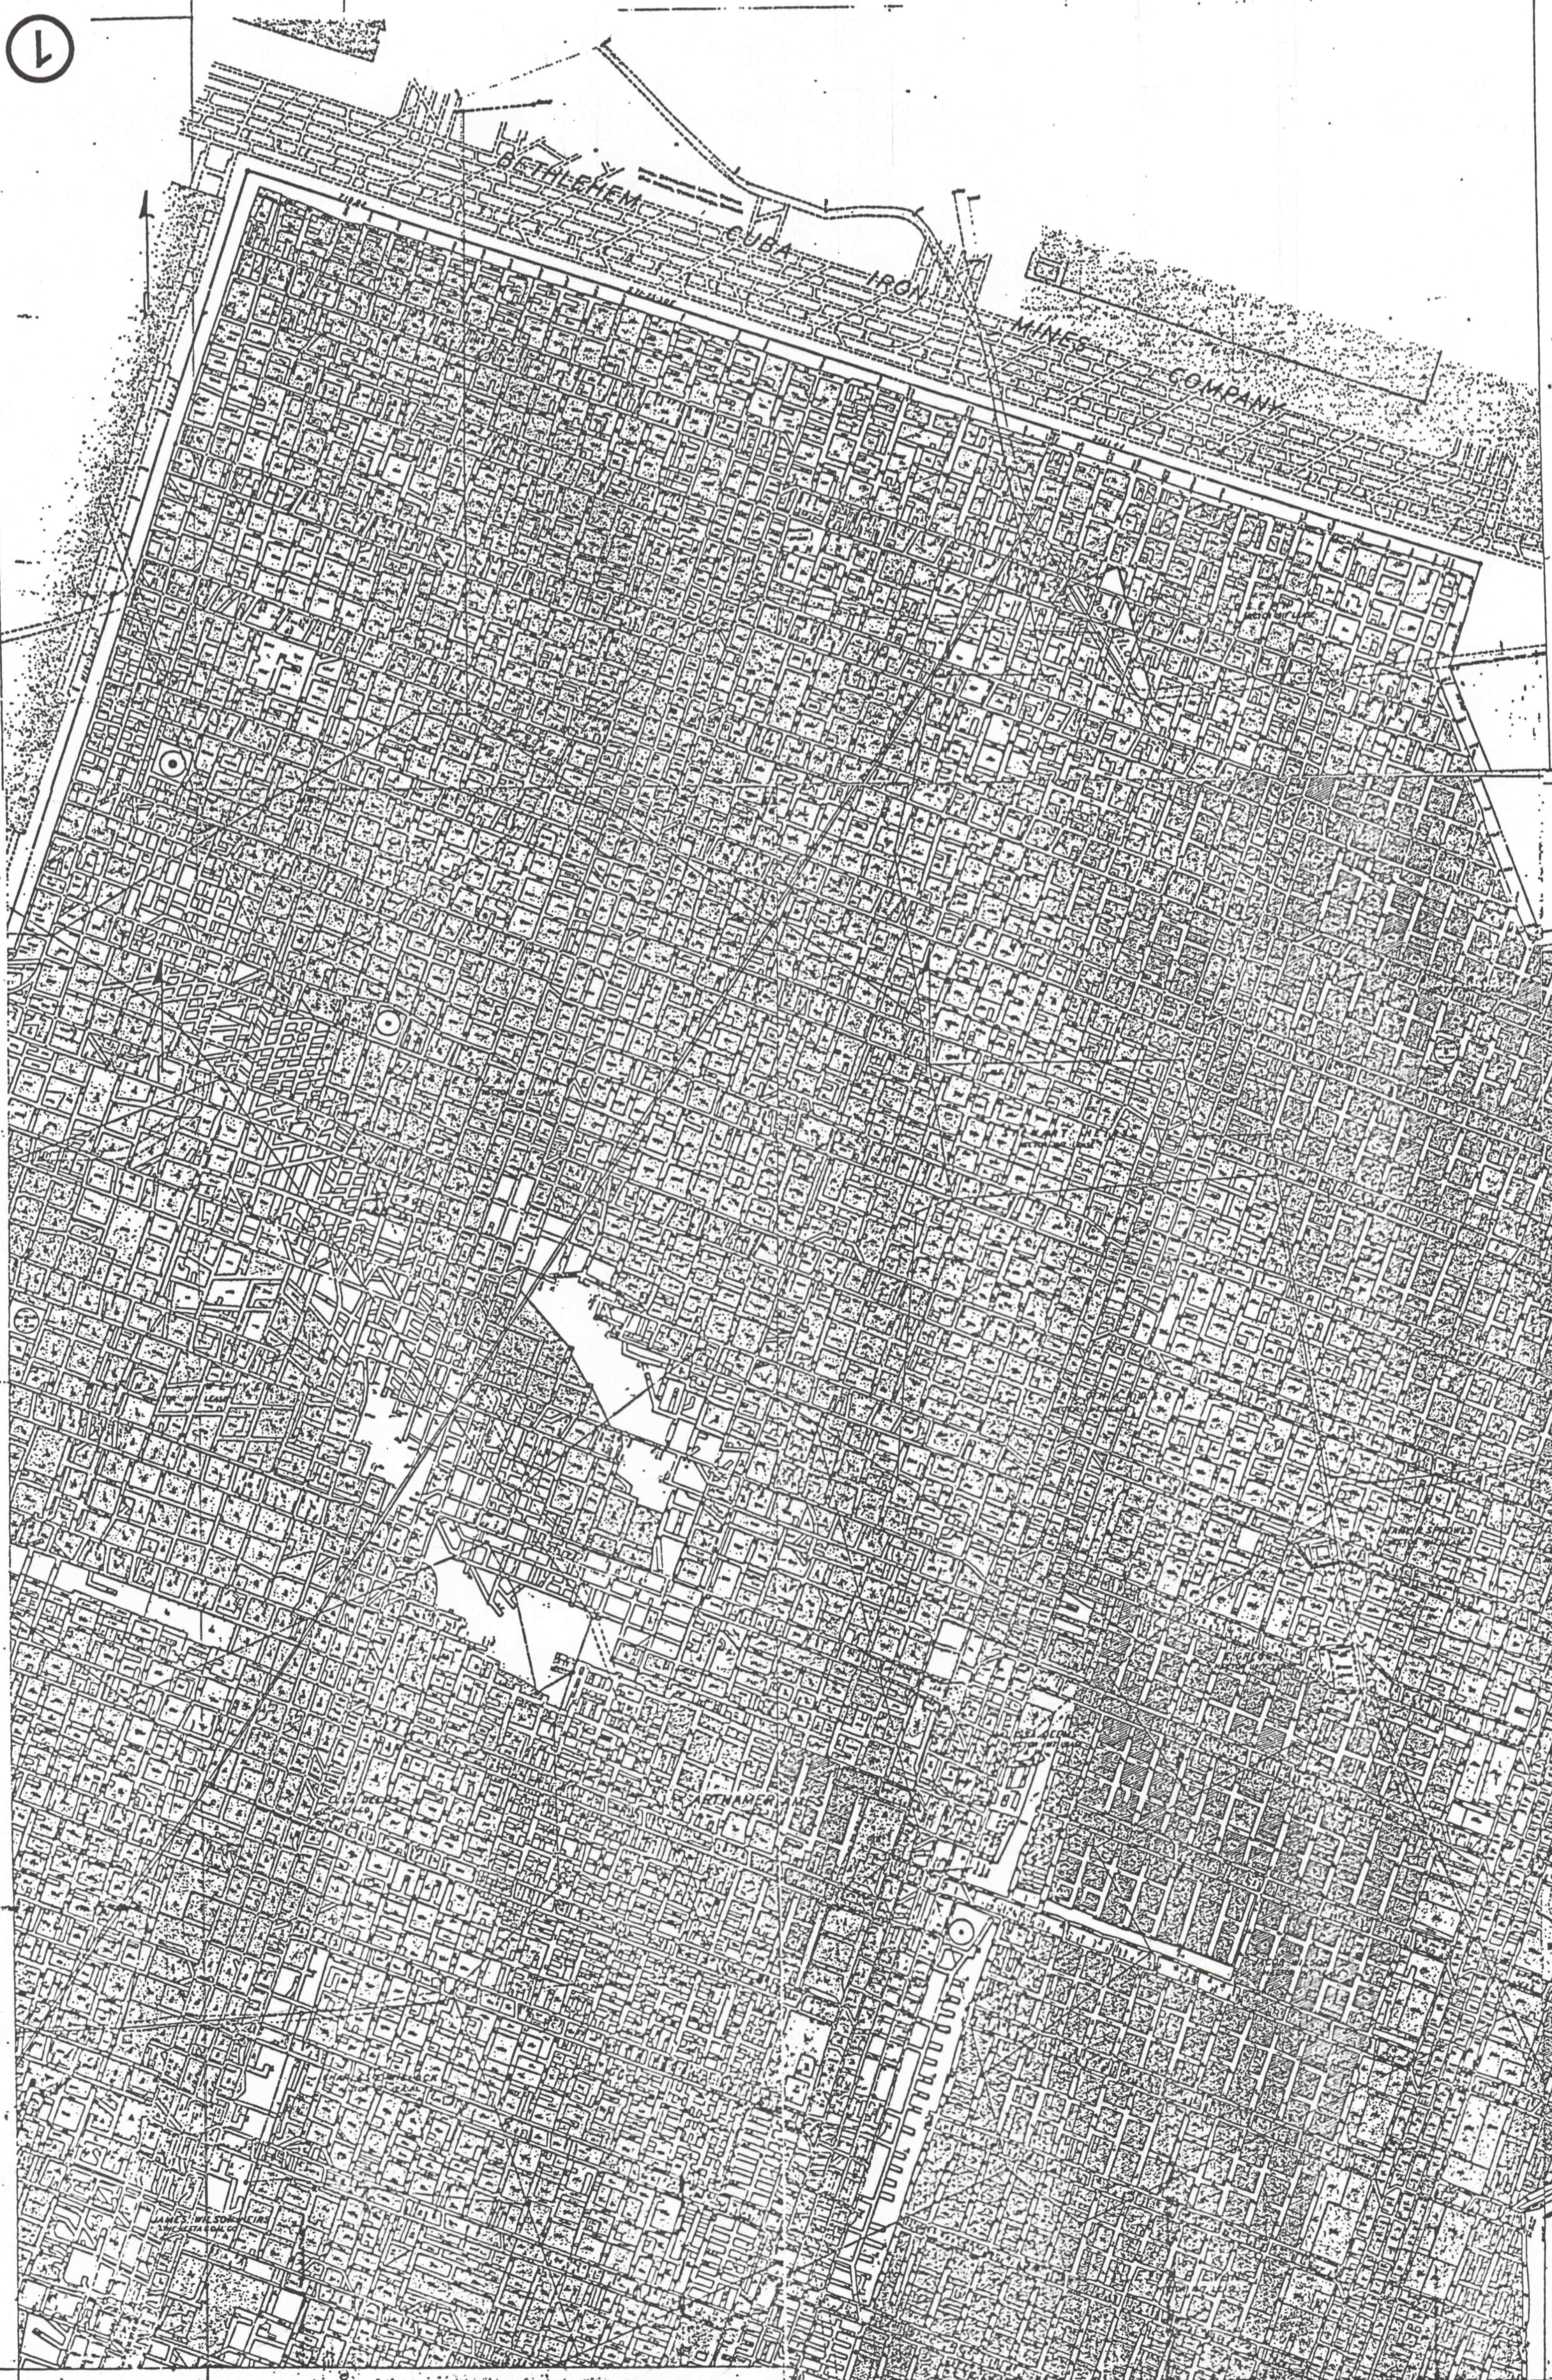

VESTA MINE
FEDERAL I. D. NO. 36-00962
FEDERAL I. D. NO. 36-07646
SHEET 1 OF 18
1" = 400' JANUARY 2001

I, the undersigned, hereby certify that to the best of my knowledge and belief this map is accurate as of January 19, 2001 and shows the findings as of June 23, 1987 as represented by Massey Coal Company on November 7, 1998 and shows all of the information required by the mining laws of this state.
M. J. Jacobino
Registered Professional Engineer

Taken subscribed and sworn to before me the undersigned authority this 19th day of January 2001.
Franklin J. Givens
Notary Public

My Commission Expires:
Notarial Seal
Kimberly M. Jacobino, Notary Public
Pleasant Twp., Washington County
My Commission Expires Aug. 24, 2004
Member, Pennsylvania Association of Notaries

↑

1