



No.	Name	Area		Ownership	Remarks
		B Seam	C Prime		
1	Elijah Berkay	25.34	25.34	B Prime Leased	C Prime Leased from
1-A	E. W. Berkay				
2	Chas. Barnett	76.90	76.90	B and C Prime Leased	Leased from Joe Lee Coal Co.
3	Emanuel Cash	260.00	230.00	B and C Prime Leased	
3-A	Emanuel Cash		20.00	C Prime Leased	Leased from Cash Est.
4	Samuel Y. Blough	147.53	147.53	Owned	
5	Jos. Thomas	11.61	11.61	B and C Prime Leased	Leased from N.Y. & Pa. C. & C. Co.
6	John J. Blough	110.91	110.91	Owned	
7	Jonathan Yoder	106.46	106.46	Owned	
8	Simon Lehman	140.87	140.87	Owned	
9	Jeremiah Blough	34.43	34.43	Owned	
10	Maria Lapp			Owned In Fee	
11	John Blough	1.08	1.08	Owned	
12	Mare Hoffmann	20.29	20.29	C Prime Leased	Leased from Geo. S. C. Co.
13	Mare Hoffmann	26.00	26.00	Owned	
14	Joseph Hoffman	69.77	69.77	Owned	
15	Mare Hoffman	22.24	22.24	Owned	
16	Joseph Hoffman	49.62	49.62	Owned	
27	Chas. Barnett		.09	Owned	
30	Chris Bager	8.49	8.49	B and C Prime Owned	
31	Henry J. Blough	106.97	106.97	Owned	
32	W. D. Berkay	59.85	59.85	Leased	Leased from Joe Lee Coal Co.
33	Anderson Lemmly	7.45	7.45	Owned	
34	Wagner (Dick)	59.85	59.85	Owned	Received from Moore & Co. 1922
35	Jacob Kaufman				All Mining Rights

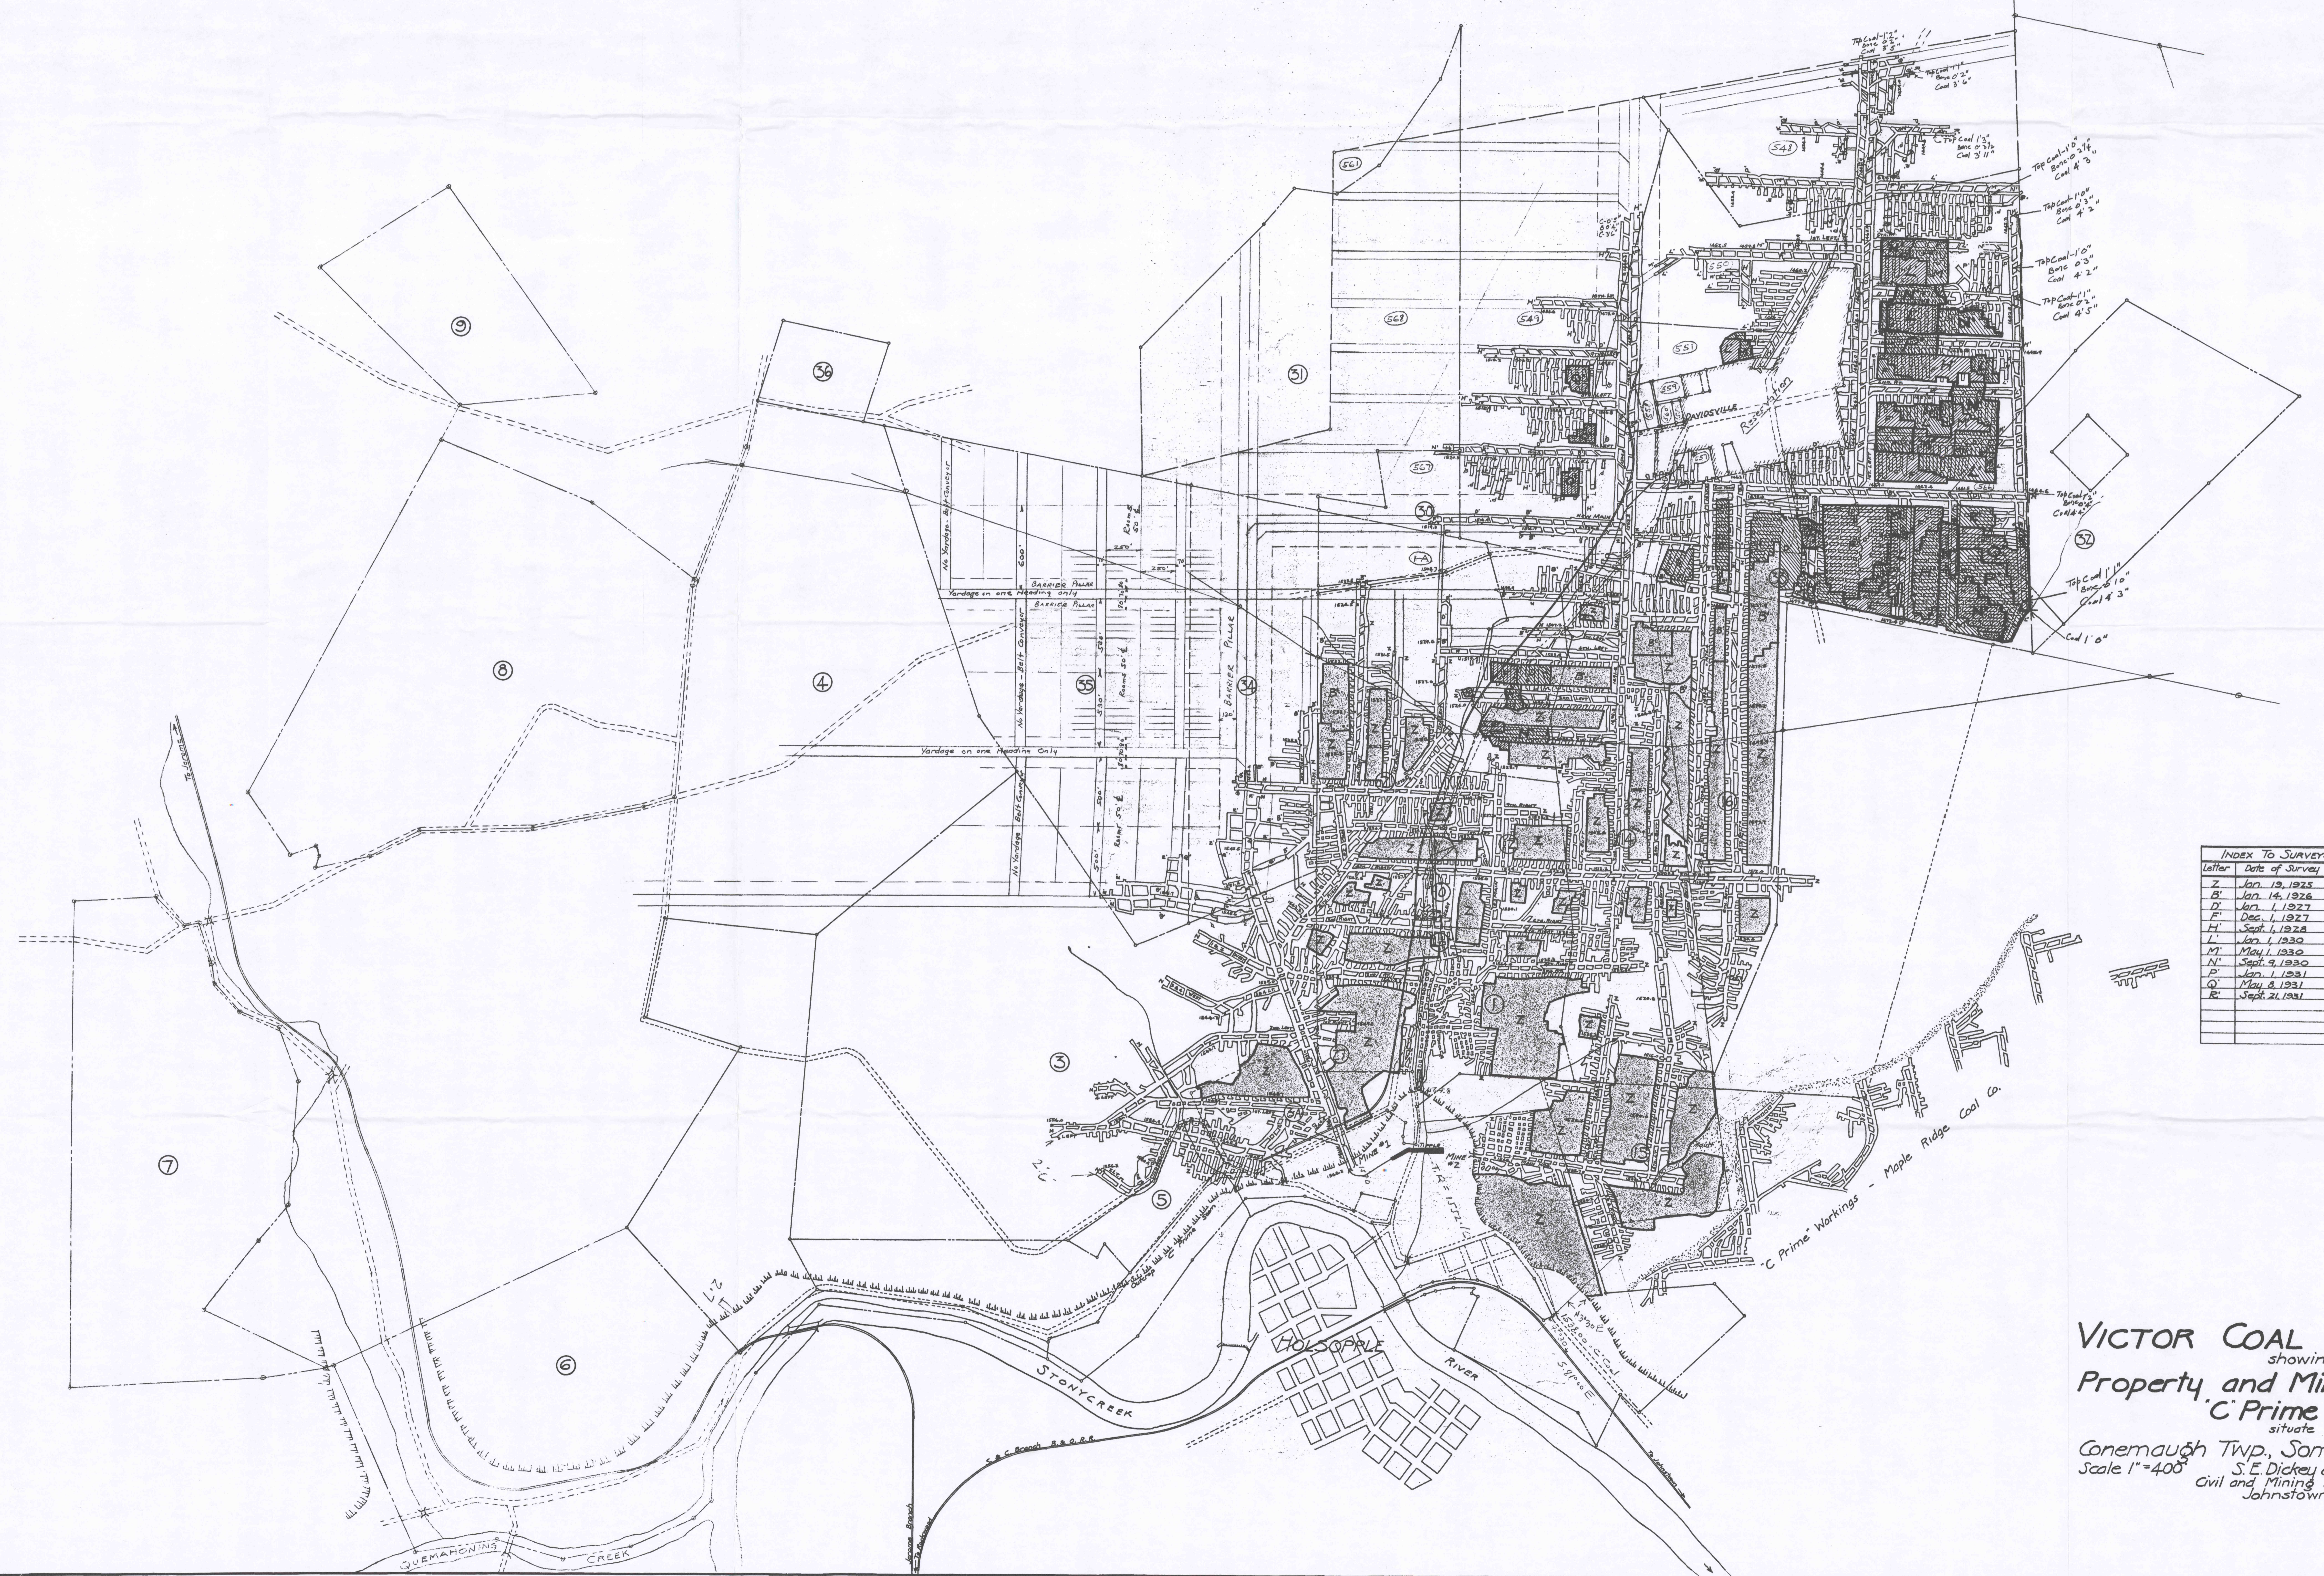

Letter	Date of Survey	Coal
Z	Jan. 19, 1926	Ave. Height
B	Jan. 14, 1926	
D	Jan. 1, 1927	
F	Dec. 1, 1927	
H	Sept. 1, 1928	
L	Jan. 1, 1930	
N	May 1, 1930	
P	Sept. 9, 1930	
Q	Jan. 1, 1931	
R	May 8, 1931	
S	Sept. 21, 1931	

VICTOR COAL MINING CO.
 showing
 Property and Mining Operations
 C Prime Seam
 situated in
 Conemaugh Twp., Somerset County, Pa.
 Scale 1"=400'
 S. E. Dickey and Co. Feb. 15, 1926.
 Civil and Mining Engineers
 Johnstown, Pa.

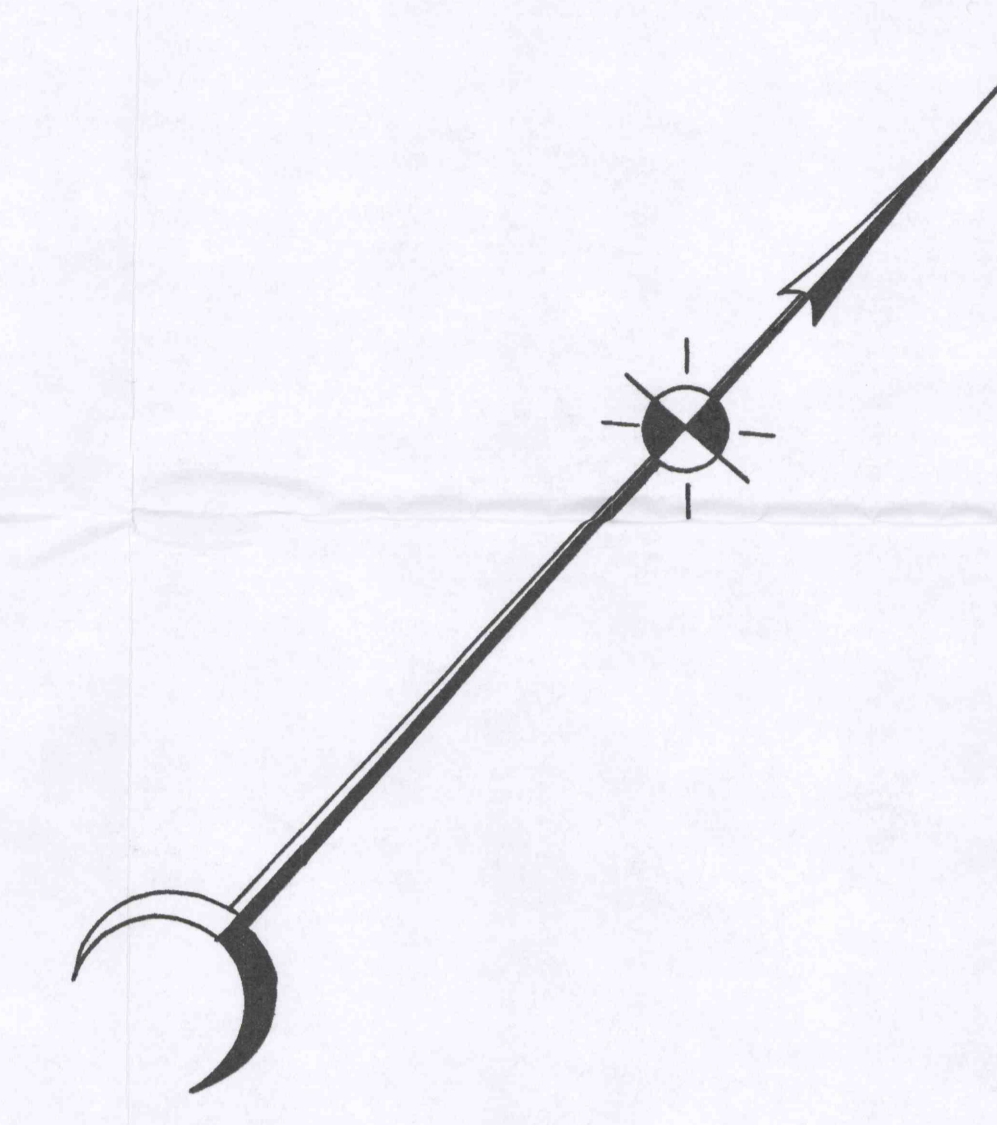