



No.	Name	Area		Ownership	Remarks
		B Seam	C Prime		
1	Elijah Berkay	25.34	25.34	Owned	Leased from
1A	E. H. Berkay			Owned	Leased from
2	Chas. Barnard	76.90	76.90	Land C Prime Leased	Leased from Joe-Lee Coal Co.
3	Emmanuel Eash	260.00	230.00	Land C Prime Owned	
3A	Emmanuel Eash		20.00	C Prime Leased	Leased from Eash Est.
4	Samuel Y. Blough	147.53	147.53	Owned	
5	Joe Thomas	11.61	11.61	Land C Prime Leased	Leased from K&A P. C. Co.
6	John J. Blough	110.91	56.30	Owned	
7	Jonathan Yoder	104.44	104.44	Owned	
8	Simon Lehman	140.87	-	Owned	
9	Jeremiah Blough	34.43	34.43	Owned in Fee	
10	Maria Lipe			Owned in Fee	
11	John Blough	1.08		Owned	
12	Kore Kauffman	202.8		C Prime Leased	Leased from Geo S. C. Co.
13	Kore Kauffman	24.00		Owned	
14	Joseph Hoffman	69.77		Owned	
15	Haron Thomas	22.56		Owned	
16	Joseph Hoffman	48.82		Owned	
21	Chas. Barnard			Owned	
30	Chris Bear	8.41	8.41	Land C Prime Owned	
31	Simon J. Blough	104.87		Owned	
32	W. D. Berkay	59.85		Leased	Leased from Joe-Lee Coal Co.
33	Anderson Donnelly	7.88	7.88	Owned	
34	Warren (Dick)	59.85	59.85	Owned	Leased from Mhuir Co. & Co.
53b	Jacob I. Kaufman				All mining rights

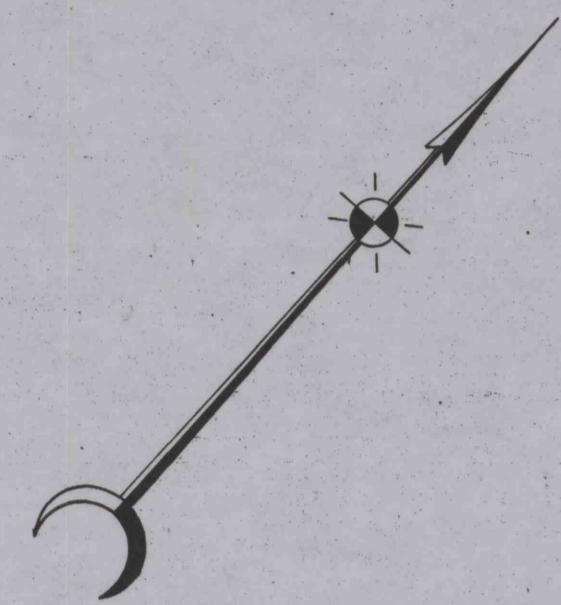

Letter	Date of Survey	Coal Ave. Height
V	Jan. 15, 1925.	
X	Jan. 12, 1926.	
Z	Jan. 1, 1927.	
B	Dec. 6, 1927.	
D	Oct. 4, 1928.	
E	Sept. 12, 1930.	
F	Jan. 12, 1931.	
G	May 8, 1934.	

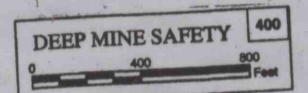

**VICTOR COAL MINING CO.**  
 showing  
**Property and Mining Operations**  
**B Seam**  
 situate in  
 Conemaugh Twp., Somerset County, Pa.  
 Scale 1"=400'  
 S.E. Dickey and Co. Feb. 13, 1926.  
 Civil and Mining Engineers  
 Johnstown, Pa.