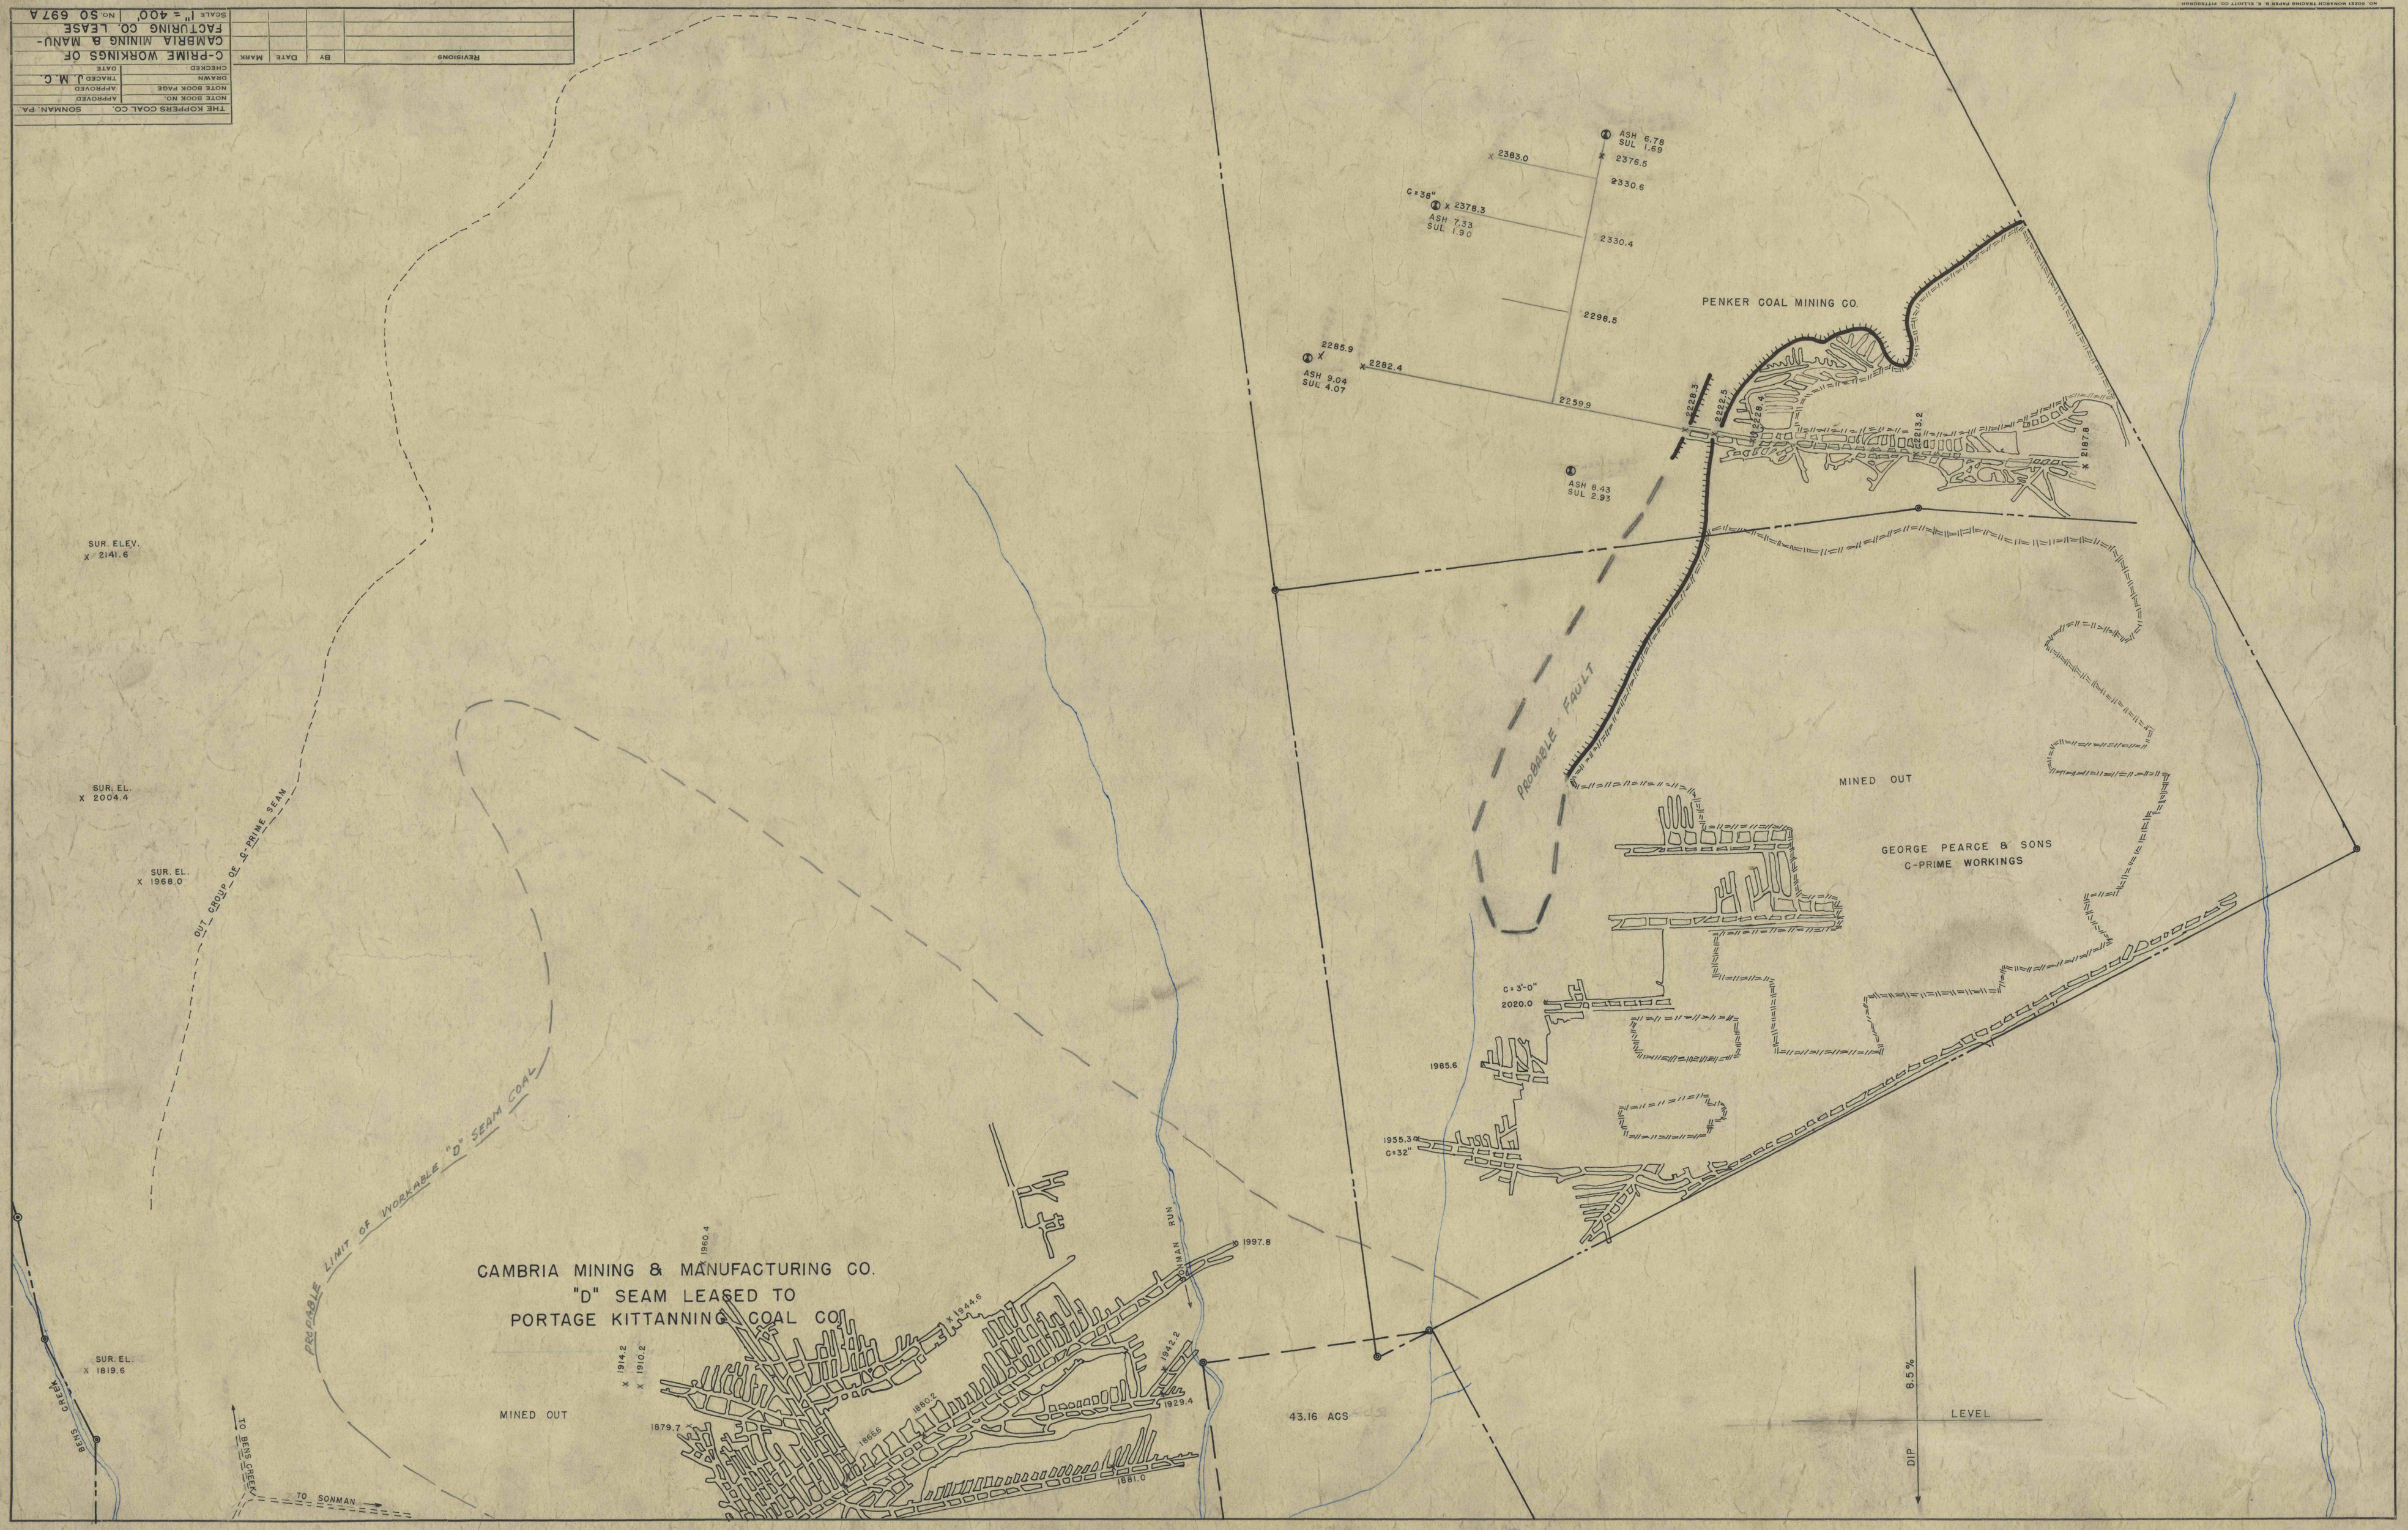

THE KOPPERS COAL CO. SONMAN, PA.
NOTE BOOK NO.
APPROVED
NOTE BOOK PAGE
APPROVED
DRAWN
TRACED J. M. C.
CHECKED
DATE
C-PRIME WORKINGS OF
CAMBRIA MINING & MANU-
FACTURING CO. LEASE
SCALE 1" = 400'
No. SO 697 A
REVISIONS
BY
DATE
MARK
ASH 6.78
SUL 1.69
2383.0
2376.5
2330.6
C=38"
2378.3
ASH 7.33
SUL 1.90
2330.4
2298.5
PENKER COAL MINING CO.
2285.9
2282.4
ASH 9.04
SUL 4.07
2259.9
2228.3
2222.5
2228.4
2213.2
2187.8
ASH 8.43
SUL 2.93
SUR. ELEV.
2141.6
PROBABLE FAULT
MINED OUT
SUR. EL.
2004.4
GEORGE PEARCE & SONS
C-PRIME WORKINGS
SUR. EL.
1968.0
OUT CROUP OF C-PRIME SEAM
C=3'-0"
2020.0
1985.6
1955.3
C=32"
PROBABLE LIMIT OF WORKABLE "D" SEAM COAL
1960.4
1997.8
SONMAN RUN
CAMBRIA MINING & MANUFACTURING CO.
"D" SEAM LEASED TO
PORTAGE KITTANNING COAL CO.
1944.6
1942.2
1914.2
1910.2
SUR. EL.
1819.6
1929.4
MINED OUT
1879.7
1880.2
1866.6
43.16 ACS
8.5%
LEVEL
DIP
BENS CREEK
TO BENS CREEK
TO SONMAN
1881.0