

PURCHASED JANUARY 14, 1983 BY THE ROCHESTER & PITTSBURGH COAL COMPANY.


Bureau of Mine Safety
 AUG 2 2008
 RECEIVED

B.I. NO.	COMPLETION ACRES	STAGE OF RECLAMATION	DATE	C.R. NO.	STATUS
01(R)	32.5	III	4-20-90	3-90-047	FIVE YEAR LIABILITY PERIOD HAS ELAPSED STAGE III RELEASED
01(R)	47.7	III	5-19-93	3-90-047	FIVE YEAR LIABILITY PERIOD HAS ELAPSED STAGE III RELEASED
01(R)	18.1	III	5-19-93	3-90-077	FIVE YEAR LIABILITY PERIOD HAS ELAPSED STAGE III RELEASED
01(R)	39.1	III	8-29-95	3-93-061	FIVE YEAR LIABILITY PERIOD HAS ELAPSED TREES PLANTED

B.I. NO.	COMPLETION ACRES	STAGE OF RECLAMATION	DATE	COMPLETION REPORT NO.	STATUS
01	32.5	I-II	8-19-85	3-85-101	STAGE I-II RELEASED
01	63.5	I	12-18-86	386208	STAGE I RELEASED
01	41.4	I	8-22-88	388172	STAGE I RELEASED

MINING AUTHORIZATION NO. 101937-32823057-01(R)

% OF BOND REMAINING	0%	0%	40%	TOTALS
MINING SEQUENCE	I	II		
SUBTOTAL AREA	19.0 AC.	213 AC.	18.4 AC.	587 AC.
0'-85' HIGHWALL	1.0 AC.	0	4.4 AC.	5.4 AC.
85'-120' HIGHWALL	7.8 AC.	11.8 AC.	12.4 AC.	32.0 AC.
120'-150' HIGHWALL	3.2 AC.	14.6 AC.	1.3 AC.	19.1 AC.
150' PLUS	1.5 AC.	16.8 AC.	1.2 AC.	19.5 AC.
TOTAL AFFECTED	32.5 AC.	65.8 AC.	39.1 AC.	137.4 AC.

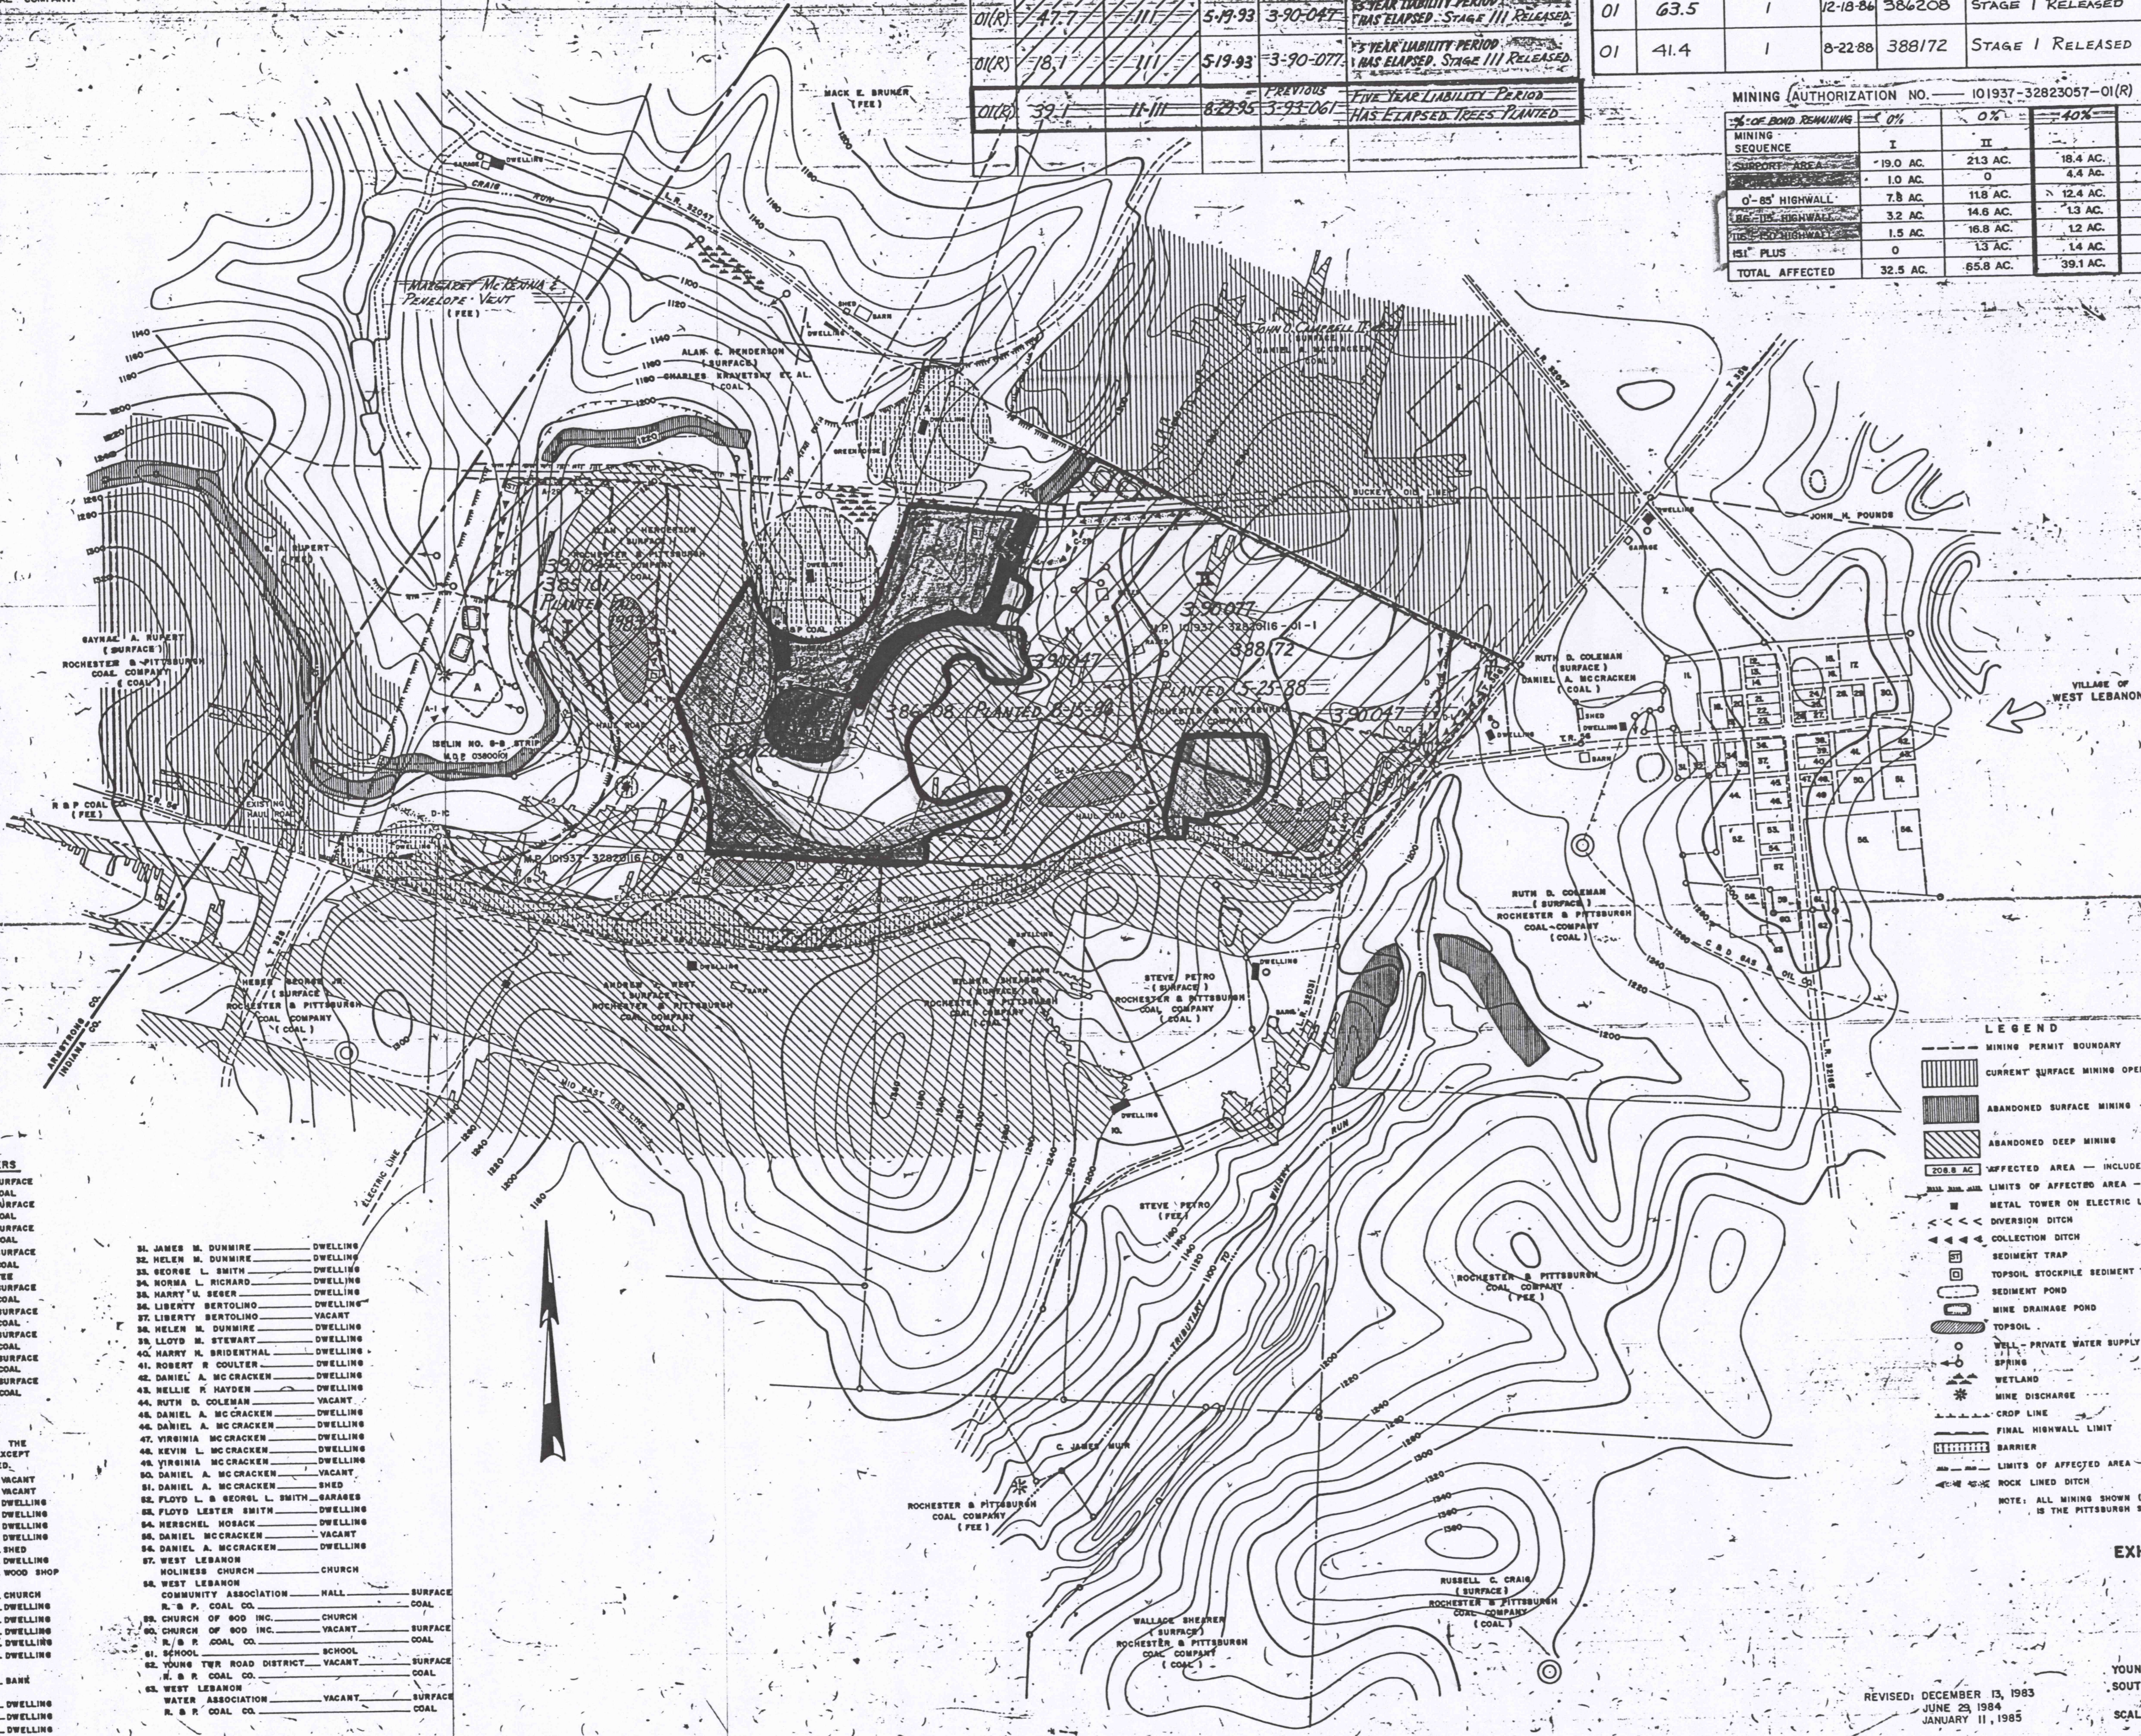

- INDEX TO PROPERTY OWNERS**
- DANIEL A. MCCracken SURFACE
 - CHARLES KRIVETSKY, ET AL. COAL
 - CARL G. HENDERSON SURFACE
 - CHARLES KRIVETSKY, ET AL. COAL
 - DANIEL A. MCCracken COAL
 - R. & P. COAL CO. SURFACE
 - DANIEL A. MCCracken COAL
 - R. & P. COAL CO. SURFACE
 - DANIEL A. MCCracken COAL
 - R. & P. COAL CO. SURFACE
 - DANIEL A. MCCracken COAL
 - RICHARD J. TRAM SURFACE
 - MICHAEL A. BERTOLINO SURFACE
 - R. & P. COAL CO. COAL
 - JAMES H. DUNNIRE DWELLING
 - HELEN M. DUNNIRE DWELLING
 - GEORGE L. SMITH DWELLING
 - NORMA L. RICHARD DWELLING
 - HARRY M. SEER DWELLING
 - LIBERTY BERTOLINO DWELLING
 - LIBERTY BERTOLINO VACANT
 - HELEN M. DUNNIRE DWELLING
 - LLOYD M. STEWART DWELLING
 - HARRY M. BRIDESTHAL DWELLING
 - ROBERT R. COULTER DWELLING
 - DANIEL A. MCCracken DWELLING
 - WELLIE R. HAYDEN DWELLING
 - RUTH D. COLEMAN VACANT
 - DANIEL A. MCCracken DWELLING
 - DANIEL A. MCCracken DWELLING
 - VERONICA MCCracken DWELLING
 - KEVIN L. MCCracken DWELLING
 - YVONNE A. MCCracken DWELLING
 - DANIEL A. MCCracken VACANT
 - DANIEL A. MCCracken SHED
 - FLOYD L. & GEORGE L. SMITH SARARAS DWELLING
 - FLOYD LESTER SMITH DWELLING
 - MERCEDES HORACK DWELLING
 - DANIEL MCCracken VACANT
 - DANIEL A. MCCracken DWELLING
 - WEST LEBANON HOLINESS CHURCH CHURCH
 - WEST LEBANON COMMUNITY HALL SURFACE
 - R. & P. COAL CO. COAL
 - CHURCH OF GOD INC. CHURCH
 - CHURCH OF GOD INC. VACANT SURFACE
 - R. & P. COAL CO. COAL
 - SCHOOL SCHOOL
 - YOUNG TWP ROAD DISTRICT VACANT SURFACE
 - R. & P. COAL CO. COAL
 - WEST LEBANON WATER ASSOCIATION VACANT SURFACE
 - R. & P. COAL CO. COAL
 - ESTHER W. LANSHAW DWELLING
 - MARION C. JOHNSON DWELLING
 - MIKE BERTOLINO DWELLING
 - JOHN VELEIS DWELLING
 - JOHN A. VELEIS DWELLING
 - PEOPLES BANK OF WEST LEBANON BANK
 - PEOPLES BANK OF WEST LEBANON DWELLING
 - JOHN B. VELEIS DWELLING
 - BLERN DIXON DWELLING
 - HELEN F. COLLINS DWELLING


LEGEND

- Mining Permit Boundary
- Current Surface Mining Operation - Being Backfilled
- Abandoned Surface Mining - Not Reclaimed
- Abandoned Deep Mining
- Affected Area - Includes 3.6 AC. Insignificant Boundary Correction - June 1984
- Limits of Affected Area - Mine Drainage Permit Boundary
- Metal Tower on Electric Line
- Diversion Ditch
- Collection Ditch
- Sediment Trap
- Topsoil Stockpile Sediment Trap
- Sediment Pond
- Mine Drainage Pond
- Topsoil
- Well - Private Water Supply
- Spring
- Wetland
- Mine Discharge
- Crop Line
- Final Highwall Limit
- Barrier
- Limits of Affected Area - Iselin No. 9-B Strip
- Rock Lined Ditch

NOTE: ALL MINING SHOWN (ACTIVE, ABANDONED, PROPOSED) IS THE PITTSBURGH SEAM



EXHIBIT 9: OPERATIONS MAP
 KENT COAL MINING COMPANY
 SURFACE MINING PERMIT
ISELIN STRIP NO. 15
 YOUNG TWP. INDIANA CO.
 SOUTH BEND TWP. ARMSTRONG CO.
 SCALE 1" = 400'
 MARCH 9, 1983
 DRN. BY T. STORMER

REVISED: DECEMBER 13, 1983
 JUNE 23, 1984
 JANUARY 11, 1985

MINING SEQUENCE I II
 POTENTIAL AUGER AREA