


34-A-8

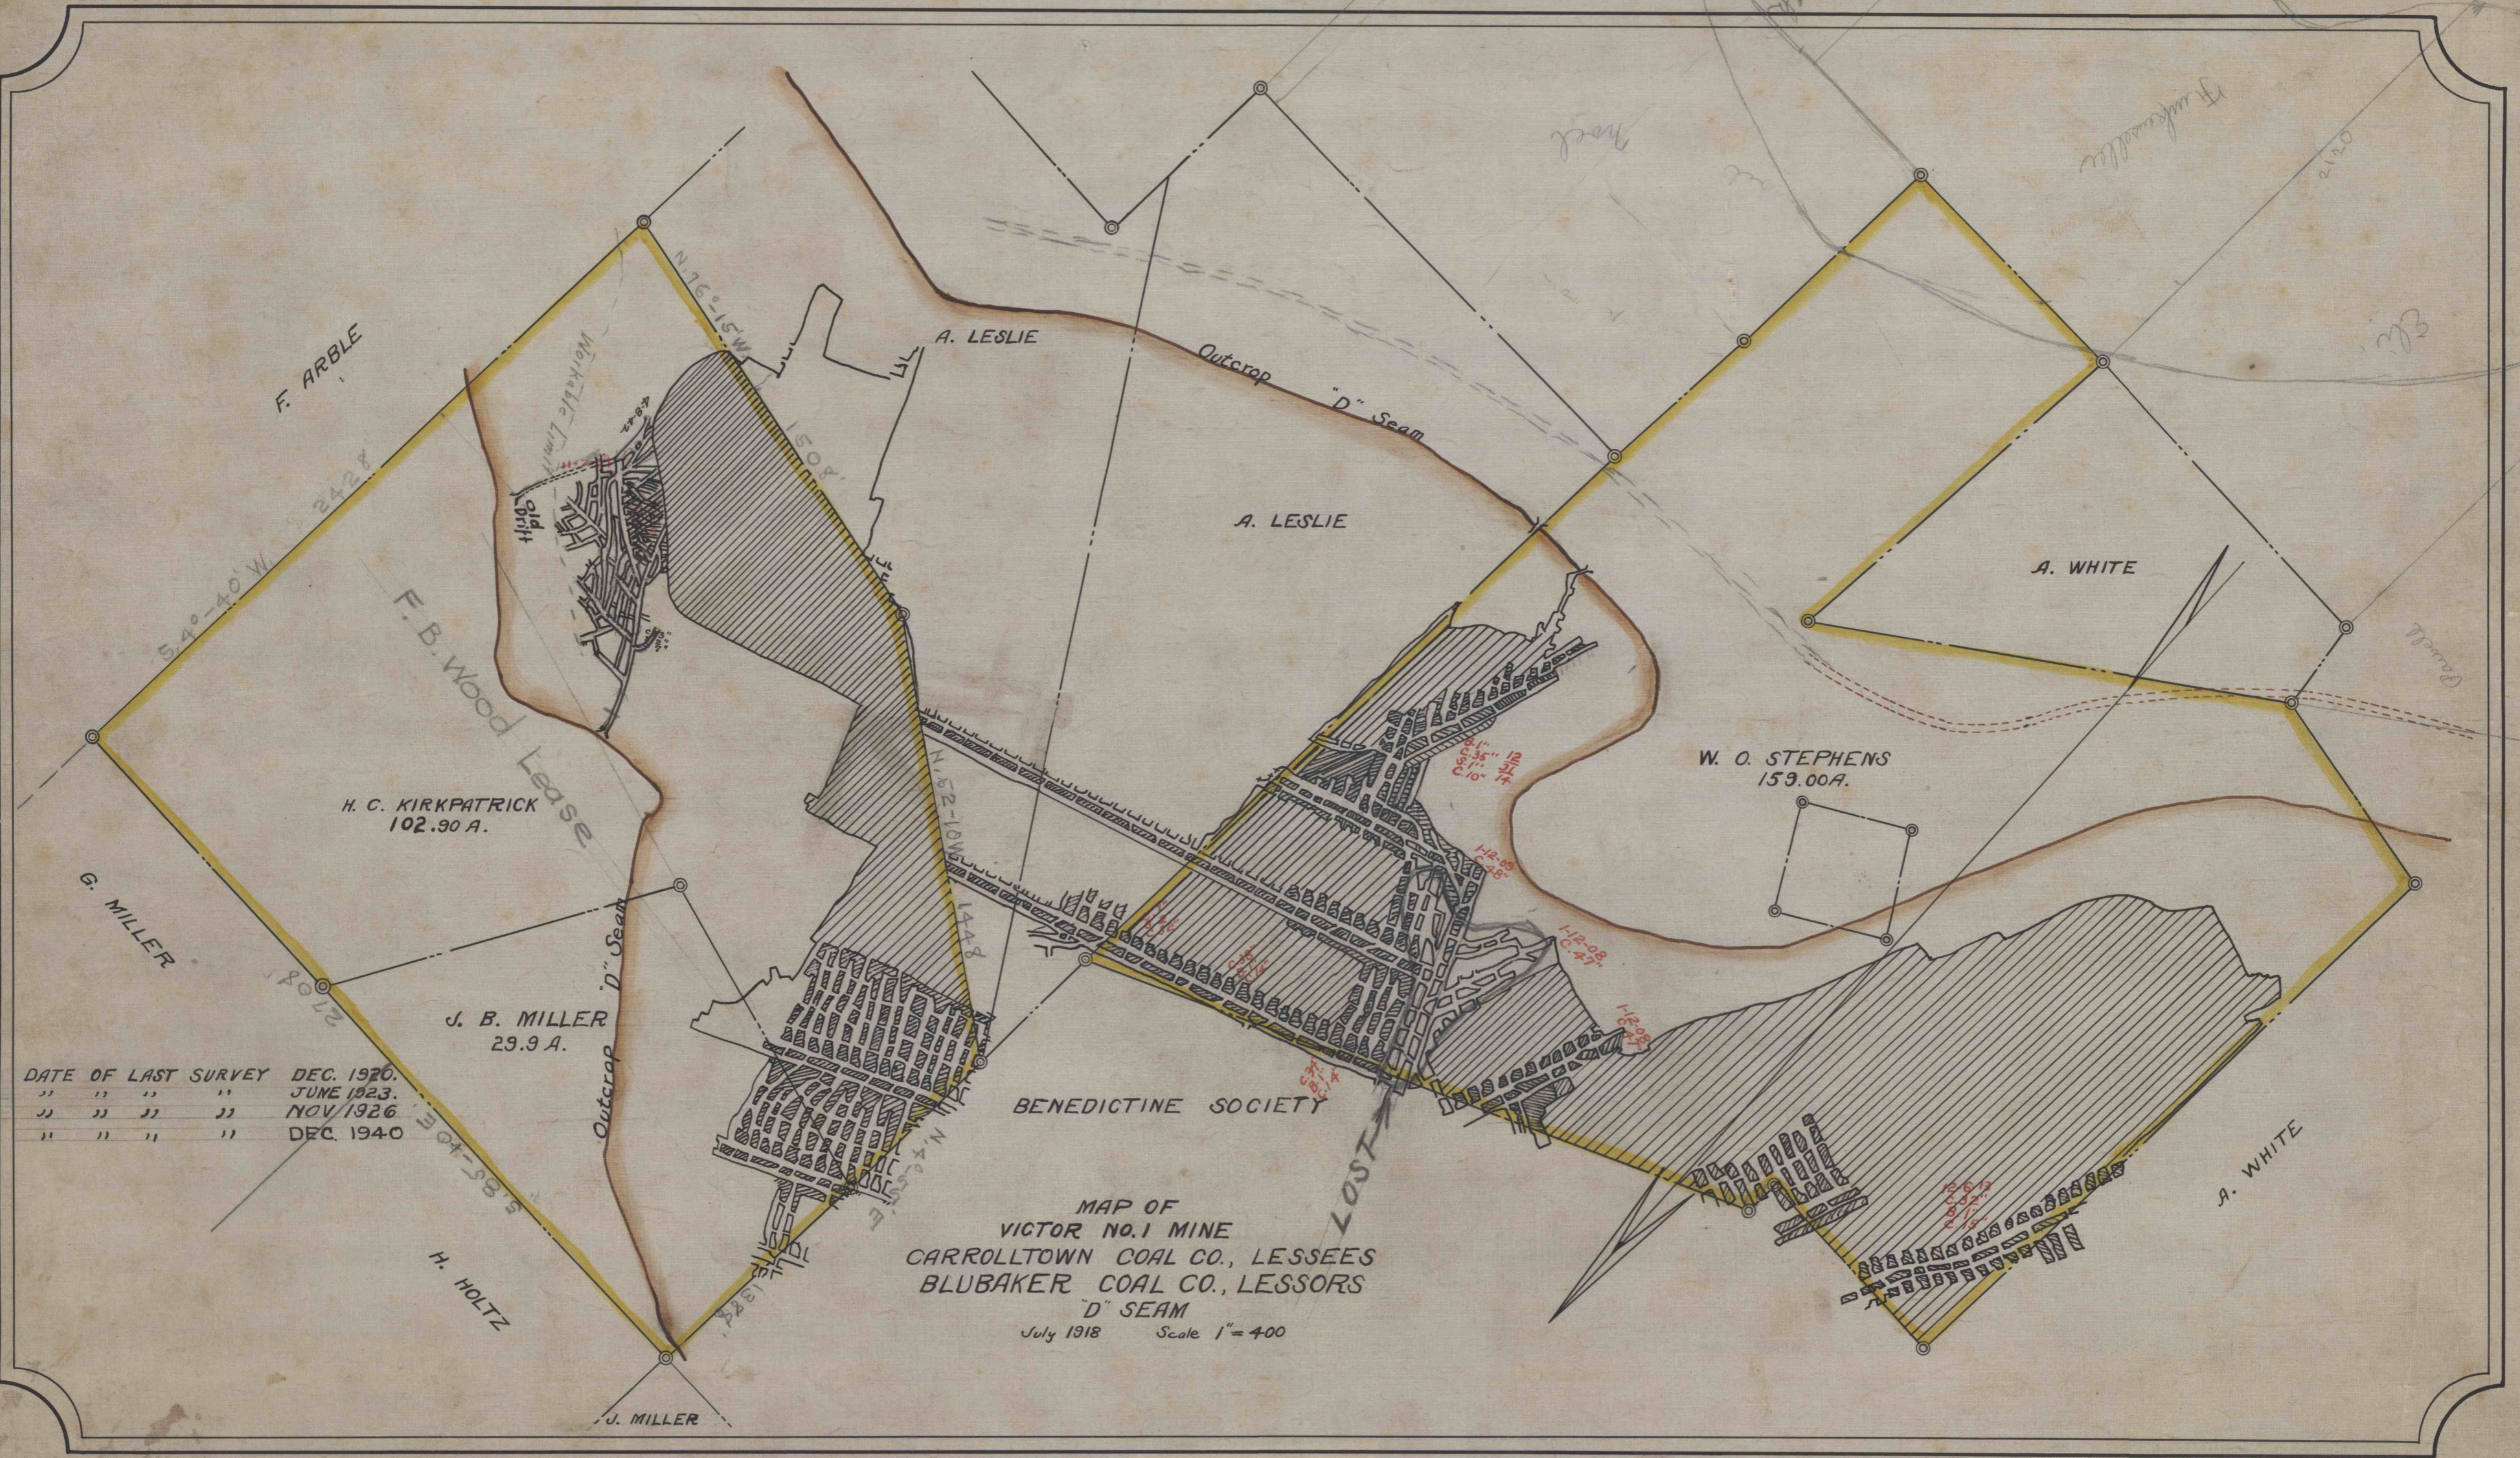

DATE OF LAST SURVEY	DEC. 1920.
" " " "	JUNE 1923.
" " " "	NOV 1926
" " " "	DEC. 1940

MAP OF
 VICTOR NO. 1 MINE
 CARROLLTOWN COAL CO., LESSEES
 BLUBAKER COAL CO., LESSORS
 "D" SEAM
 July 1918 Scale 1" = 400

B-5468