


COAL LANDS IN WEST CARROLL TWP,  
 CAMBRIA COUNTY, PA.,  
 THE "D" SEAM ON WHICH IS TO BE LEASED BY  
 THE BLUBAKER COAL COMPANY & PHILIP N. SHETTIG  
 TO FRANK B. WOOD, JR.

~~Feb. 1944~~  
 sept. 1946.

scale - 1" = 400'

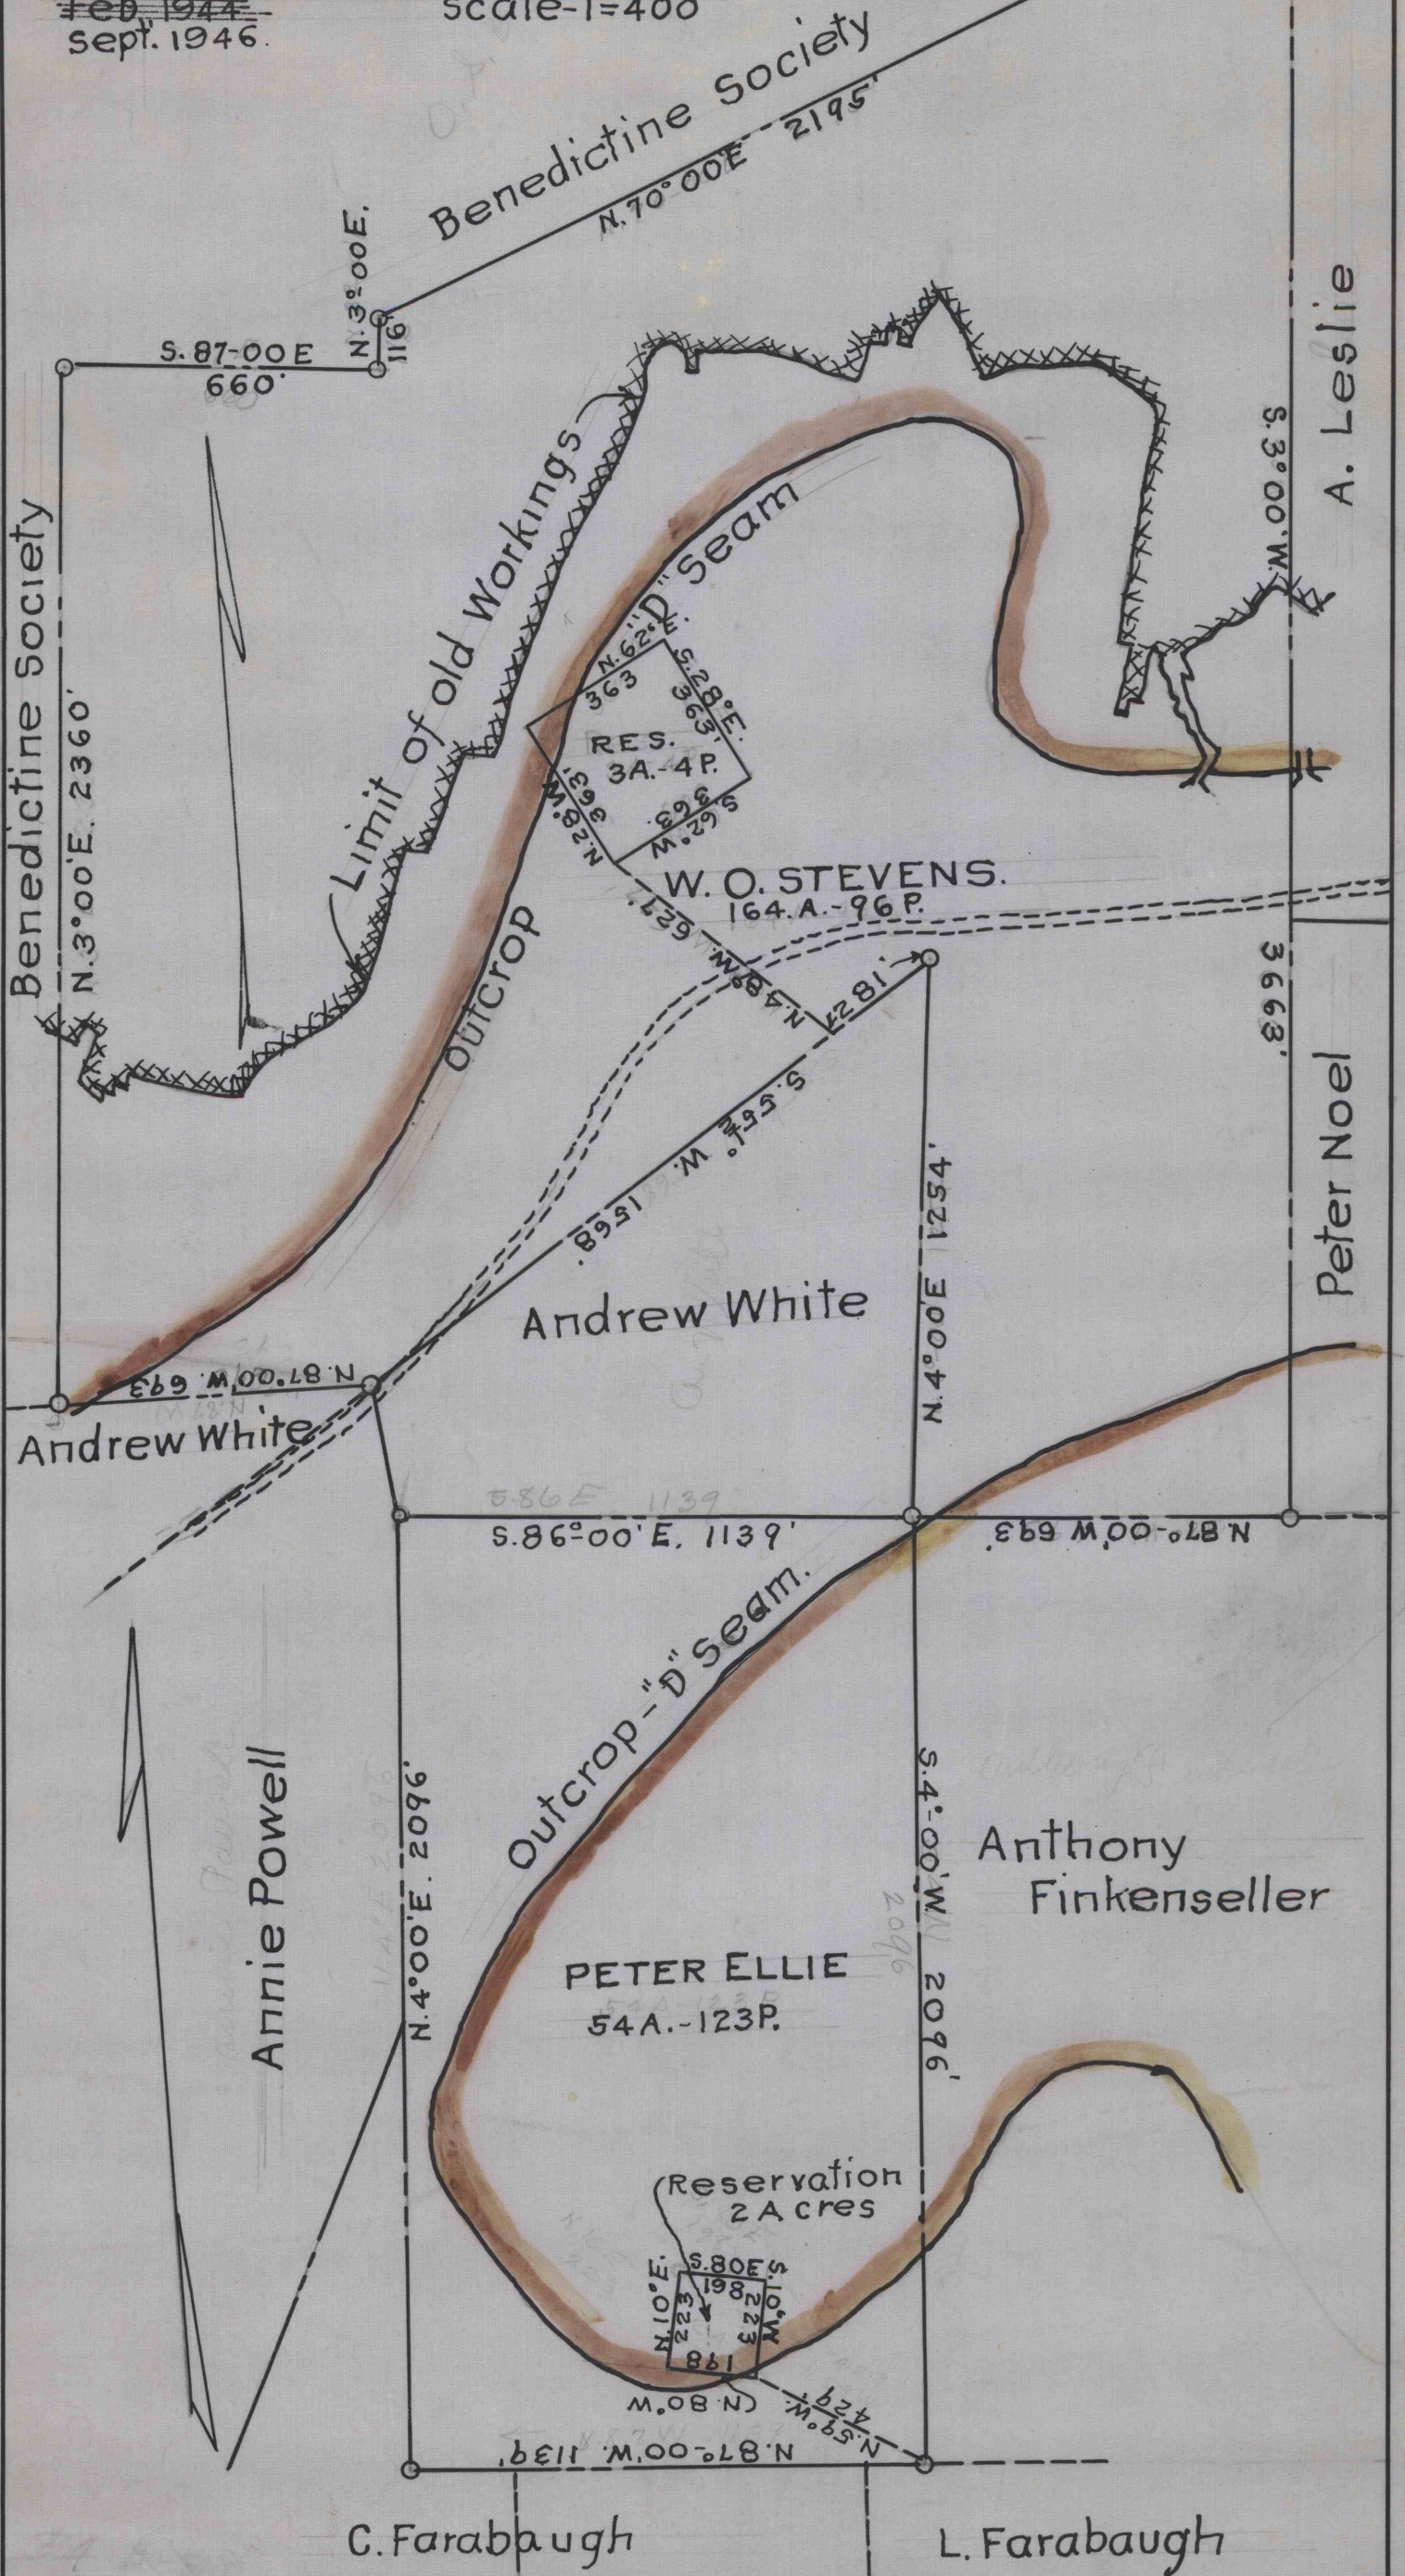

34-B-80

R-54177  
 R-4163