
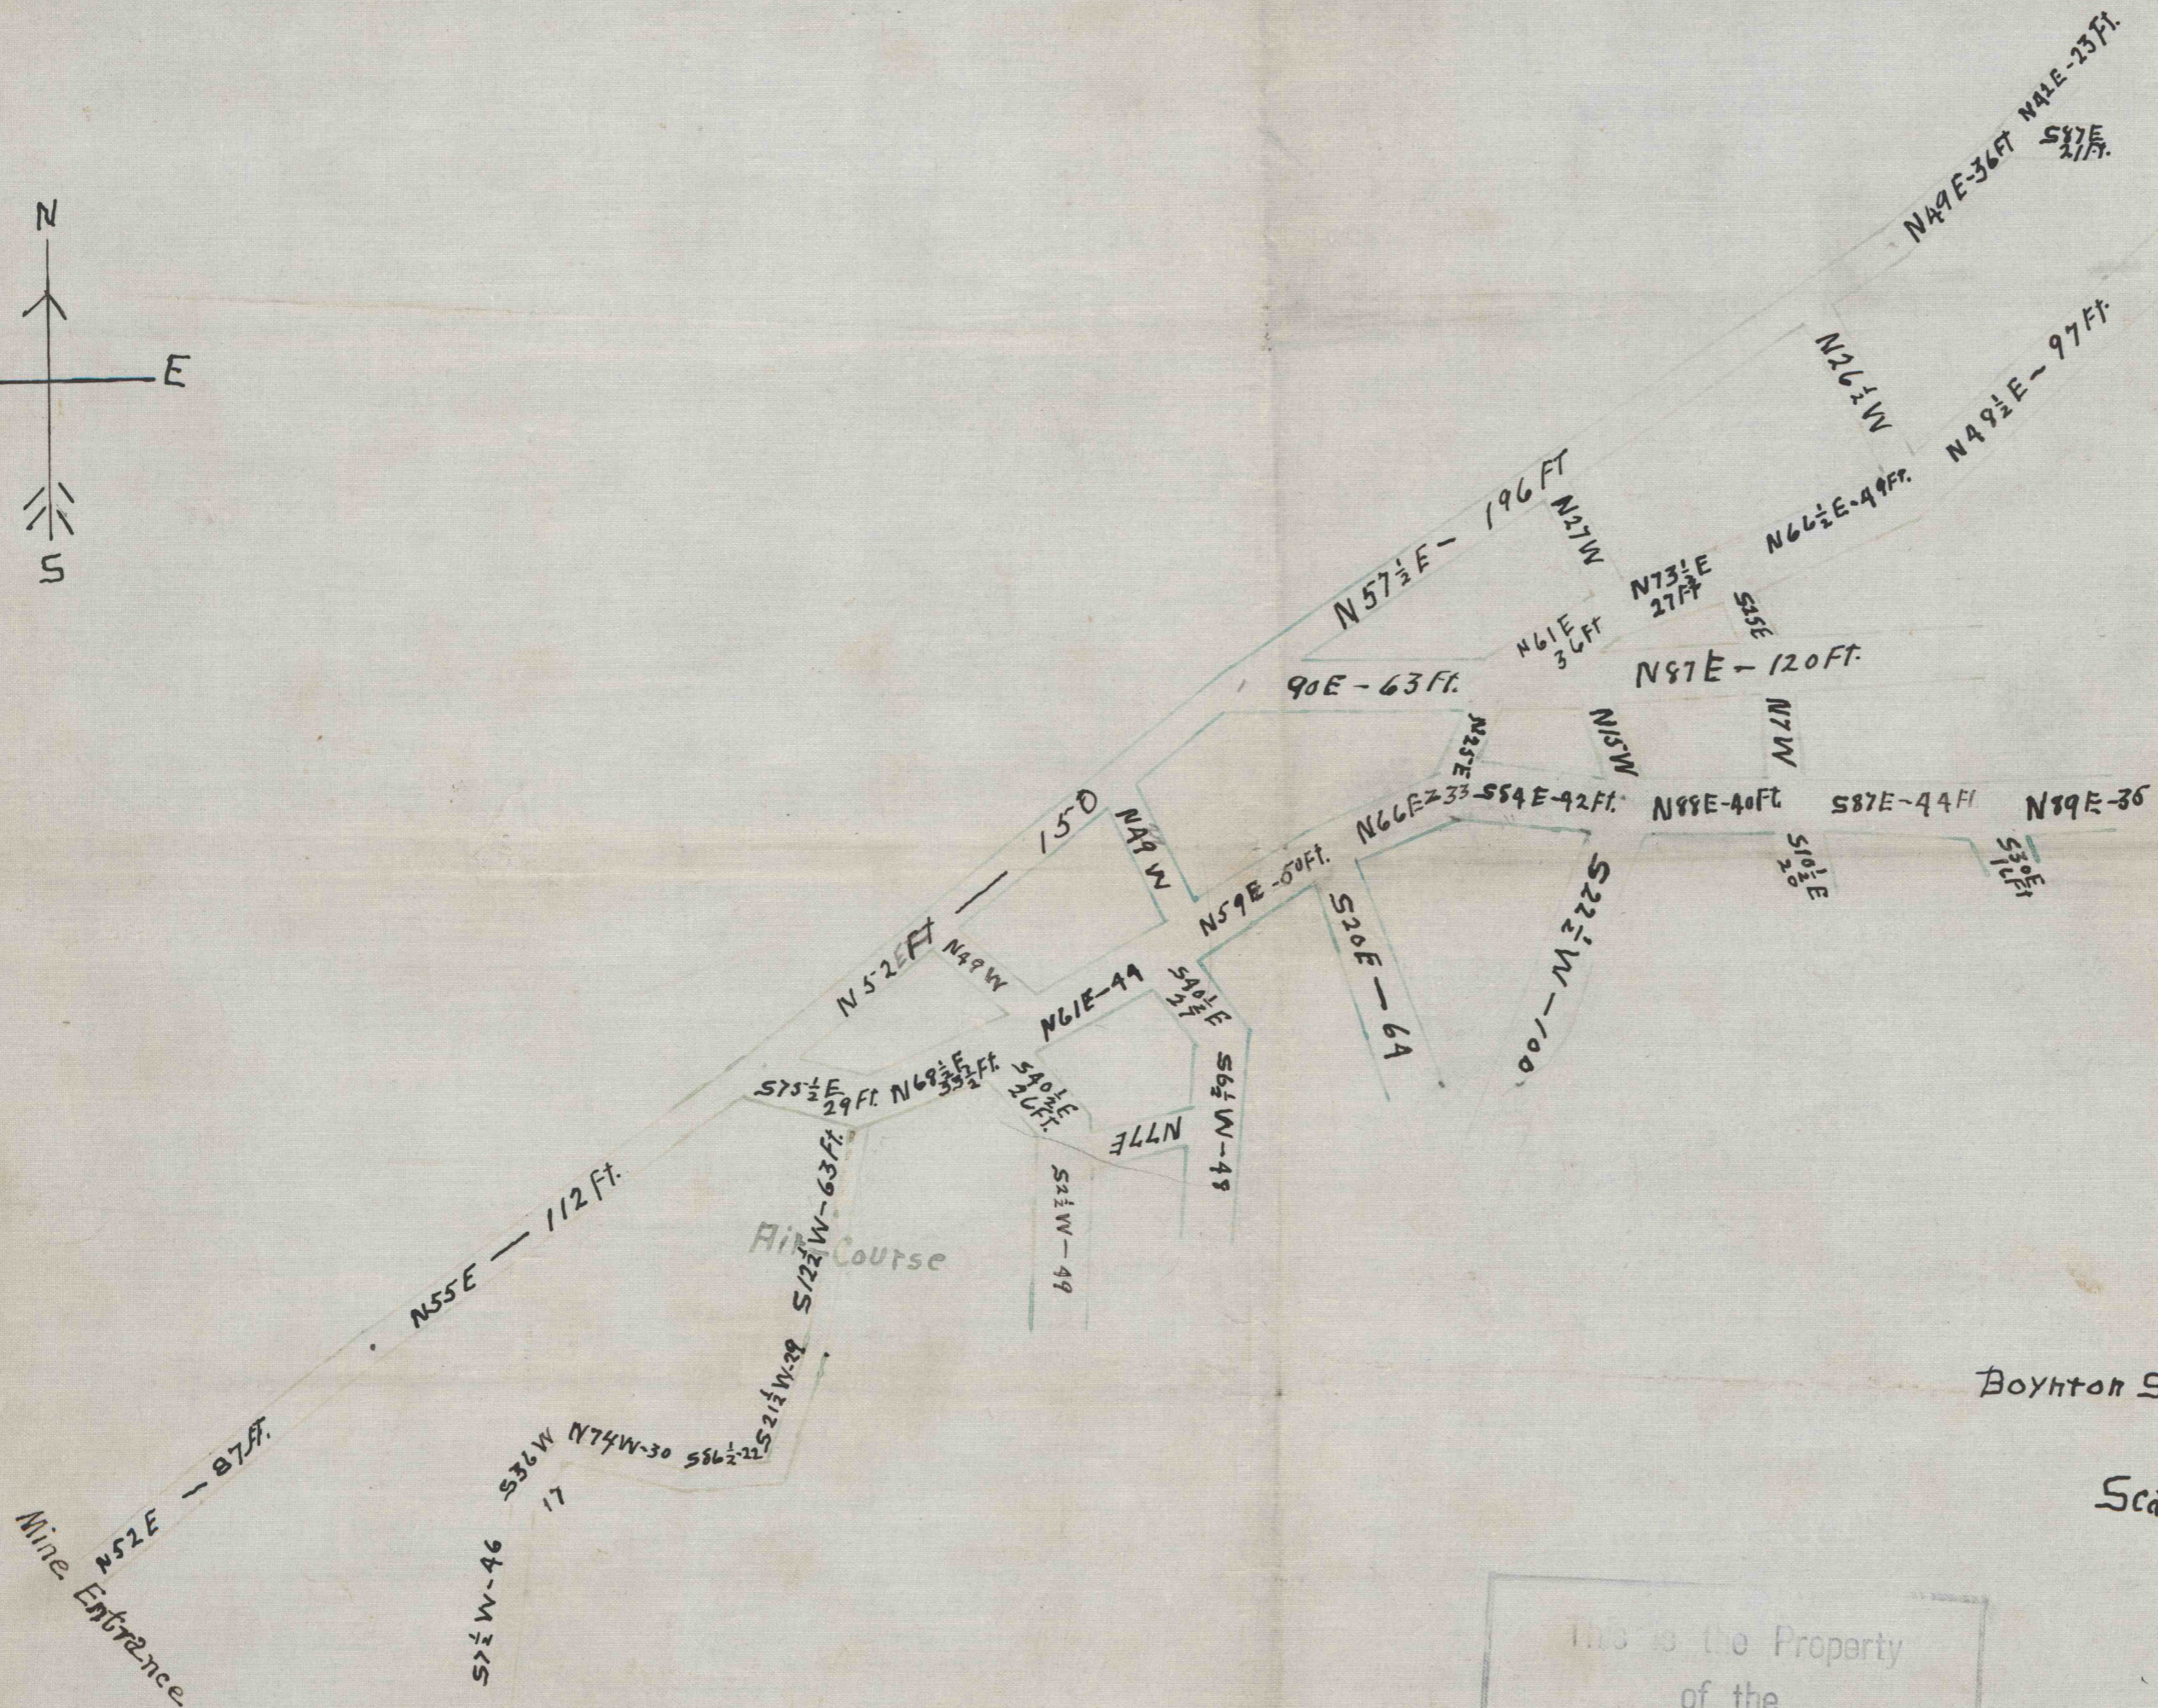


304001

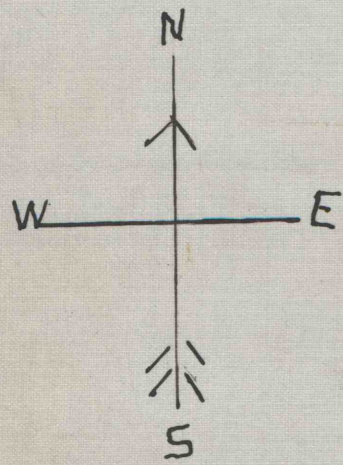

Boynton Smokeless Coal Co.

Scale - 40ft. = 1inch

July 5, 1920

This is the Property
of the
AUDITOR GENERAL'S
DEPARTMENT

#504
6-23-99
C.C.

B.M.