


4277

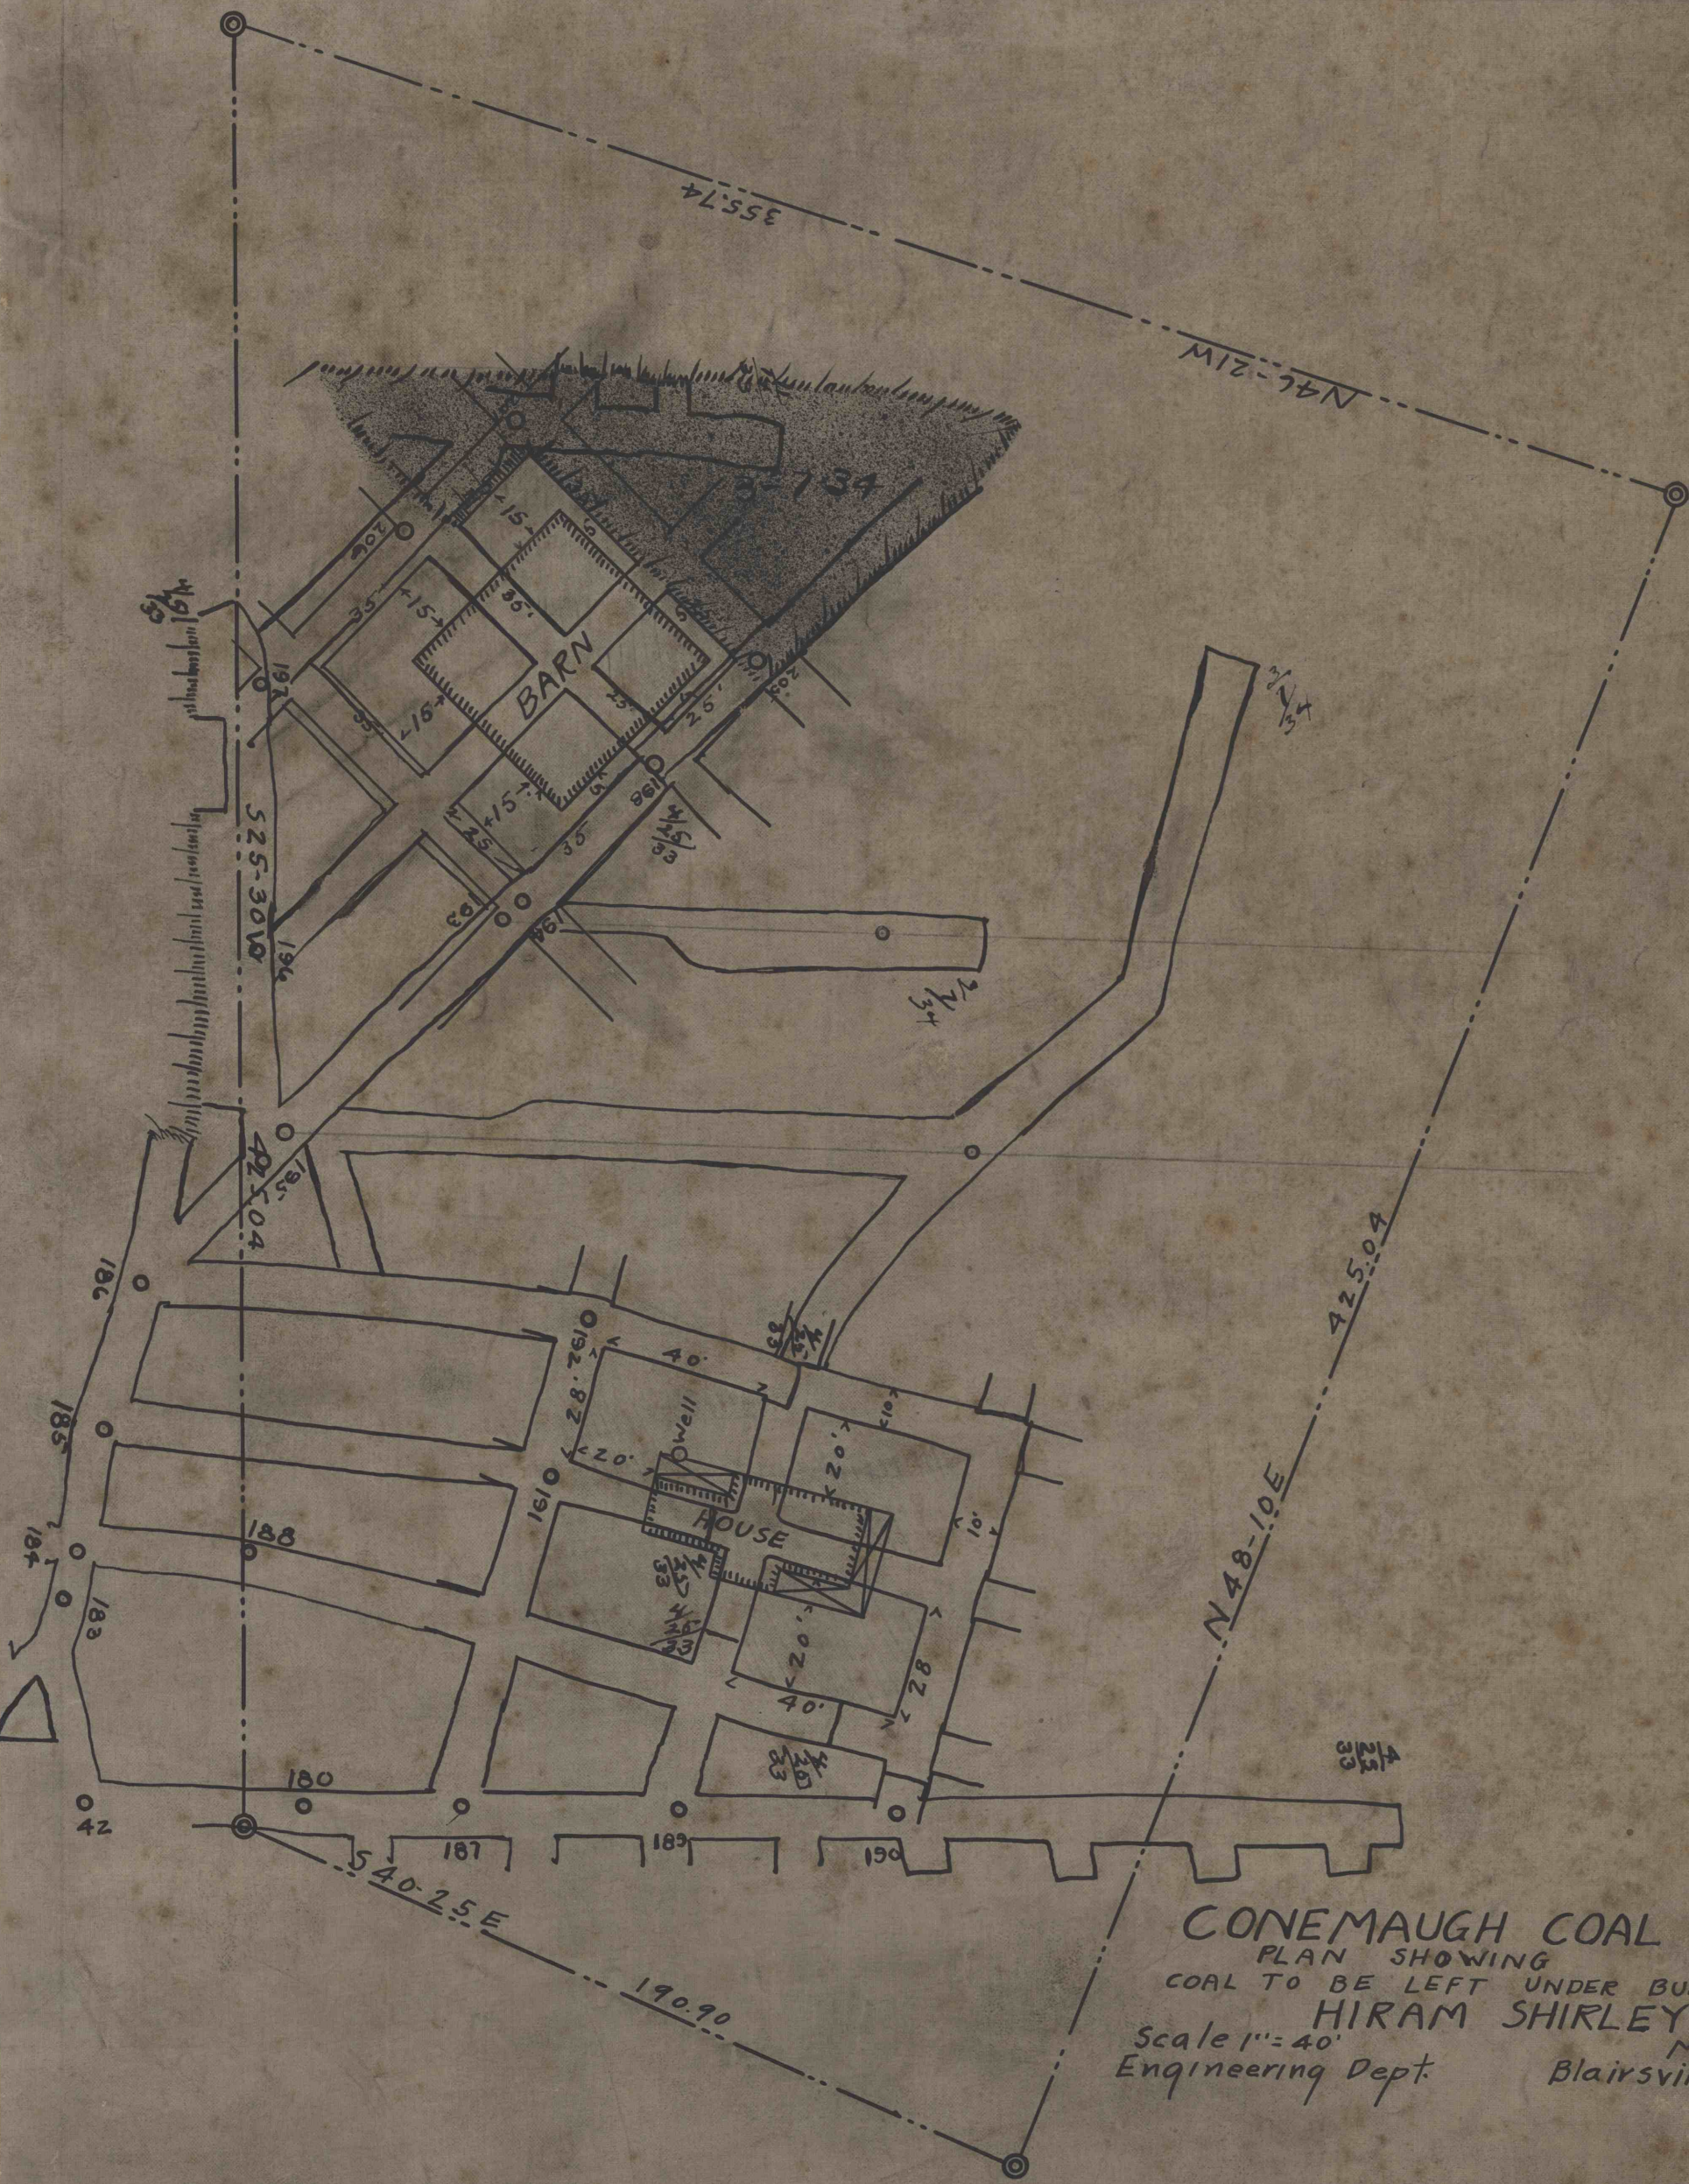

CONEMAUGH COAL CO.
PLAN SHOWING
COAL TO BE LEFT UNDER BUILDINGS OF
HIRAM SHIRLEY
Scale 1" = 40'
Engineering Dept. May 23, 1932
Blairsville Pa.