


Developed Area

VICTOR # 29

G-3+5 LOADER ROOMS

Scale - 1" = 40' Revised to 11-22-27

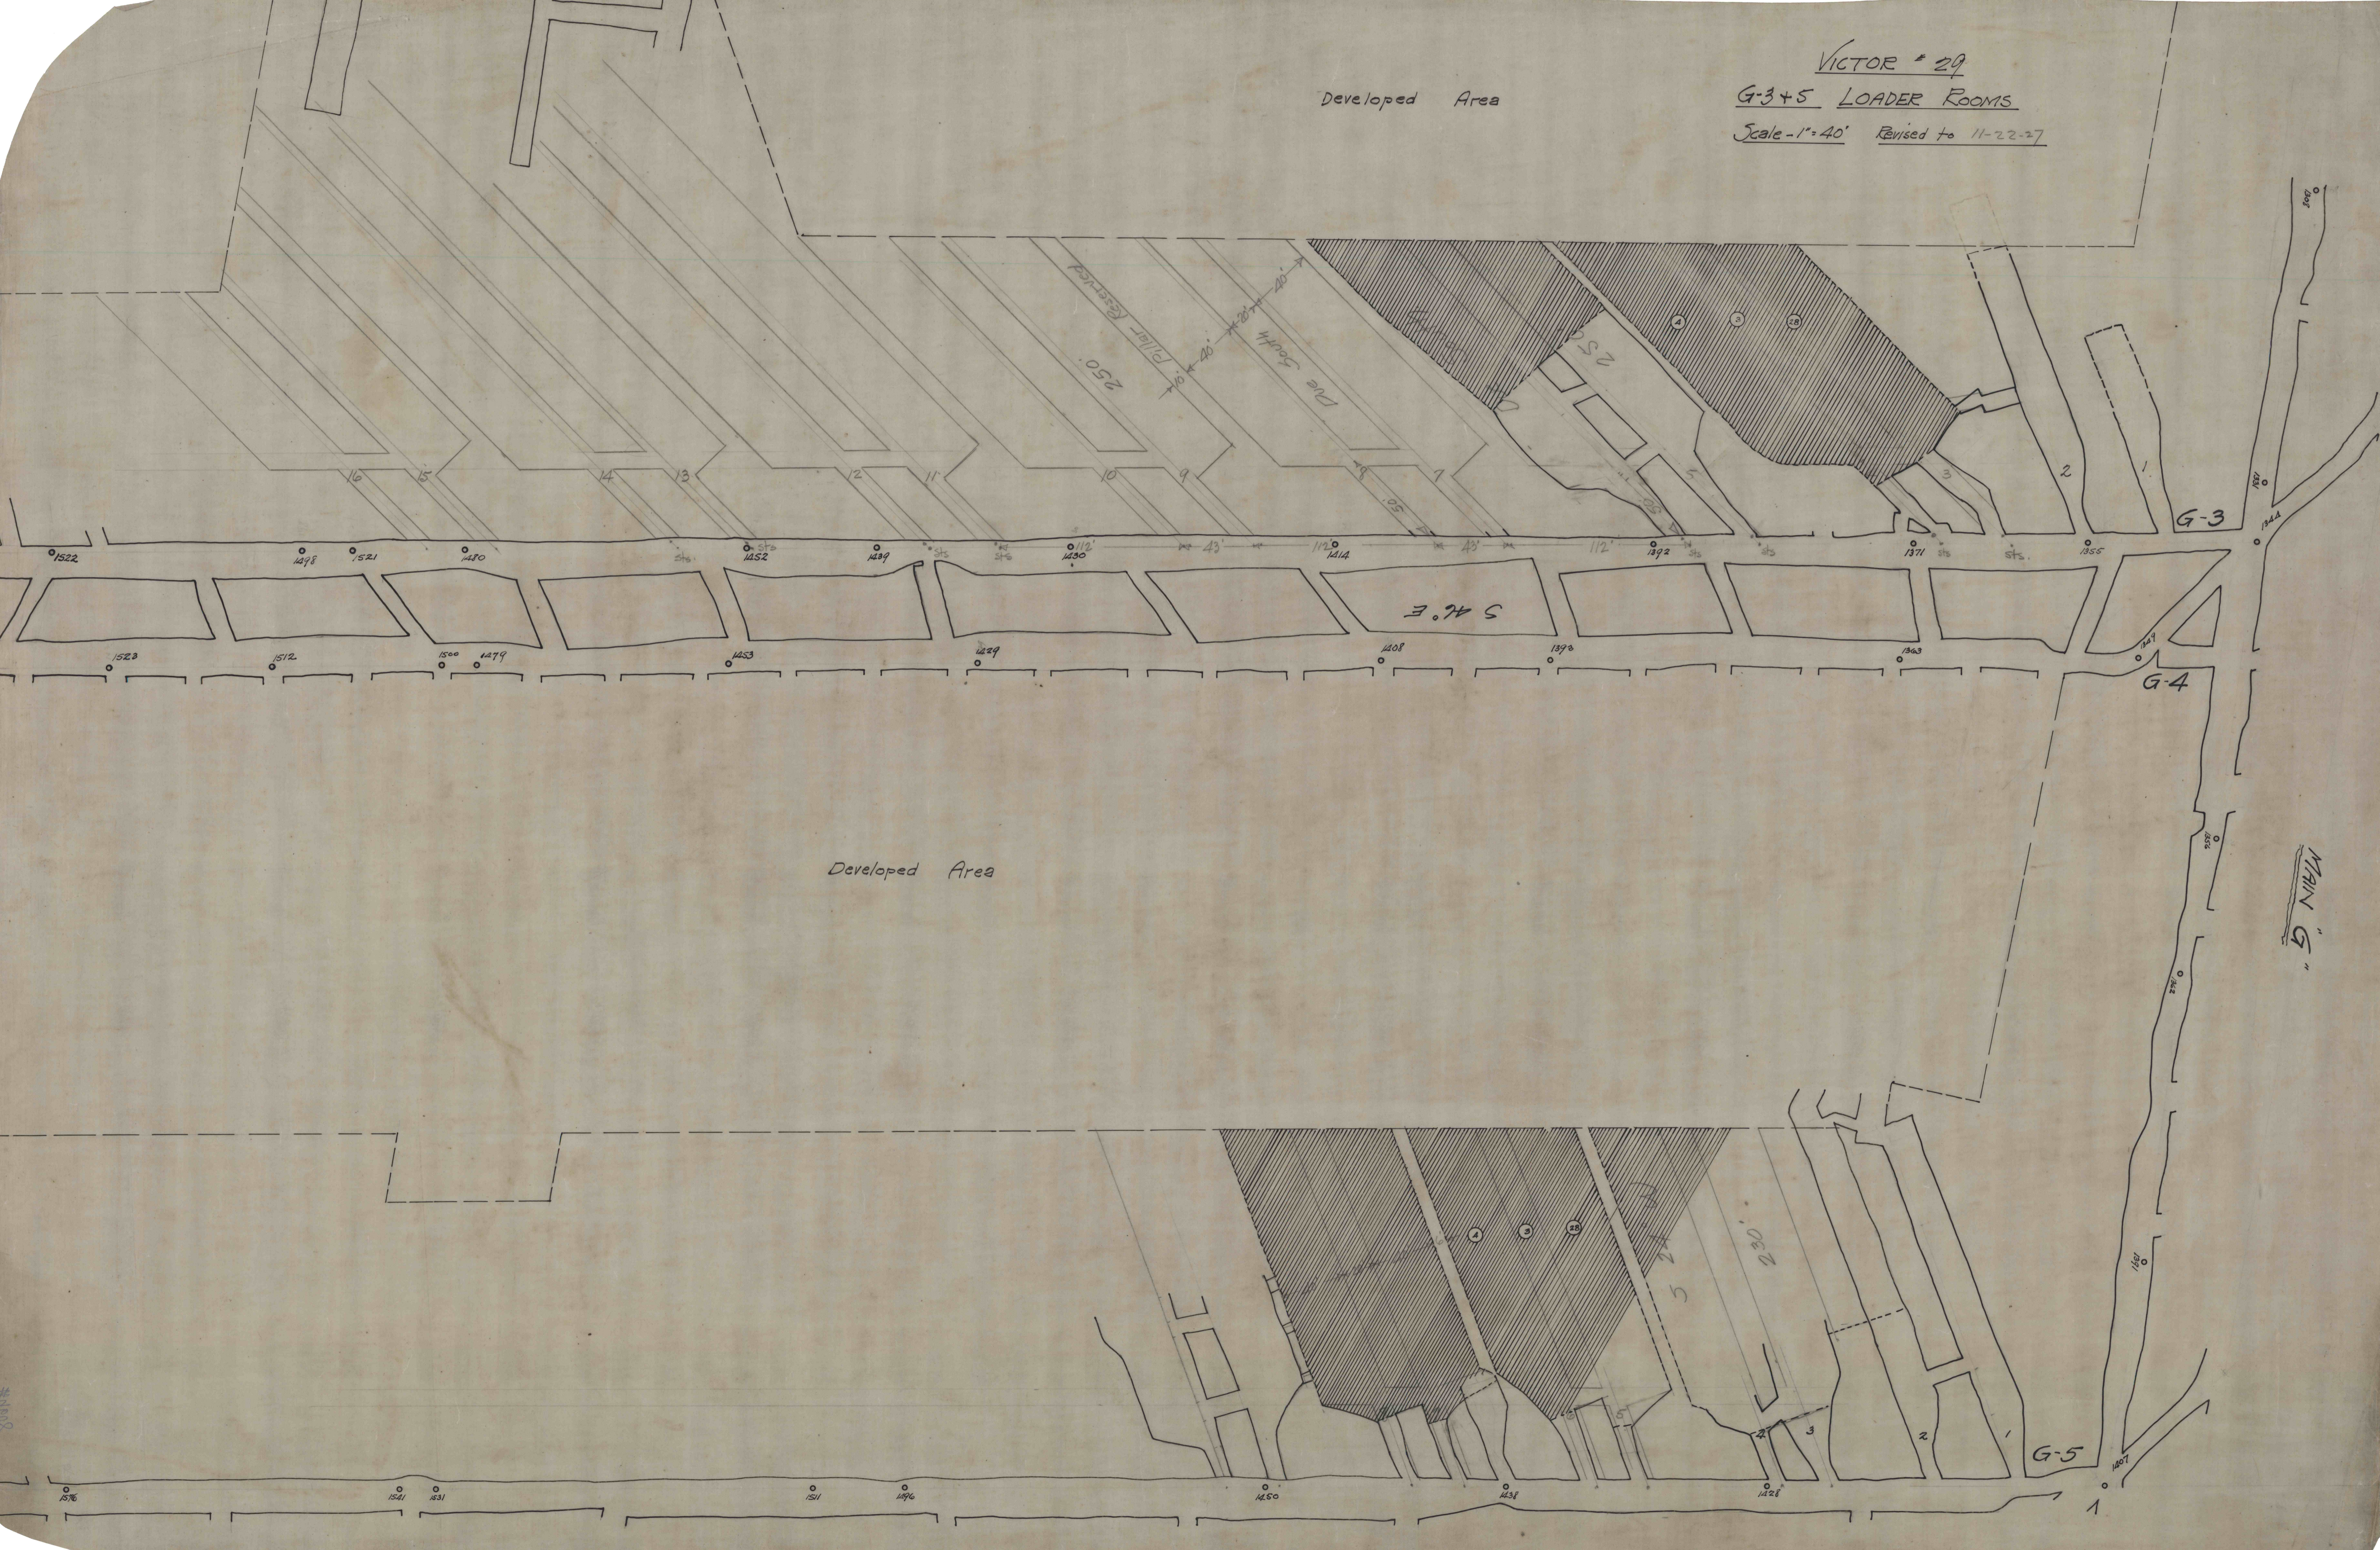

Developed Area

MAIN G

G-3

G-4

G-5

SAL. E

Die South
250'

254'

1522 1498 1521 1480 1452 1489 1490 1414 1412 1392 1371 1355 1523 1512 1500 1479 1453 1429 1408 1396 1363 1407 1428 1431 1450 1576 1541 1531 1511 1496

2014#