


MC-7

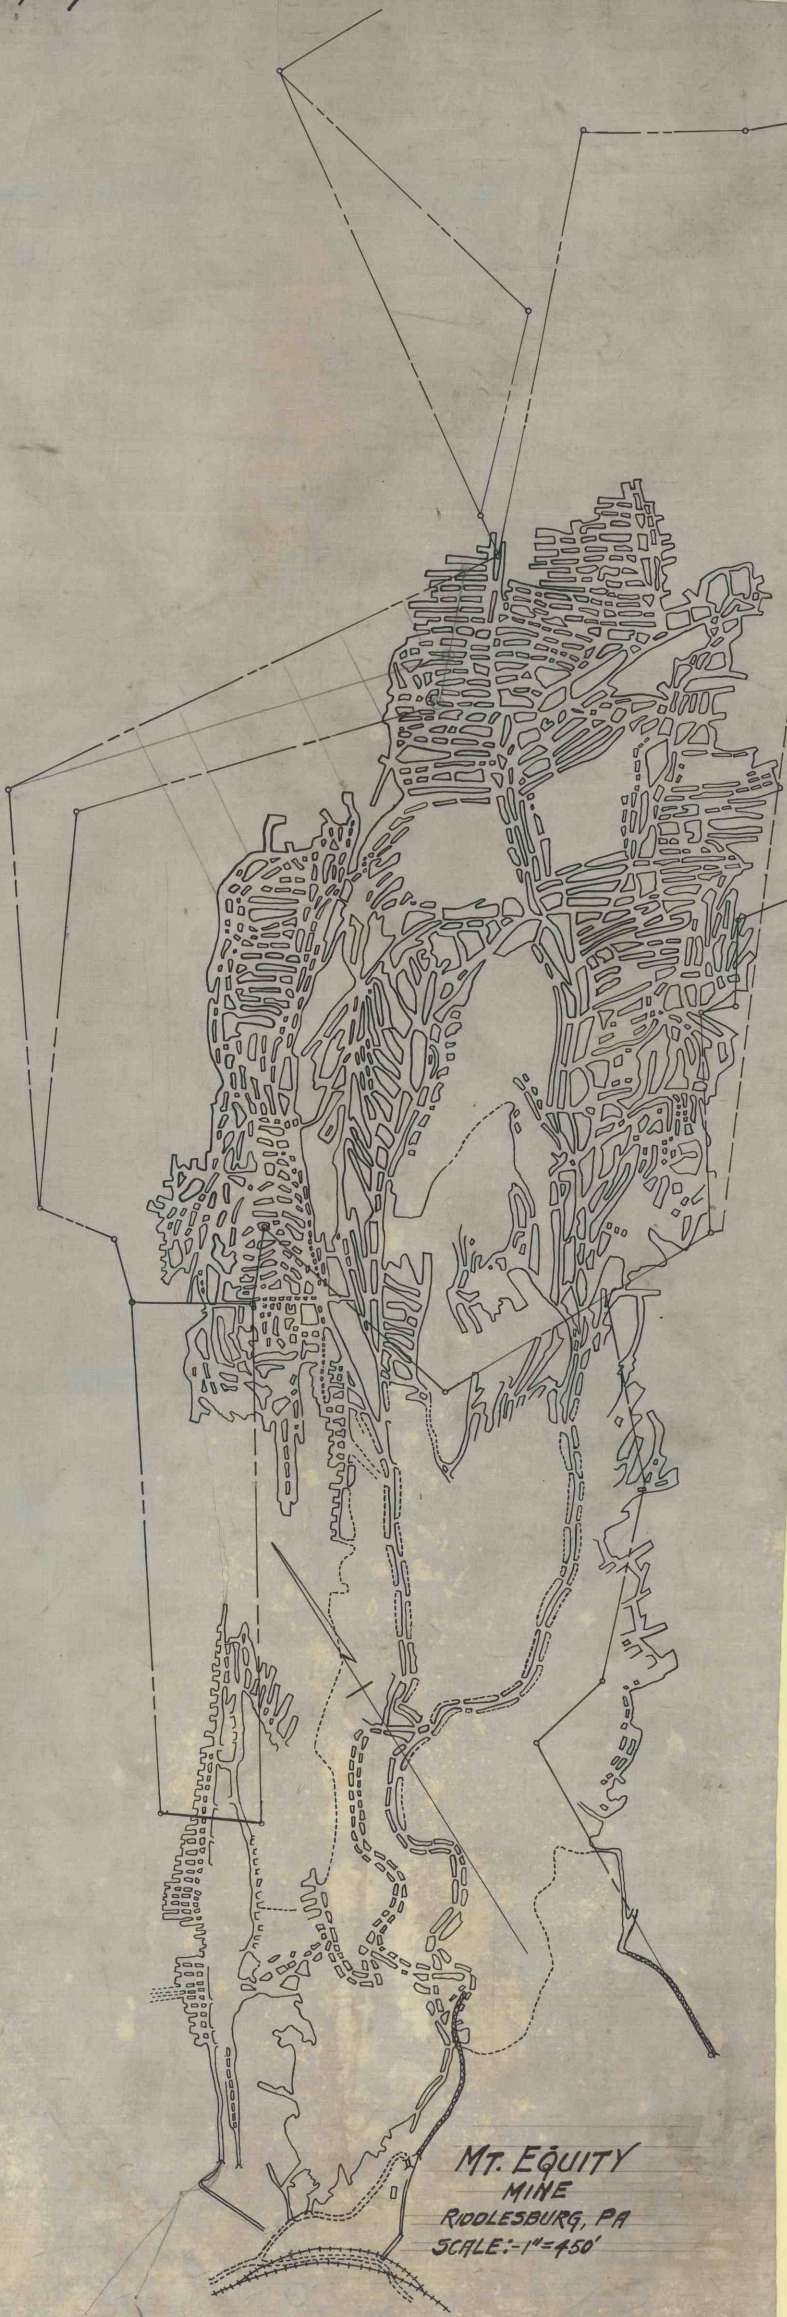

MT. EQUITY
MINE
RIDDLESBURG, PA
SCALE: 1"=450'

FILE MC-7