


LEGEND	
⊙	CAPPED SHAFT TO BE FILLED
⊖	OPEN RELIEF BOREHOLE
⊕	FILLED/SEALED SHAFT
⊙	PLUGGED BOREHOLE
⊖	OPEN TO BE PLUGGED BOREHOLE
⊕	PUMP BOREHOLE IN SERVICE

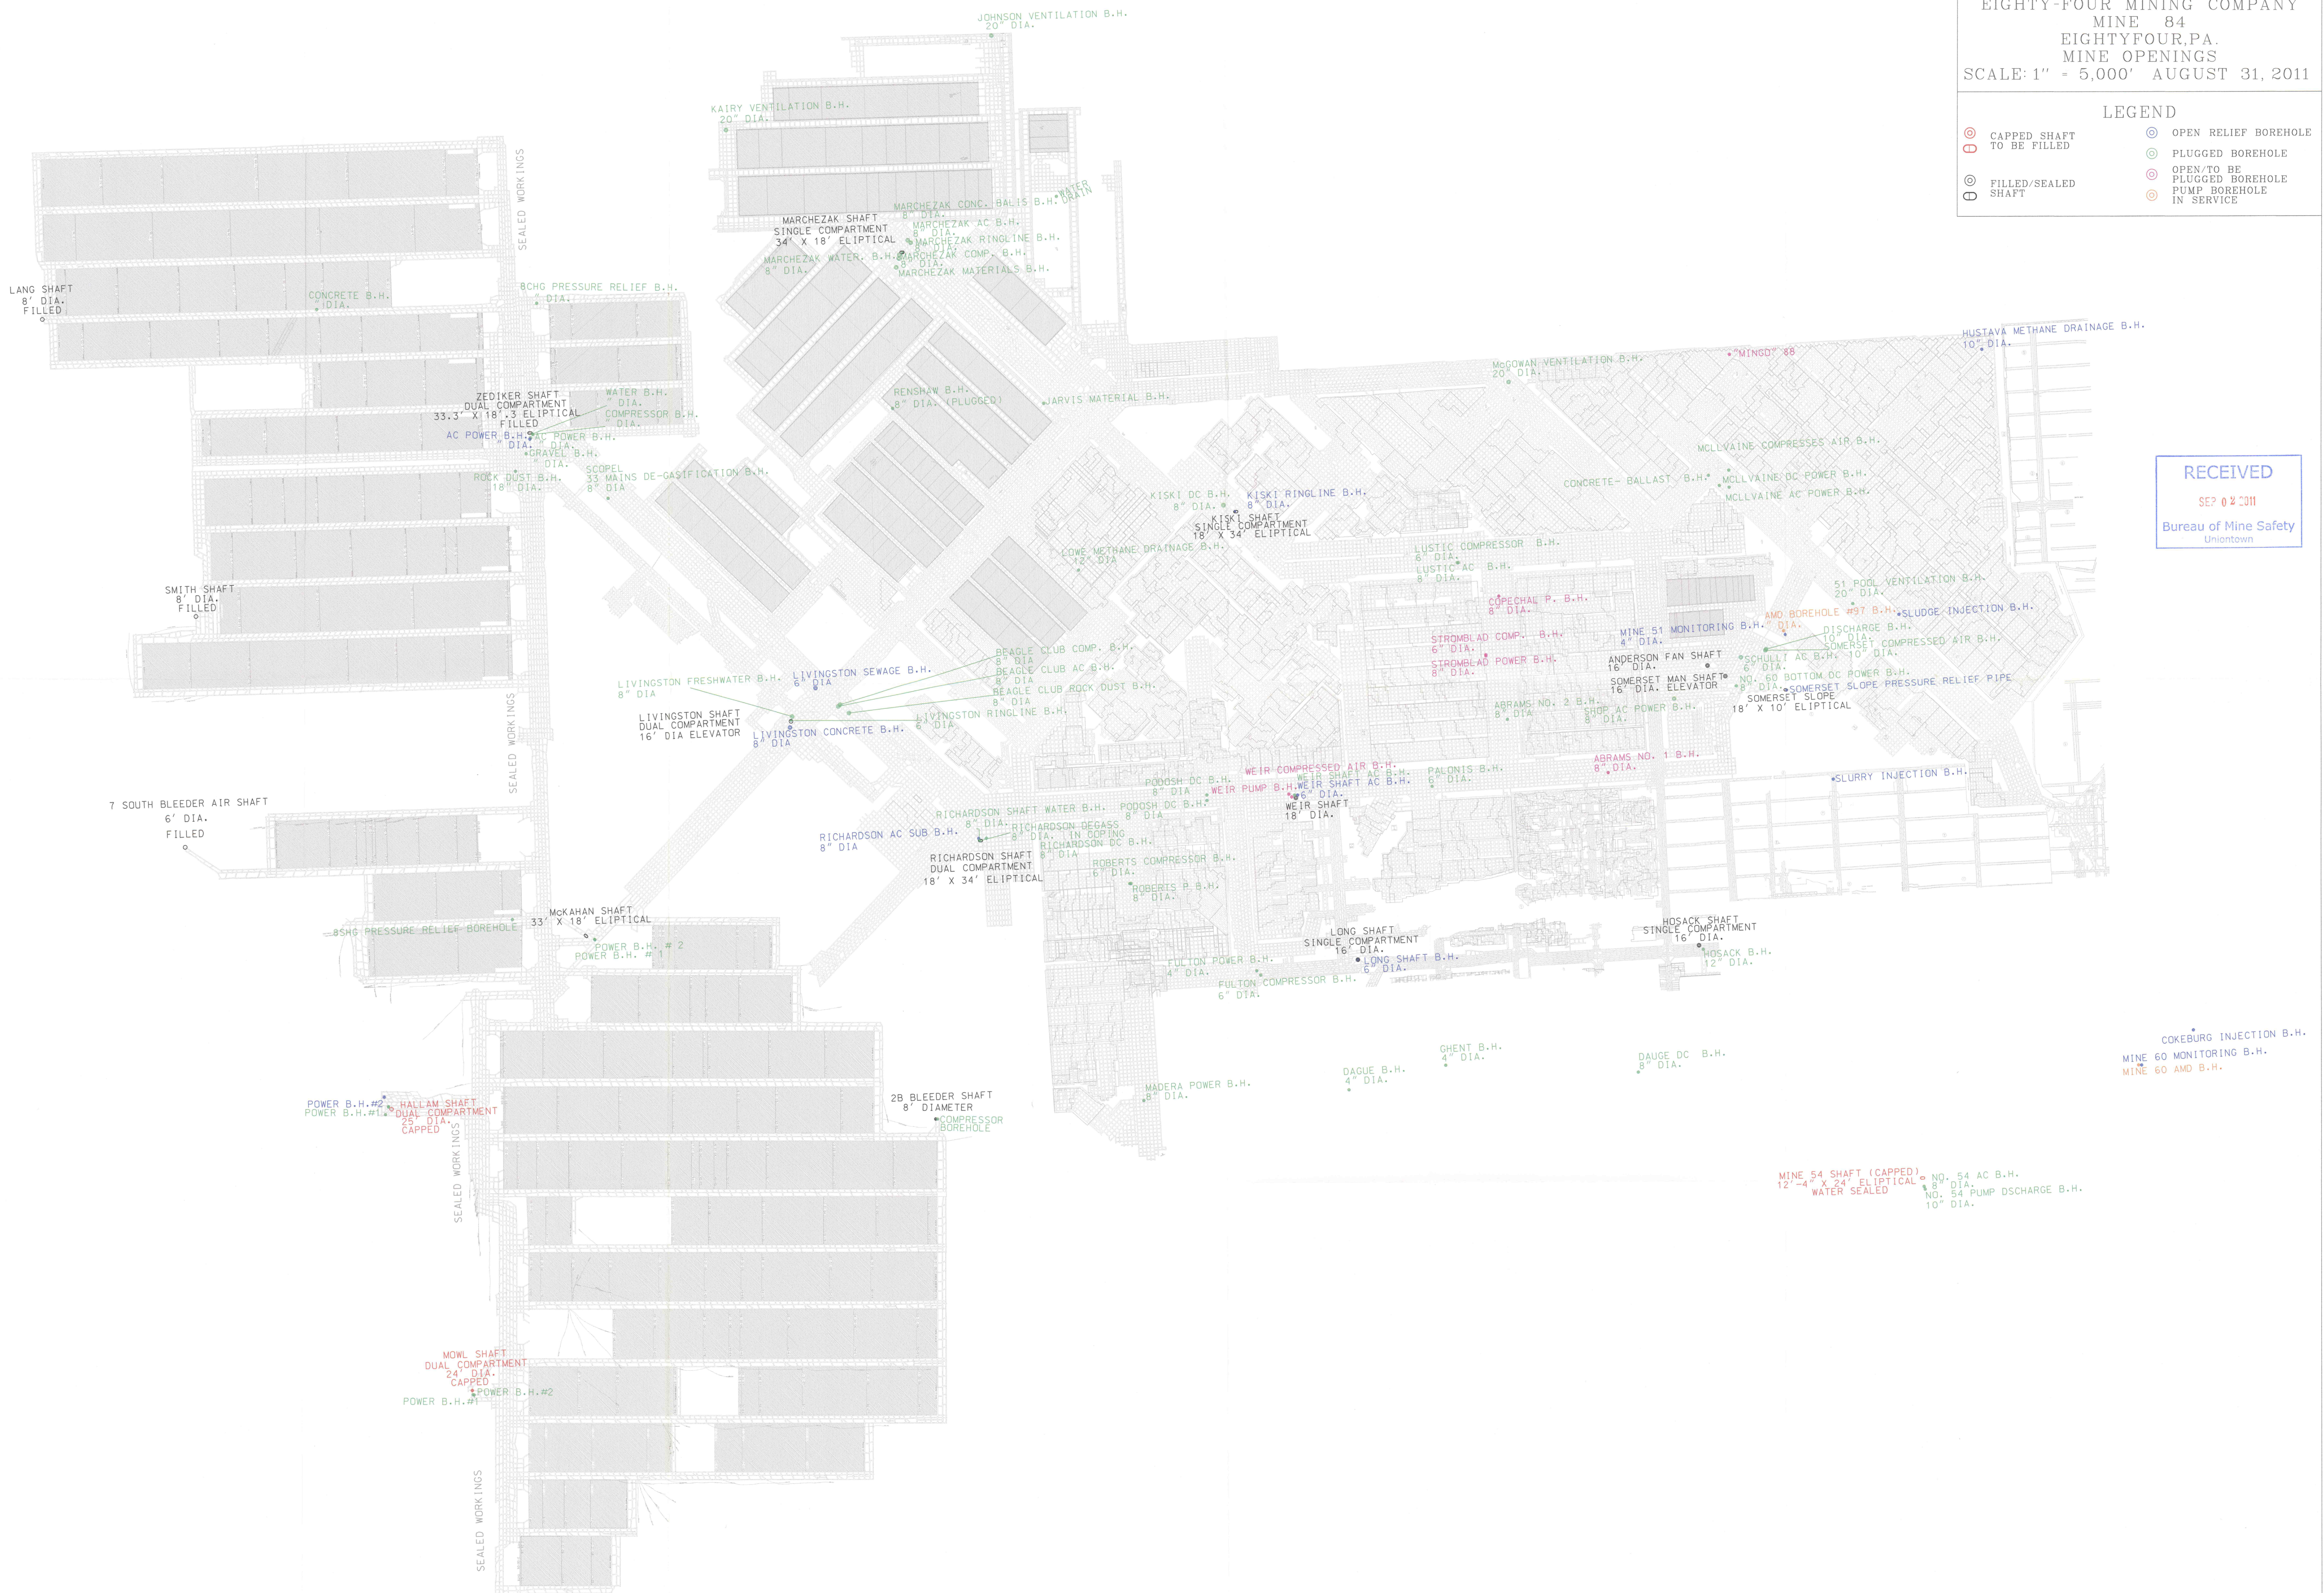

RECEIVED
 SEP 02 2011
 Bureau of Mine Safety
 Uniontown