


LEGEND

⊙ CAPPED SHAFT TO BE FILLED	⊙ OPEN RELIEF BOREHOLE
⊙ FILLED/SEALED SHAFT	⊙ PLUGGED BOREHOLE
	⊙ OPEN/TO BE PLUGGED BOREHOLE
	⊙ PUMP BOREHOLE IN SERVICE

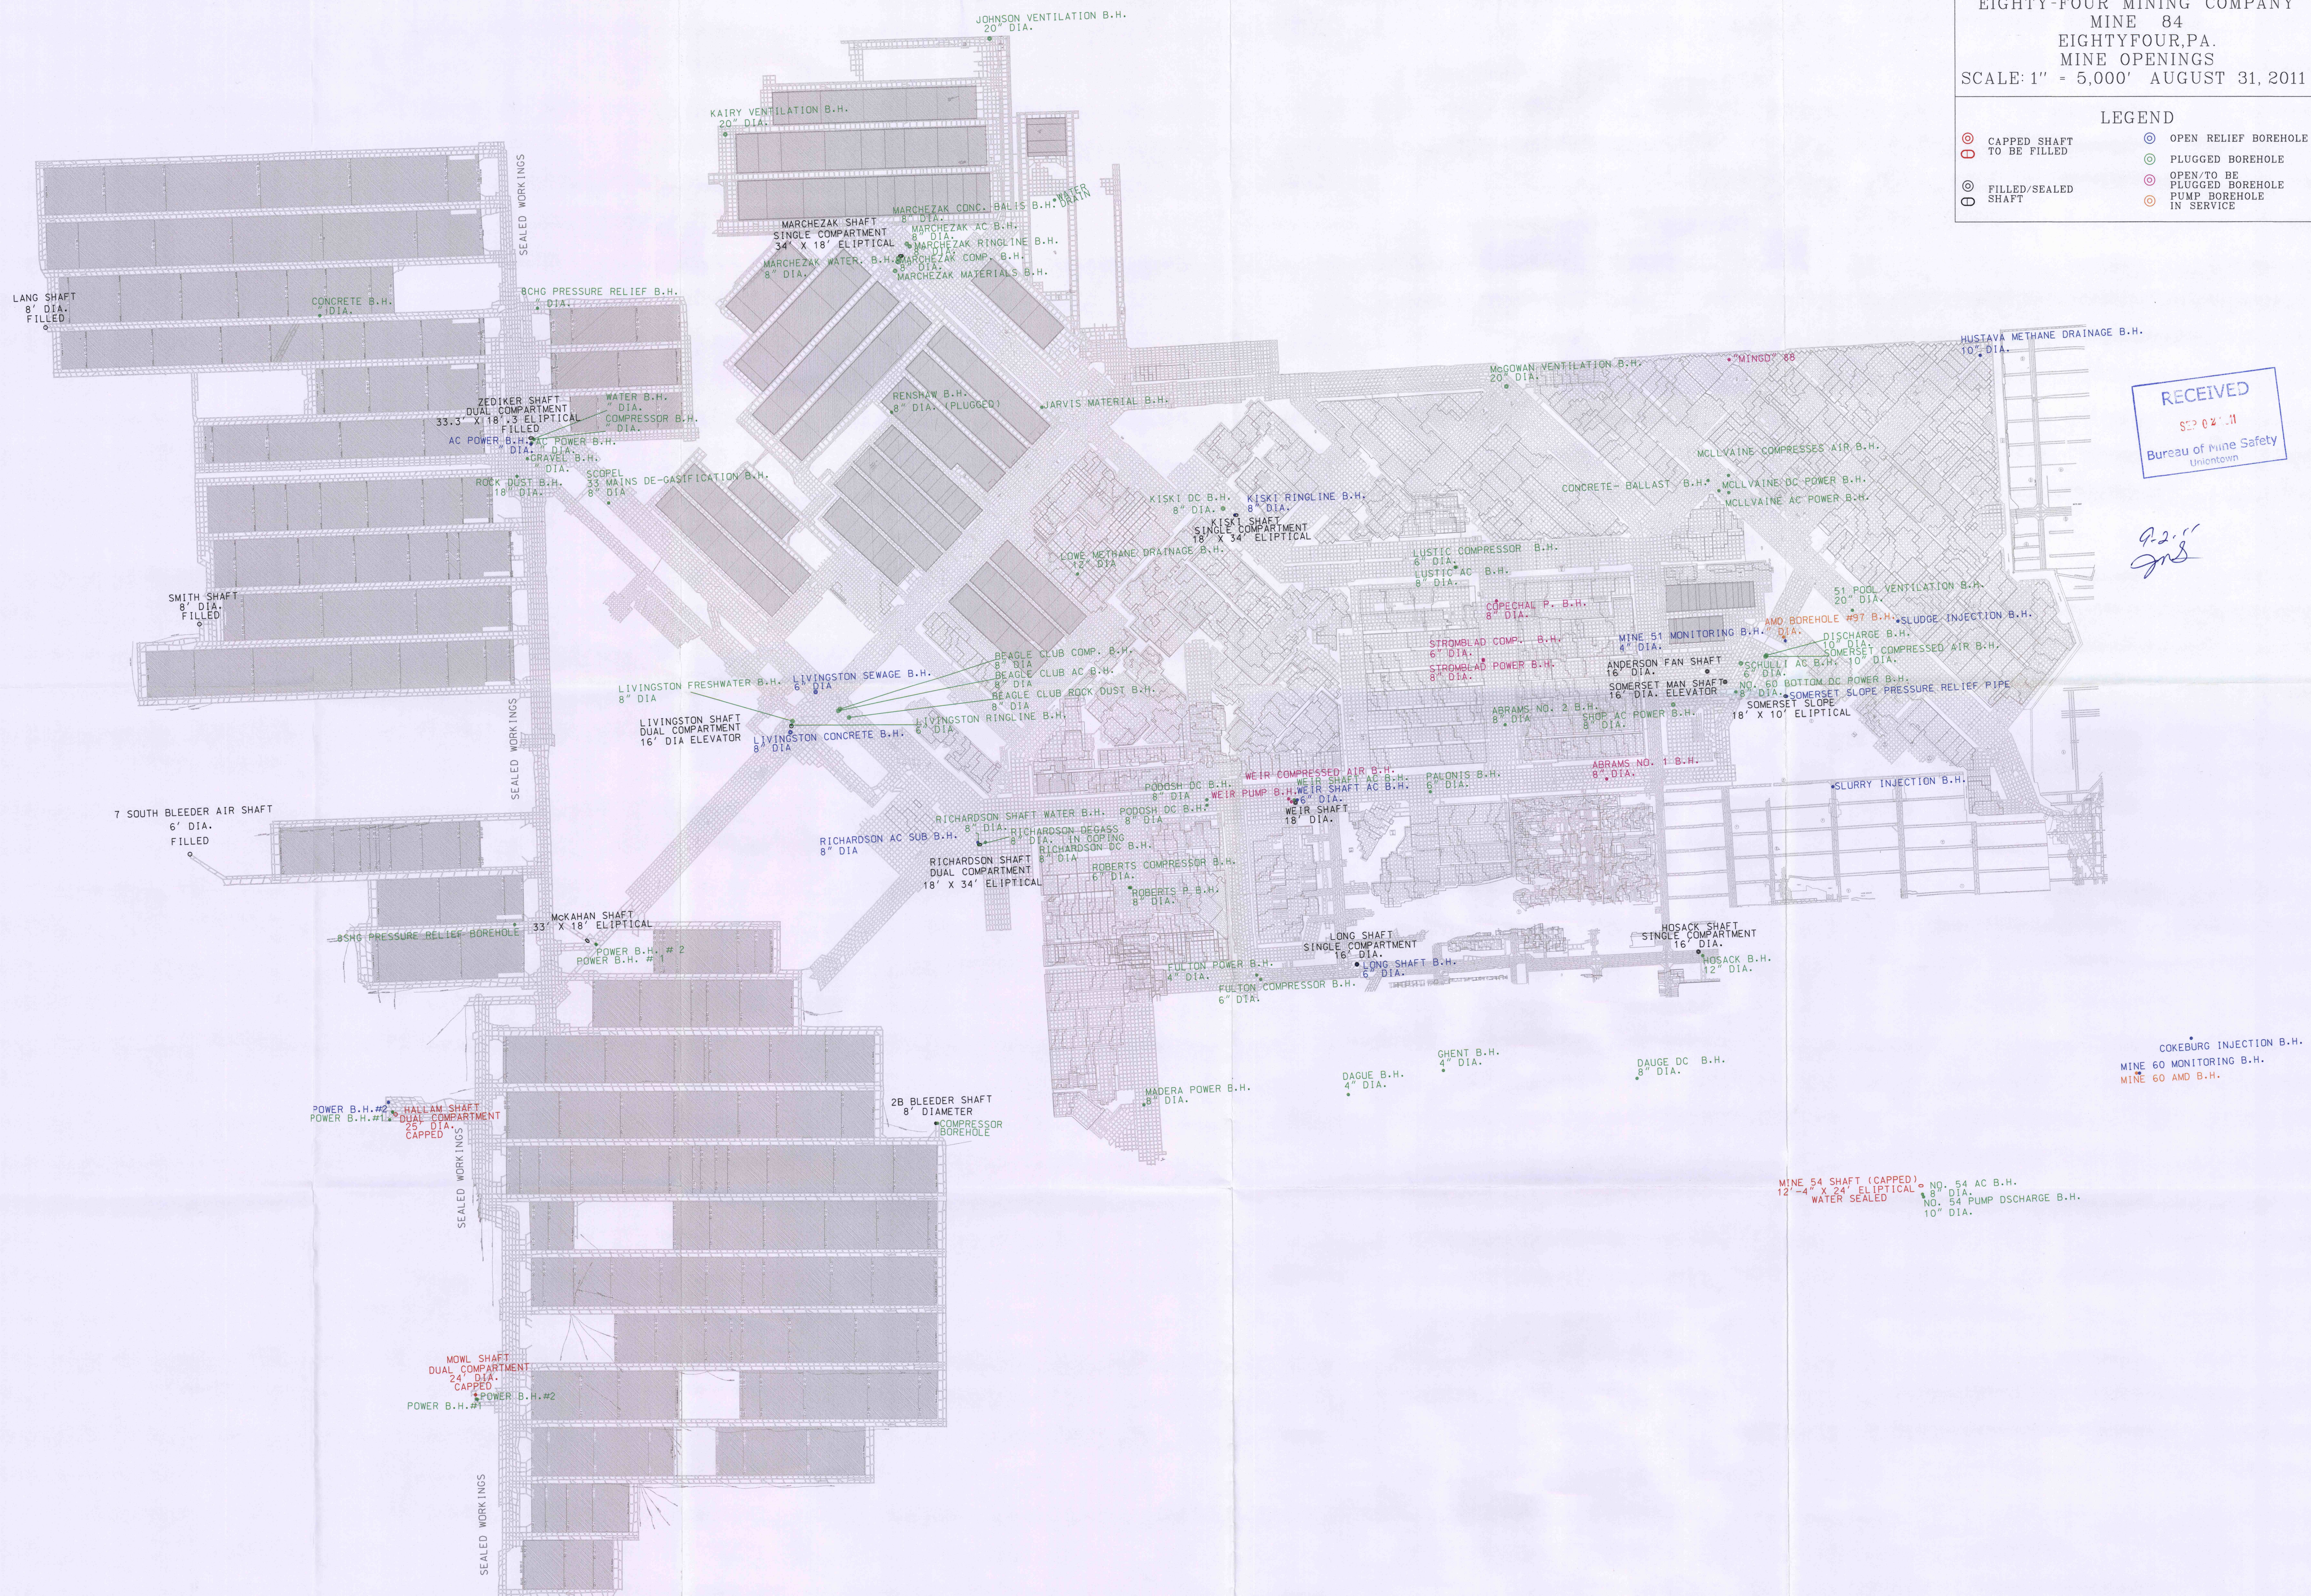

RECEIVED
 SEP 02 11
 Bureau of Mine Safety
 Uniontown

Handwritten signature

MINE 54 SHAFT (CAPPED)
 12'-4" X 24" ELIPTICAL
 WATER SEALED

NO. 54 AC B.H.
 8" DIA.
 NO. 54 PUMP DSCARGE B.H.
 10" DIA.

COKEBURG INJECTION B.H.
 MINE 60 MONITORING B.H.
 MINE 60 AMD B.H.