


OCEAN MINE

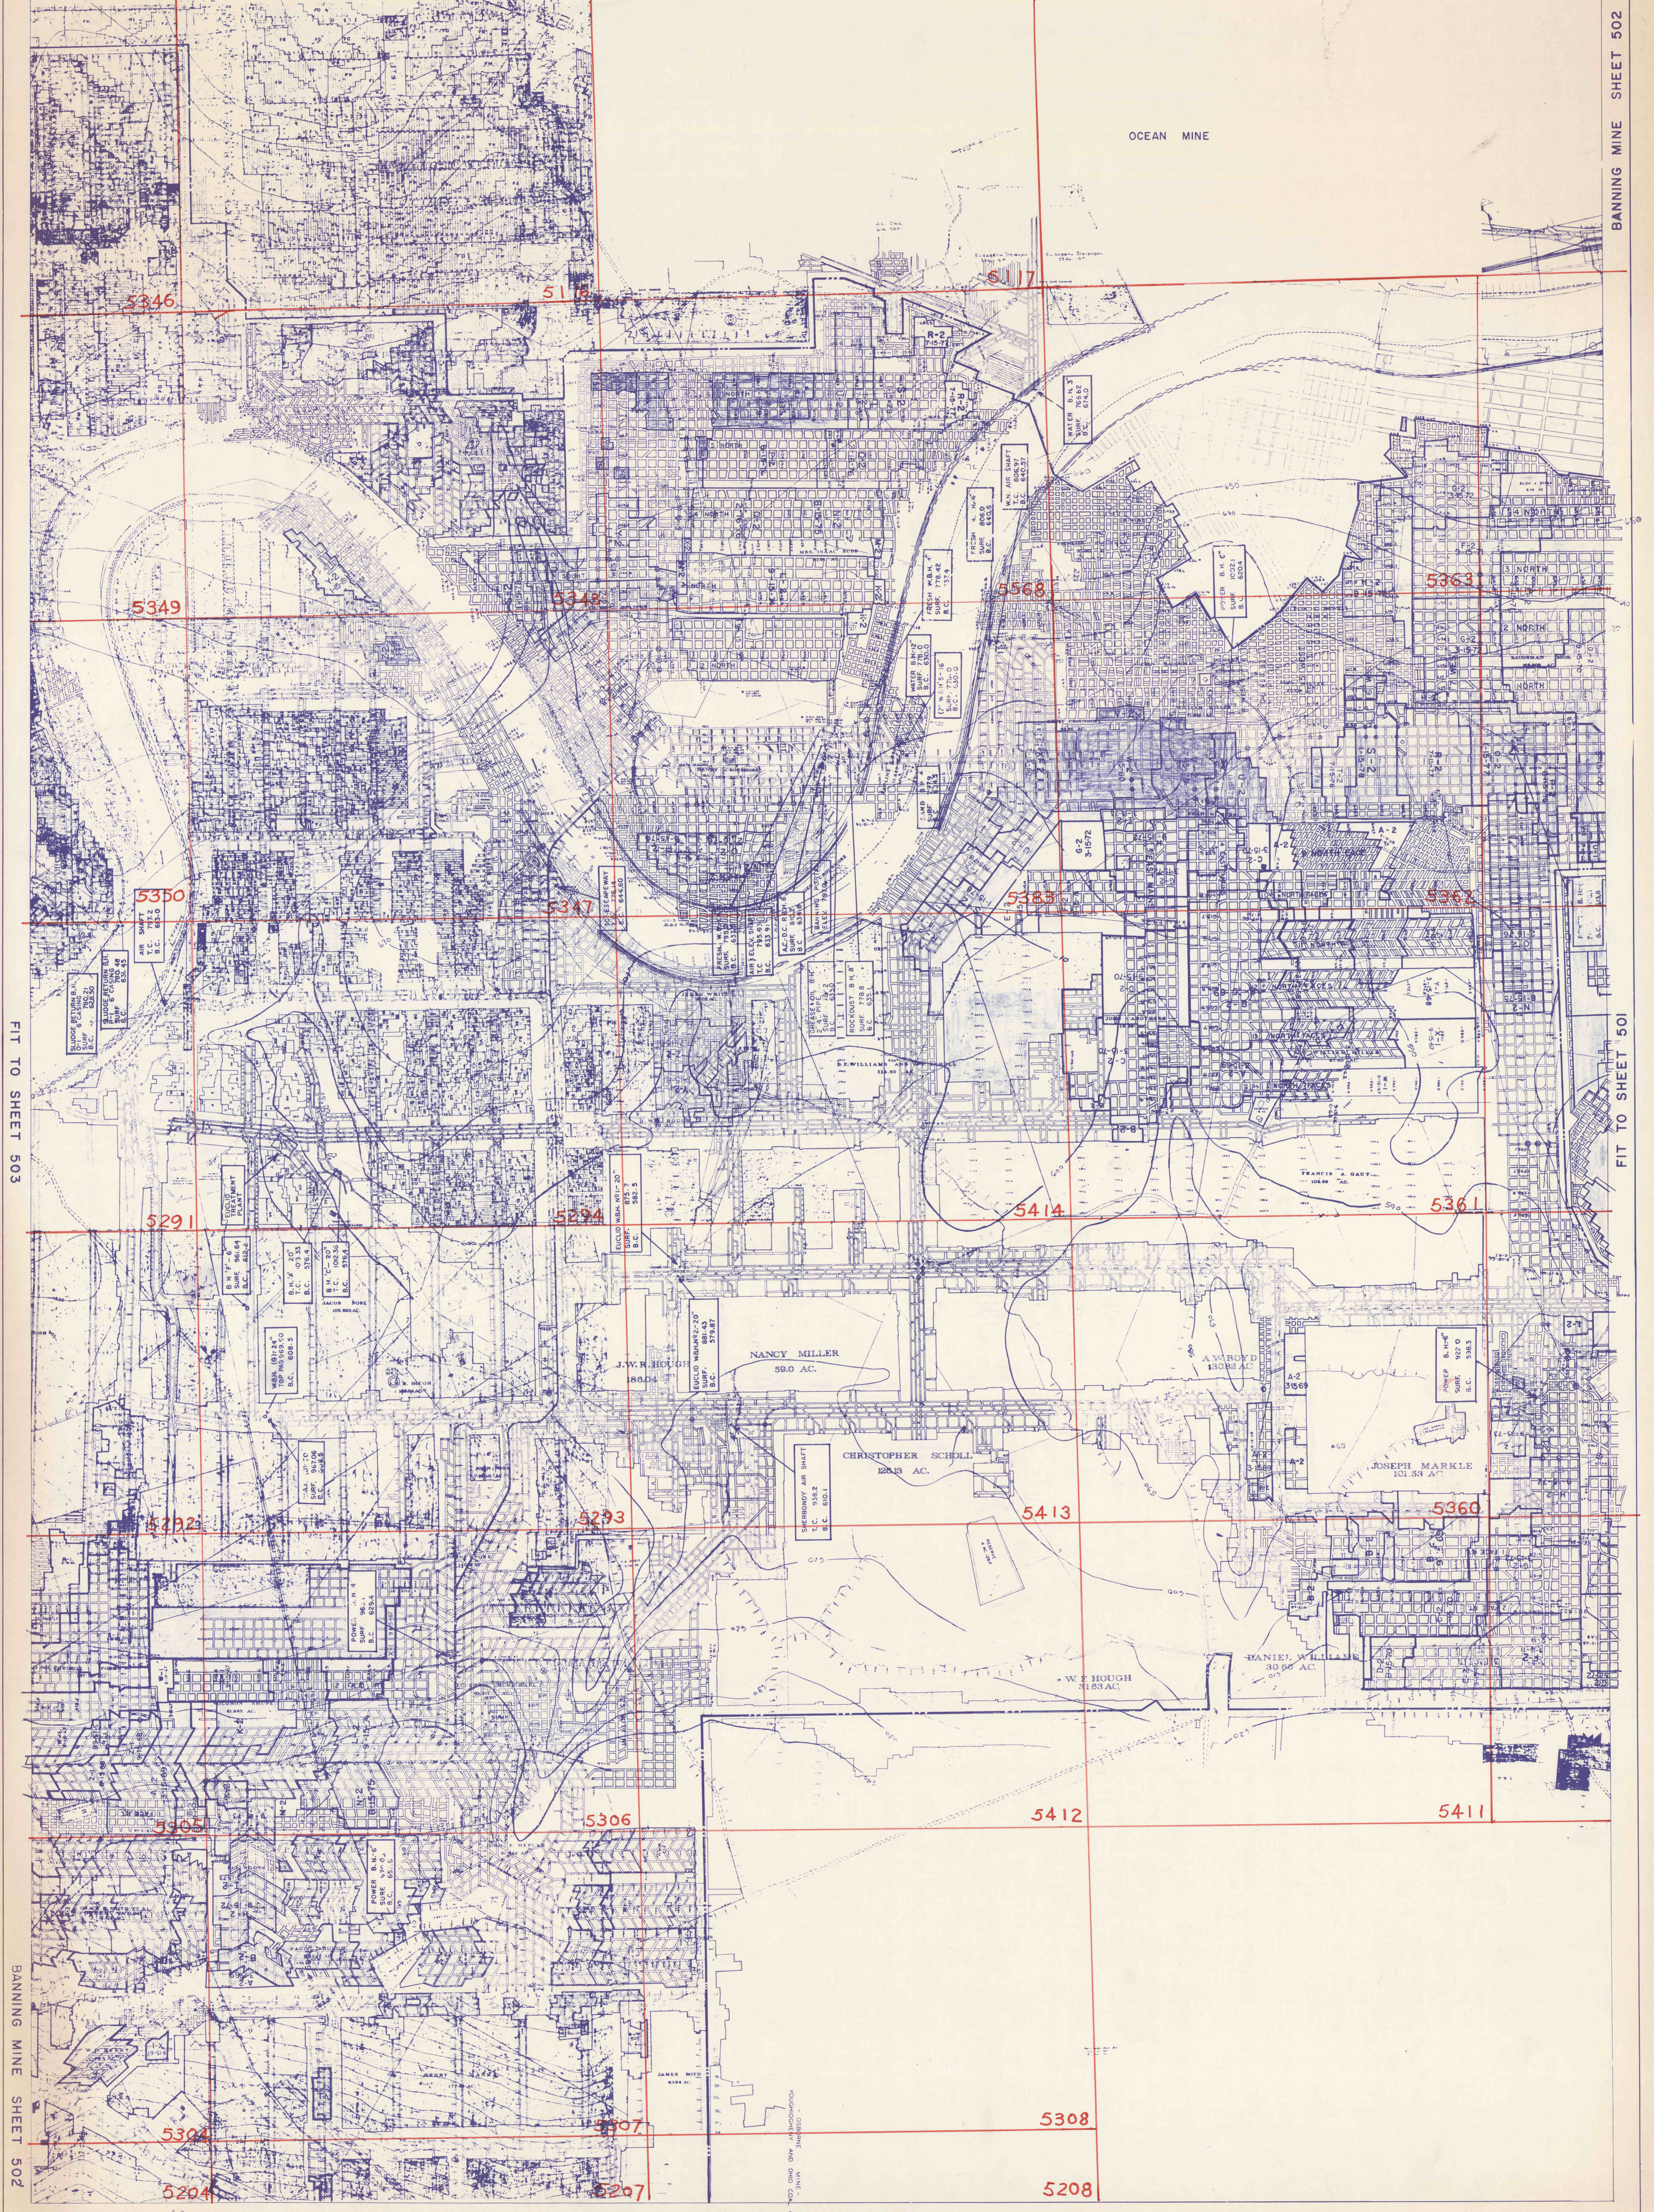

FIT TO SHEET 503

FIT TO SHEET 501

FIT TO A

CONSTRUCTION AND MINE CO.