


#419
6-18-99
C.C.

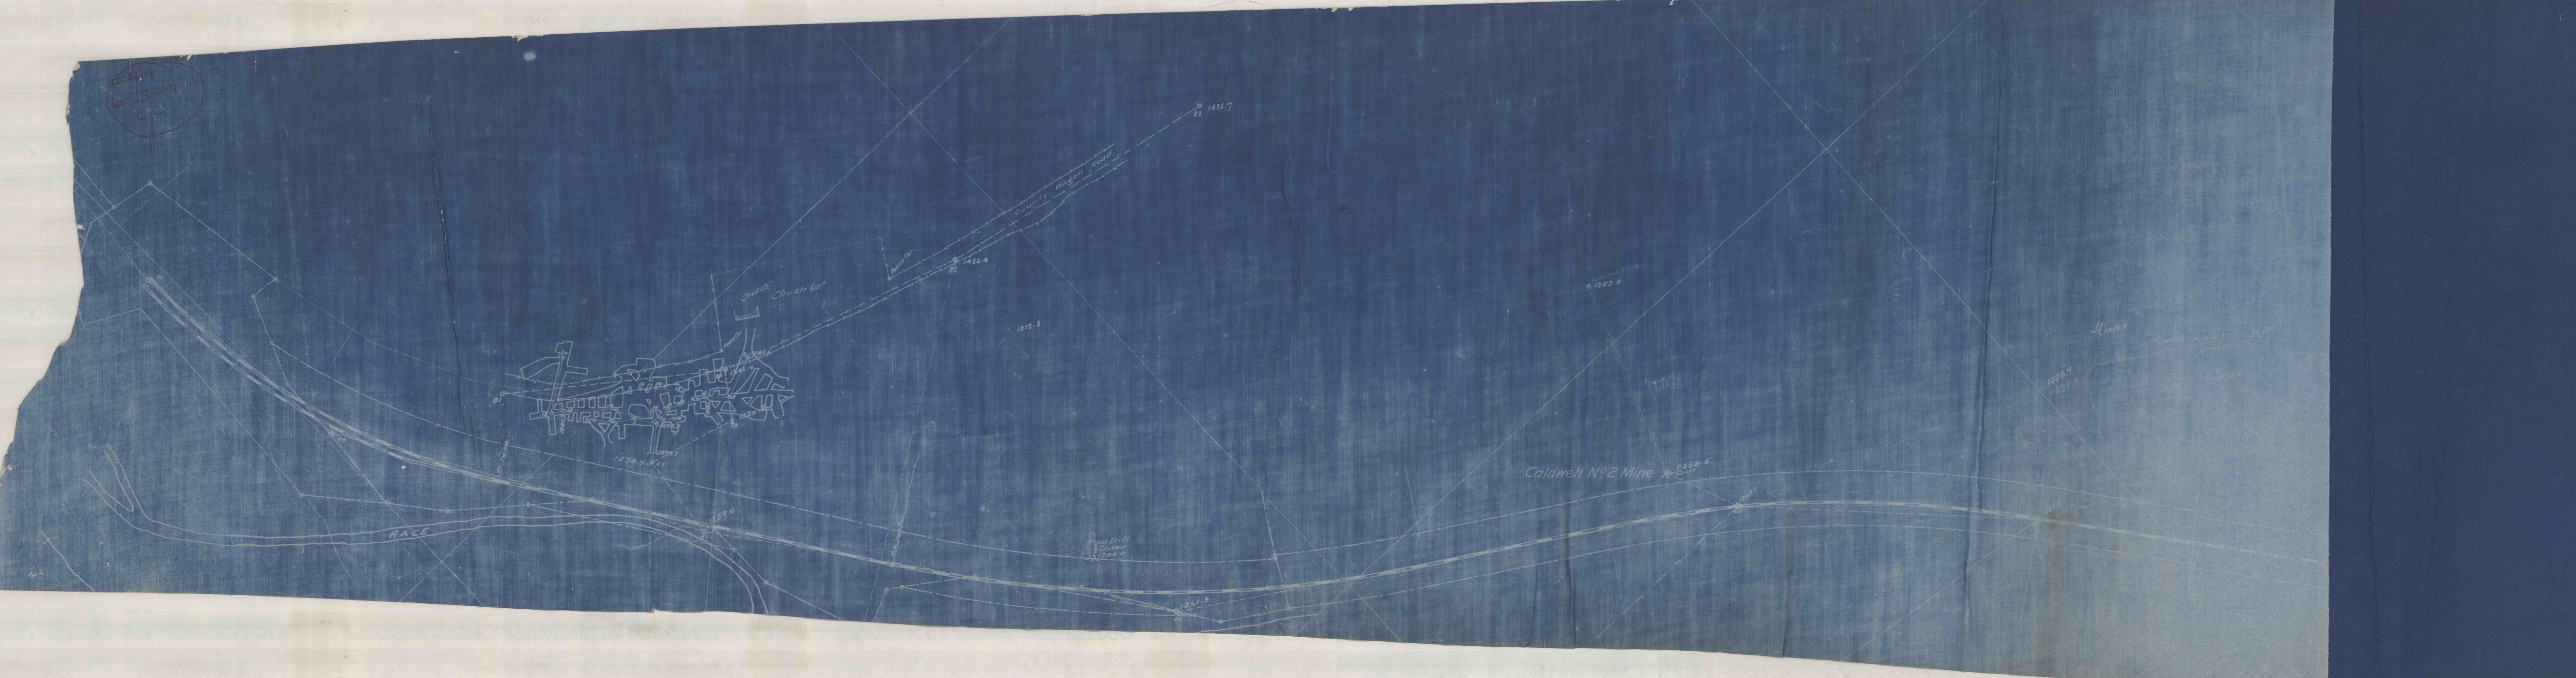

RACE

Church Lot

1312.3

Caldwell No 2 Mine

High Drift
Elevation
1204.0