


MAP OF LANDS
OF THE
CLEARFIELD BITUMINOUS COAL CORPN.
CLYMER FIELD
INDIANA COUNTY, PA.
SCALES: 1" = 500'
REVISED TO - NOV. 2, 1956
CHIEF ENGINEER
Paul Will

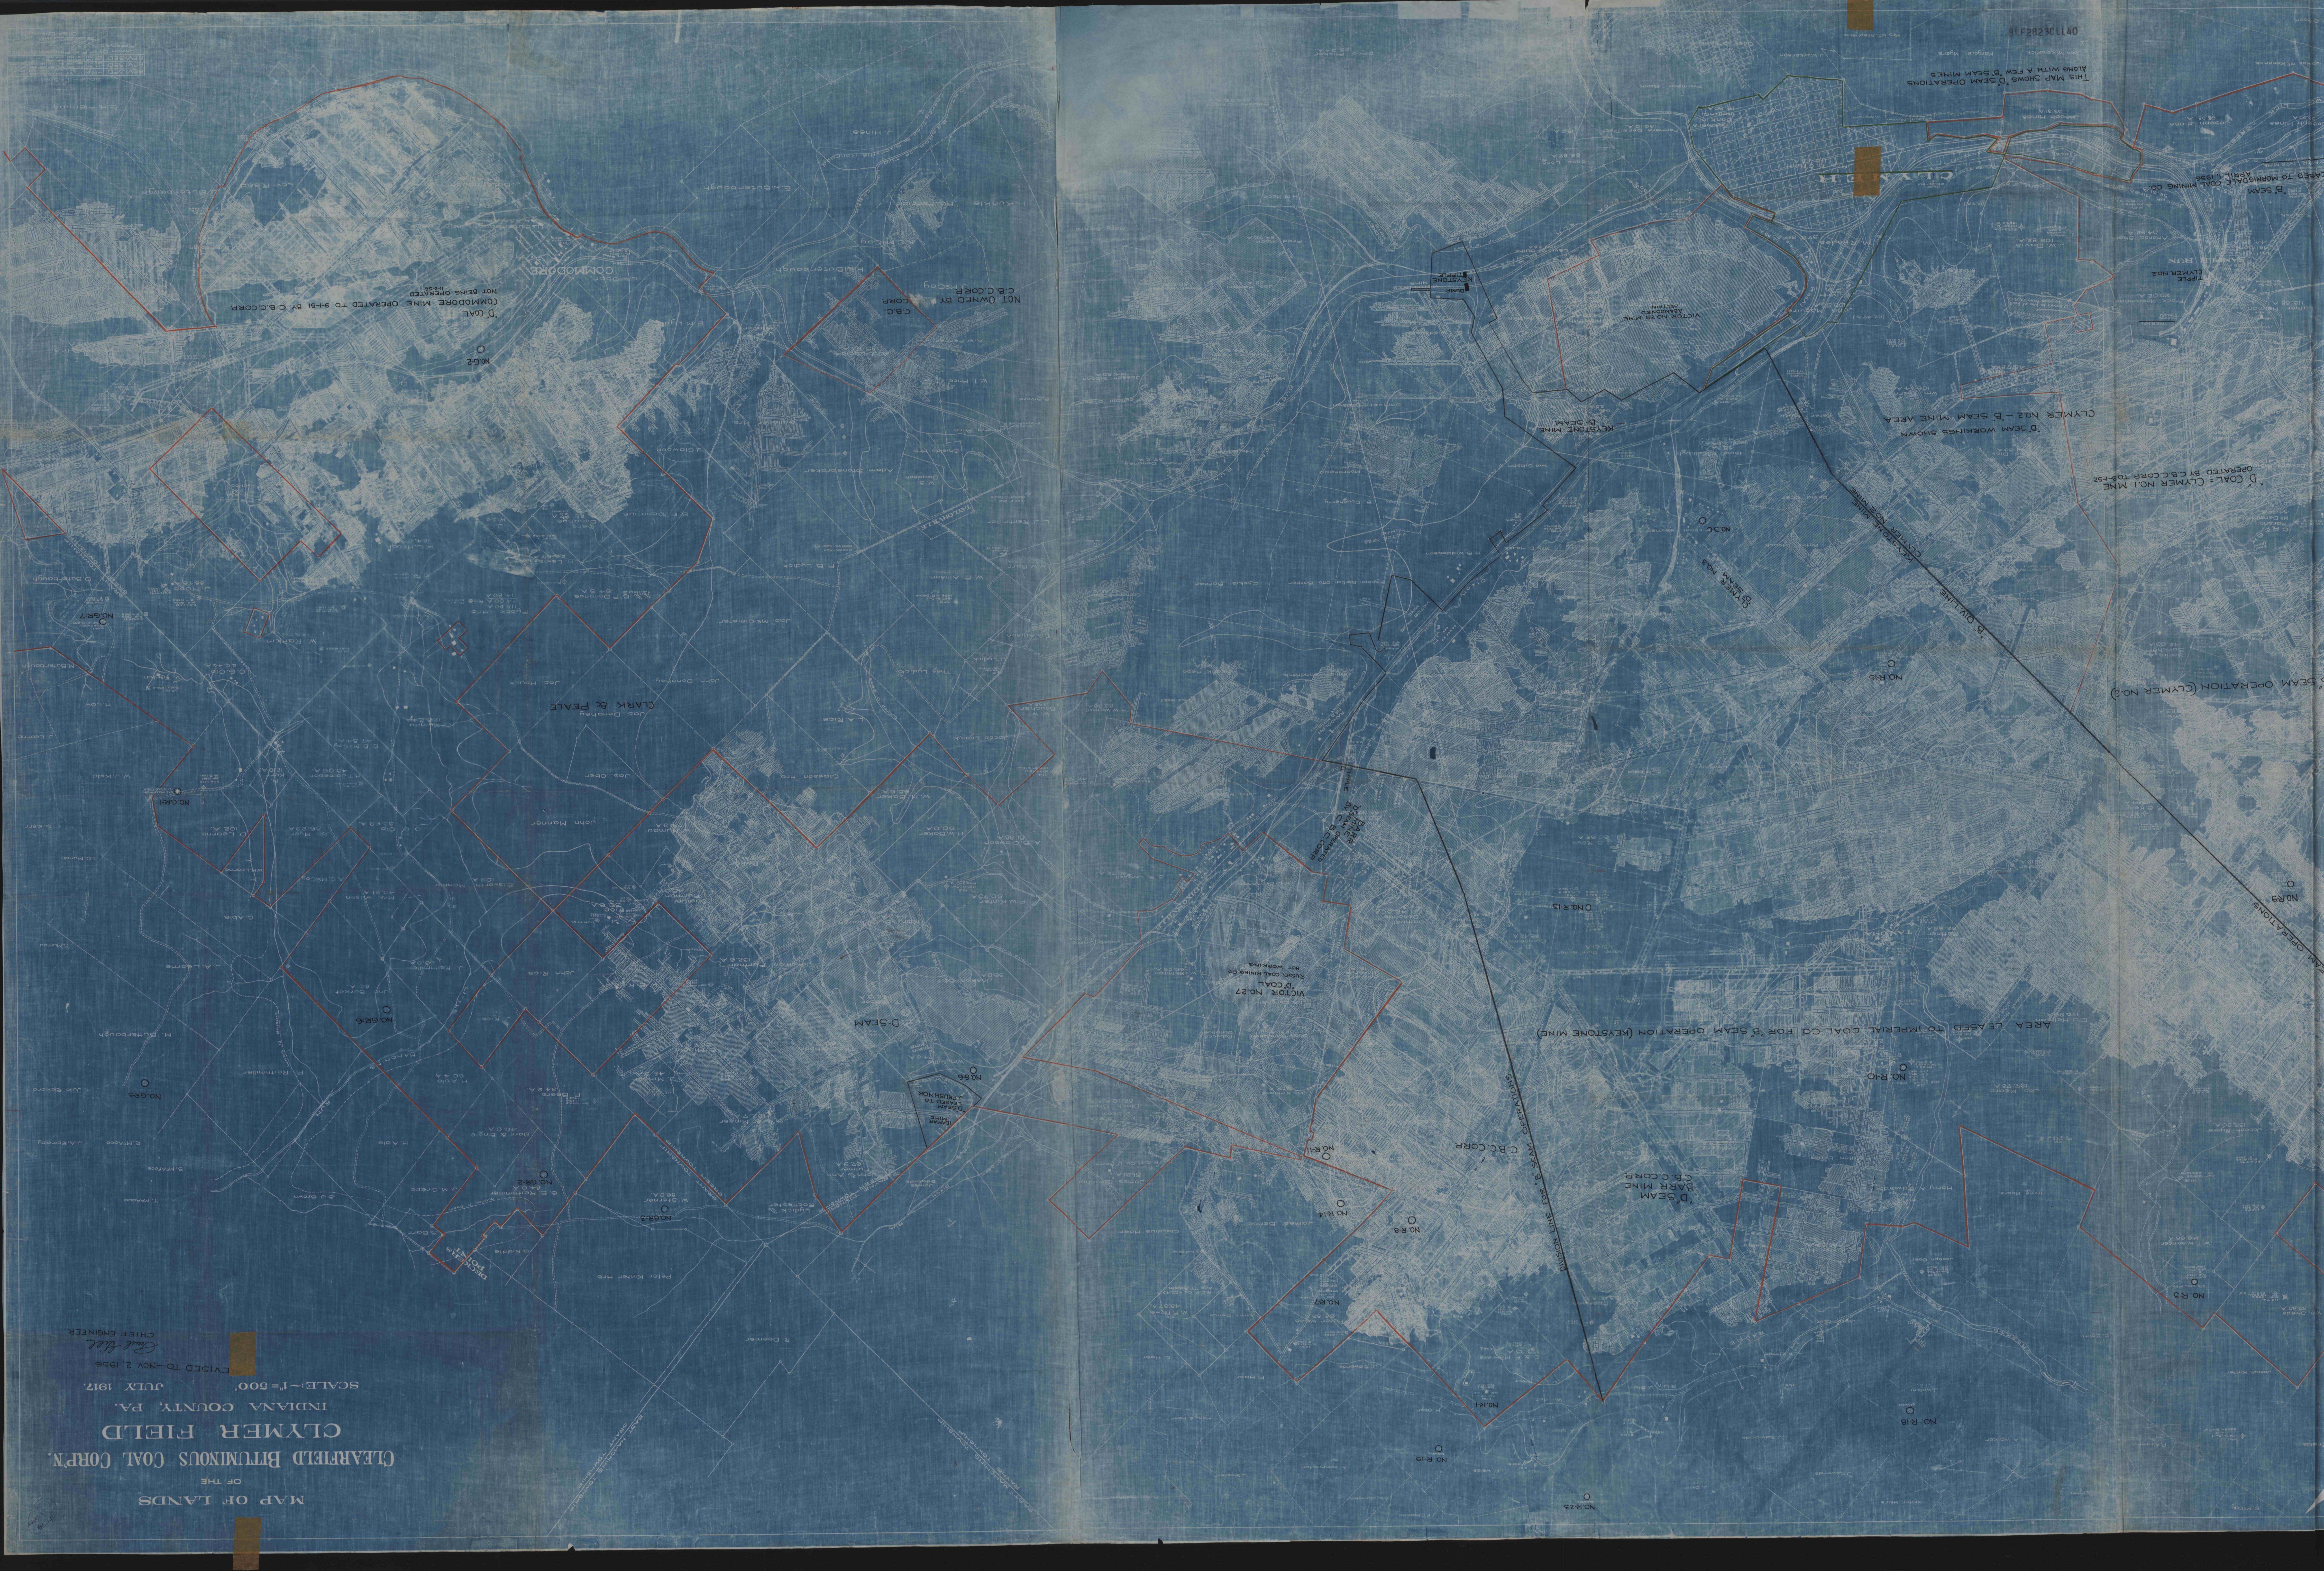

THIS MAP SHOWS 'B' SEAM OPERATIONS
ALONG WITH A FEW 'D' SEAM MINES.
LEASING TO ROBERTSON'S COAL MINING CO.
APRIL 1, 1956

'D' SEAM WORKINGS SHOWN
CLYMER NO. 2 - 'B' SEAM MINE AREA
'D' COAL - CLYMER NO. 1 MINE
OPERATED BY C.B.C. CORP. 104-152

FOR 'B' SEAM OPERATION (CLYMER NO. 2)
NO. R. 10
NO. R. 11
AREA LEASED TO IMPERIAL COAL CO. FOR 'B' SEAM OPERATION (KEYSTONE MINE)
VICTOR NO. 27
'D' COAL
PRODUCT COAL MINE CO.
NOT WORKING


